

Plat of Survey


of

Lots 109, 110, 111 & the South 1/2 of Lot 112 of Lake Delavan Highlands,


a subdivision located in the Southwest 1/4 of the Southeast 1/4 of Section 31, Town 2 North, Range 16 East, Town of Delavan, Walworth County, Wisconsin.

Surveyed for: **Keefe Real Estate, Inc.**

416 Bauer Parkway
Delavan, Wisconsin 53115

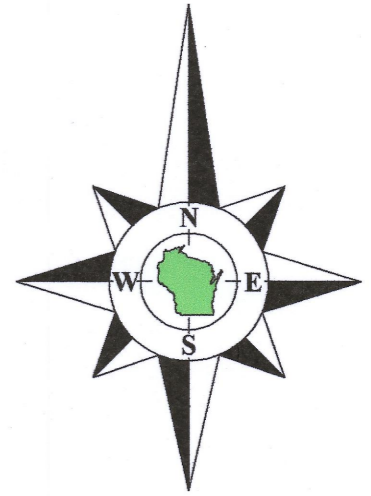

Bearings referenced to the East line of Mulberry Avenue, recorded as N0°13'40"E on the plat of Lake Delavan Highlands.

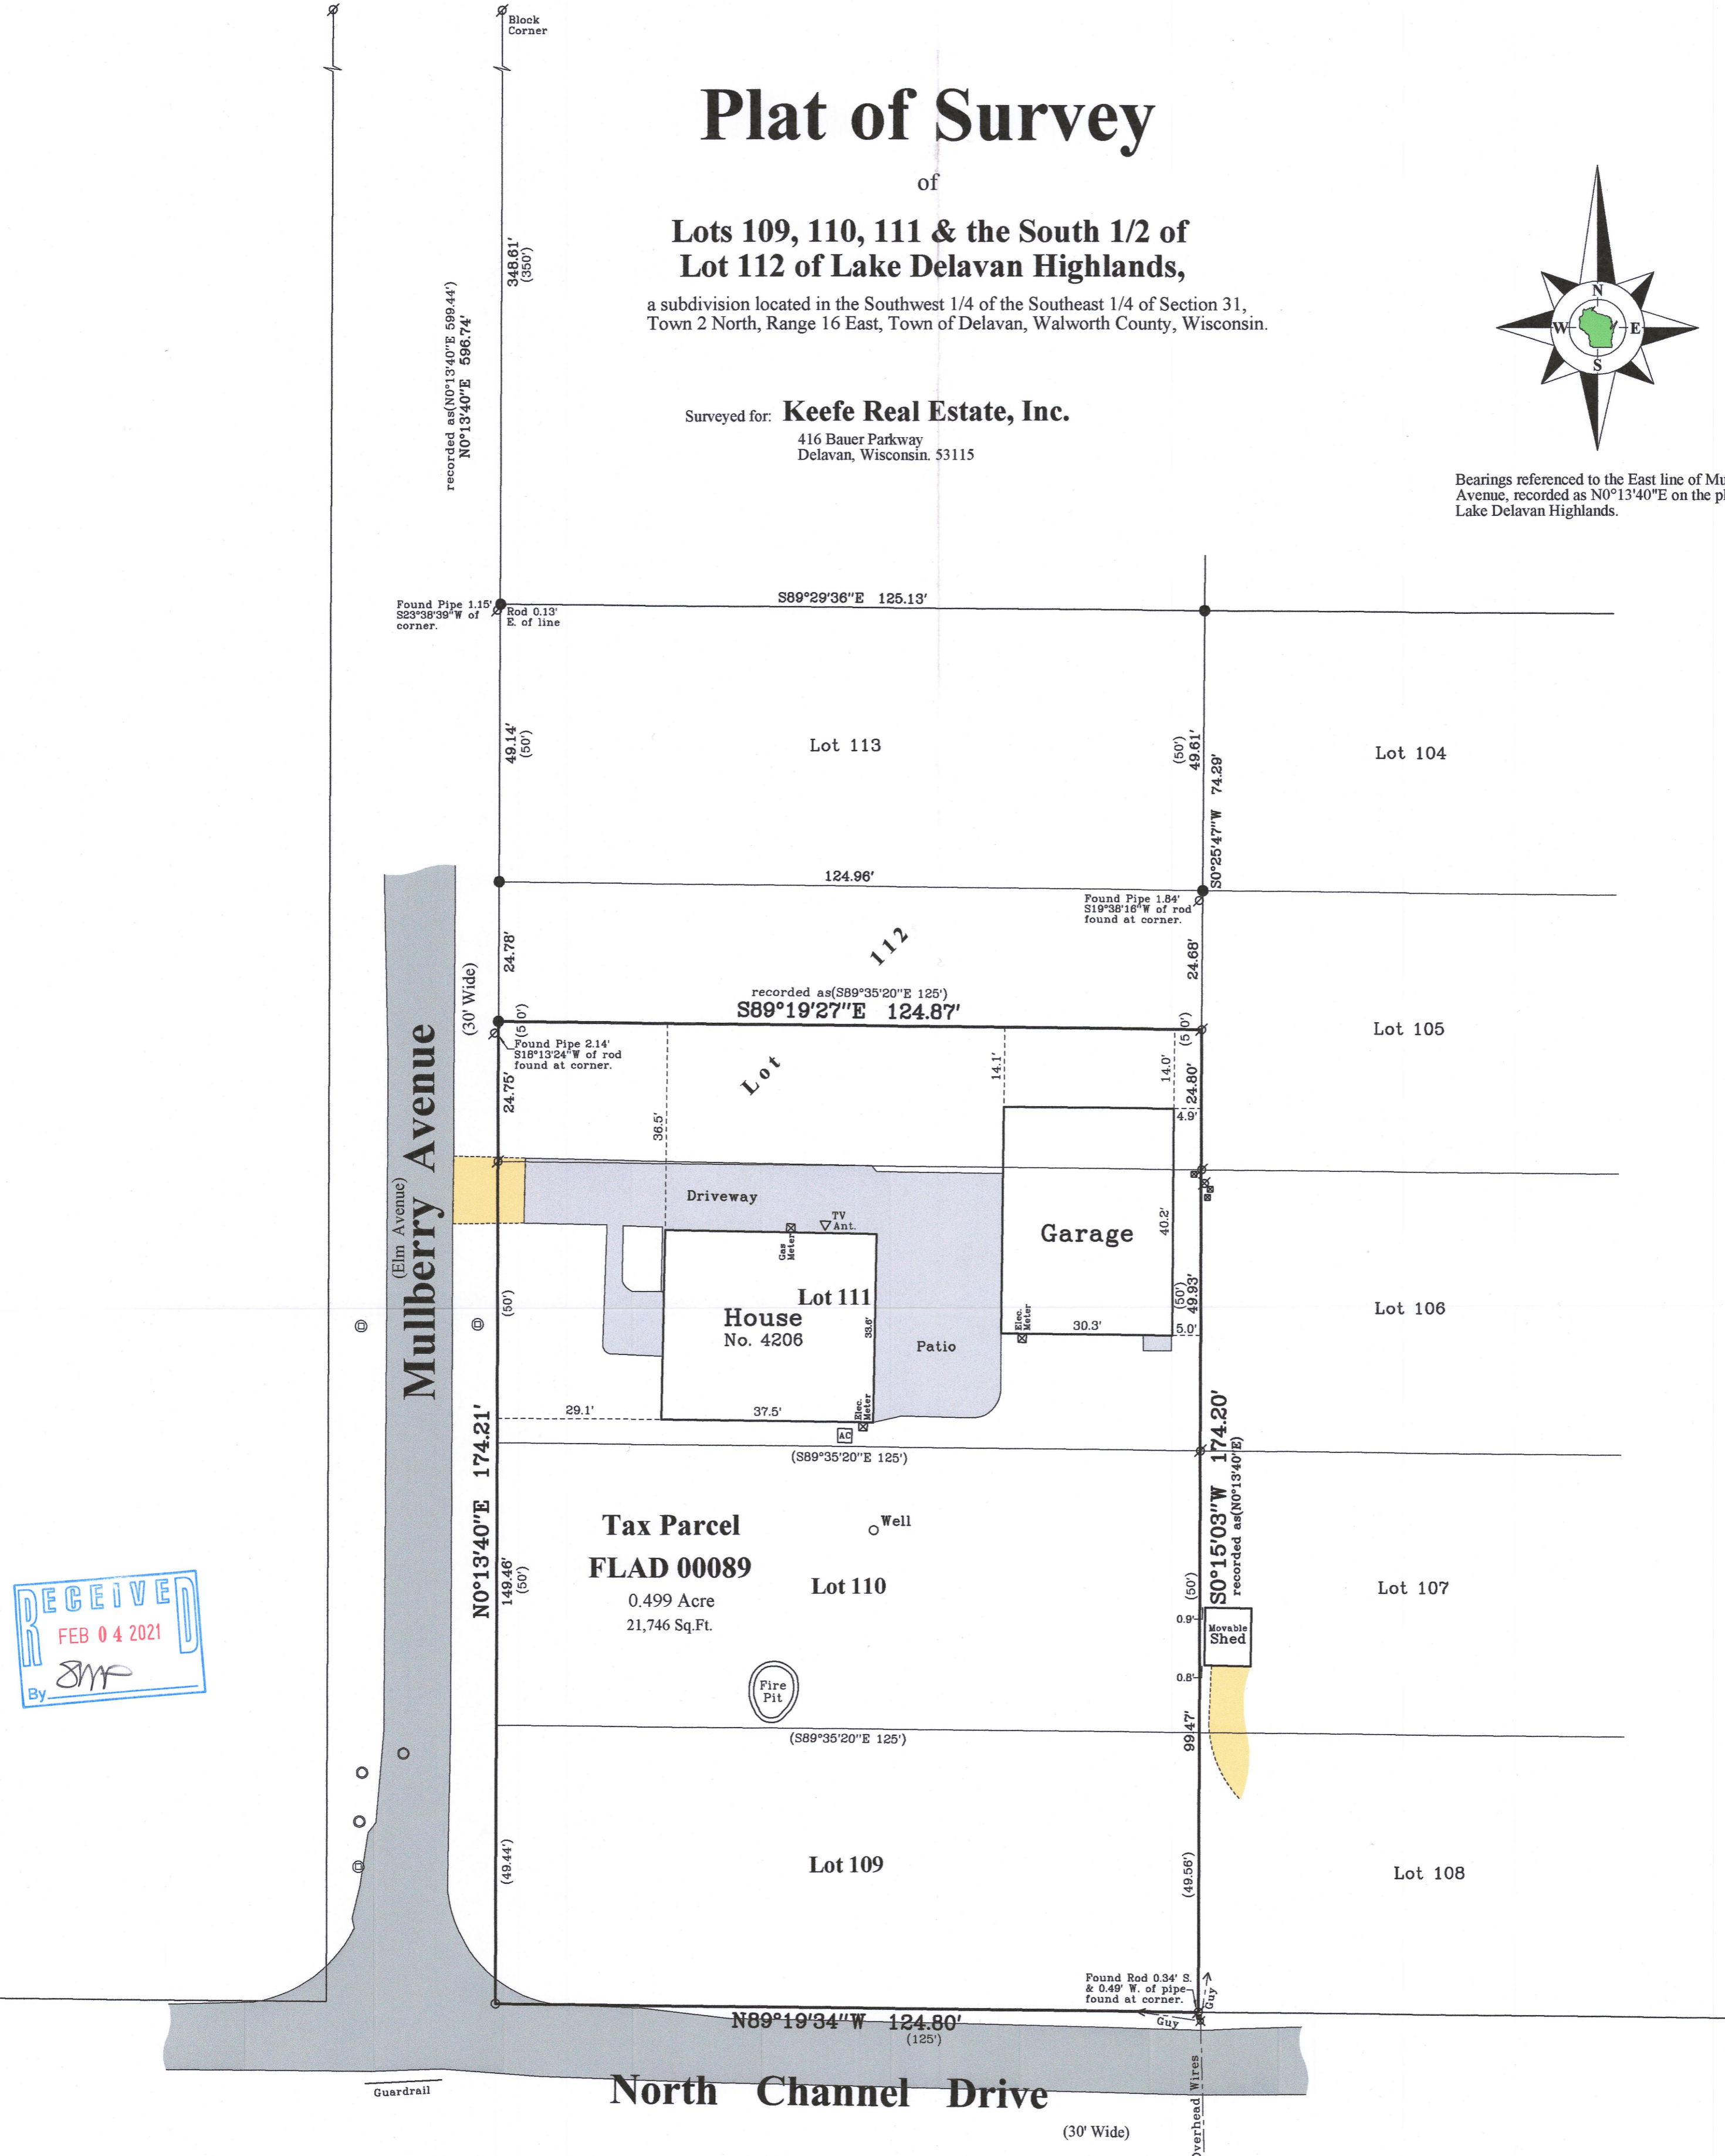

RECEIVED
FEB 04 2021
By *JMP*



- Notes:**
- This Plat of Survey is not certified unless signed and sealed in red ink.
 - This survey is subject to Wisconsin lien laws. This Plat of Survey is the notice of intent to file lien. Lien waiver required.
 - The Survey Date shown on this Plat of Survey is the completion date of the field work.

Channel

Copyright © 2020 by Olson Land Surveying, LLC.

All rights reserved. No part of this survey plat may be reproduced or transmitted in any form by any means - graphic, electronic, or mechanical, including photocopying, tracing, or information storage and retrieval systems - without permission in writing from Douglas G. Olson, Olson Land Surveying, LLC.

I hereby certify that I have surveyed the above described property in compliance with Chapter A-E 7 of the Wisconsin Administrative Code and that the map hereon is correct to the best of my professional knowledge and belief and shows the size and location of the property, its exterior boundaries, the location and dimensions of all visible structures thereon, boundary fences, apparent easements and roadways and visible encroachments, if any.

This survey is made for the exclusive use of the present owners of the property, and also those who purchase, mortgage or guarantee title thereto, within one year from the date hereof.

Douglas G. Olson
Wisconsin Professional Land Surveyor - 2093


Sheet 1 of 1 Sheets
Drawing Name:
Job Reference Number
2020.136

Legend of Symbols & Abbreviations

○ Found Iron Pipe	N North
● Found Iron Rod	S South
○ Set Iron Pipe, 1" dia.	E East
() Recorded Information	W West
○ Utility Pole	In Bearings
○ Utility Pedestal	° Degrees
○ Manhole	' Minutes
○ Catch Basin	" Seconds
○ Asphalt Surface	ft Distances
○ Concrete Surface	ft Feet
○ Gravel Surface	in Inches



45 South Wisconsin Street | P.O. Box 322
Elkhorn, Wisconsin, 53121
Telephone: (262) 723-3434
Facsimile: (262) 723-8044
Email: doug@olsonsurveying.com
Website: www.olsonsurveying.com

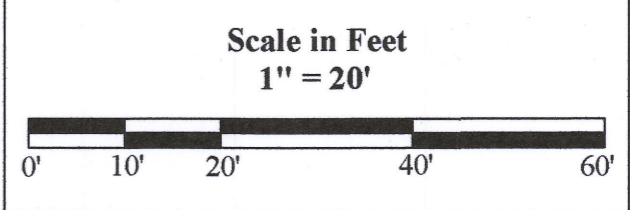

Survey Date: October 27, 2020.
Revisions:

FLAD-89

216-5789