


## DRIVE



George T. Dunham  
George T. Dunham, Surveyor

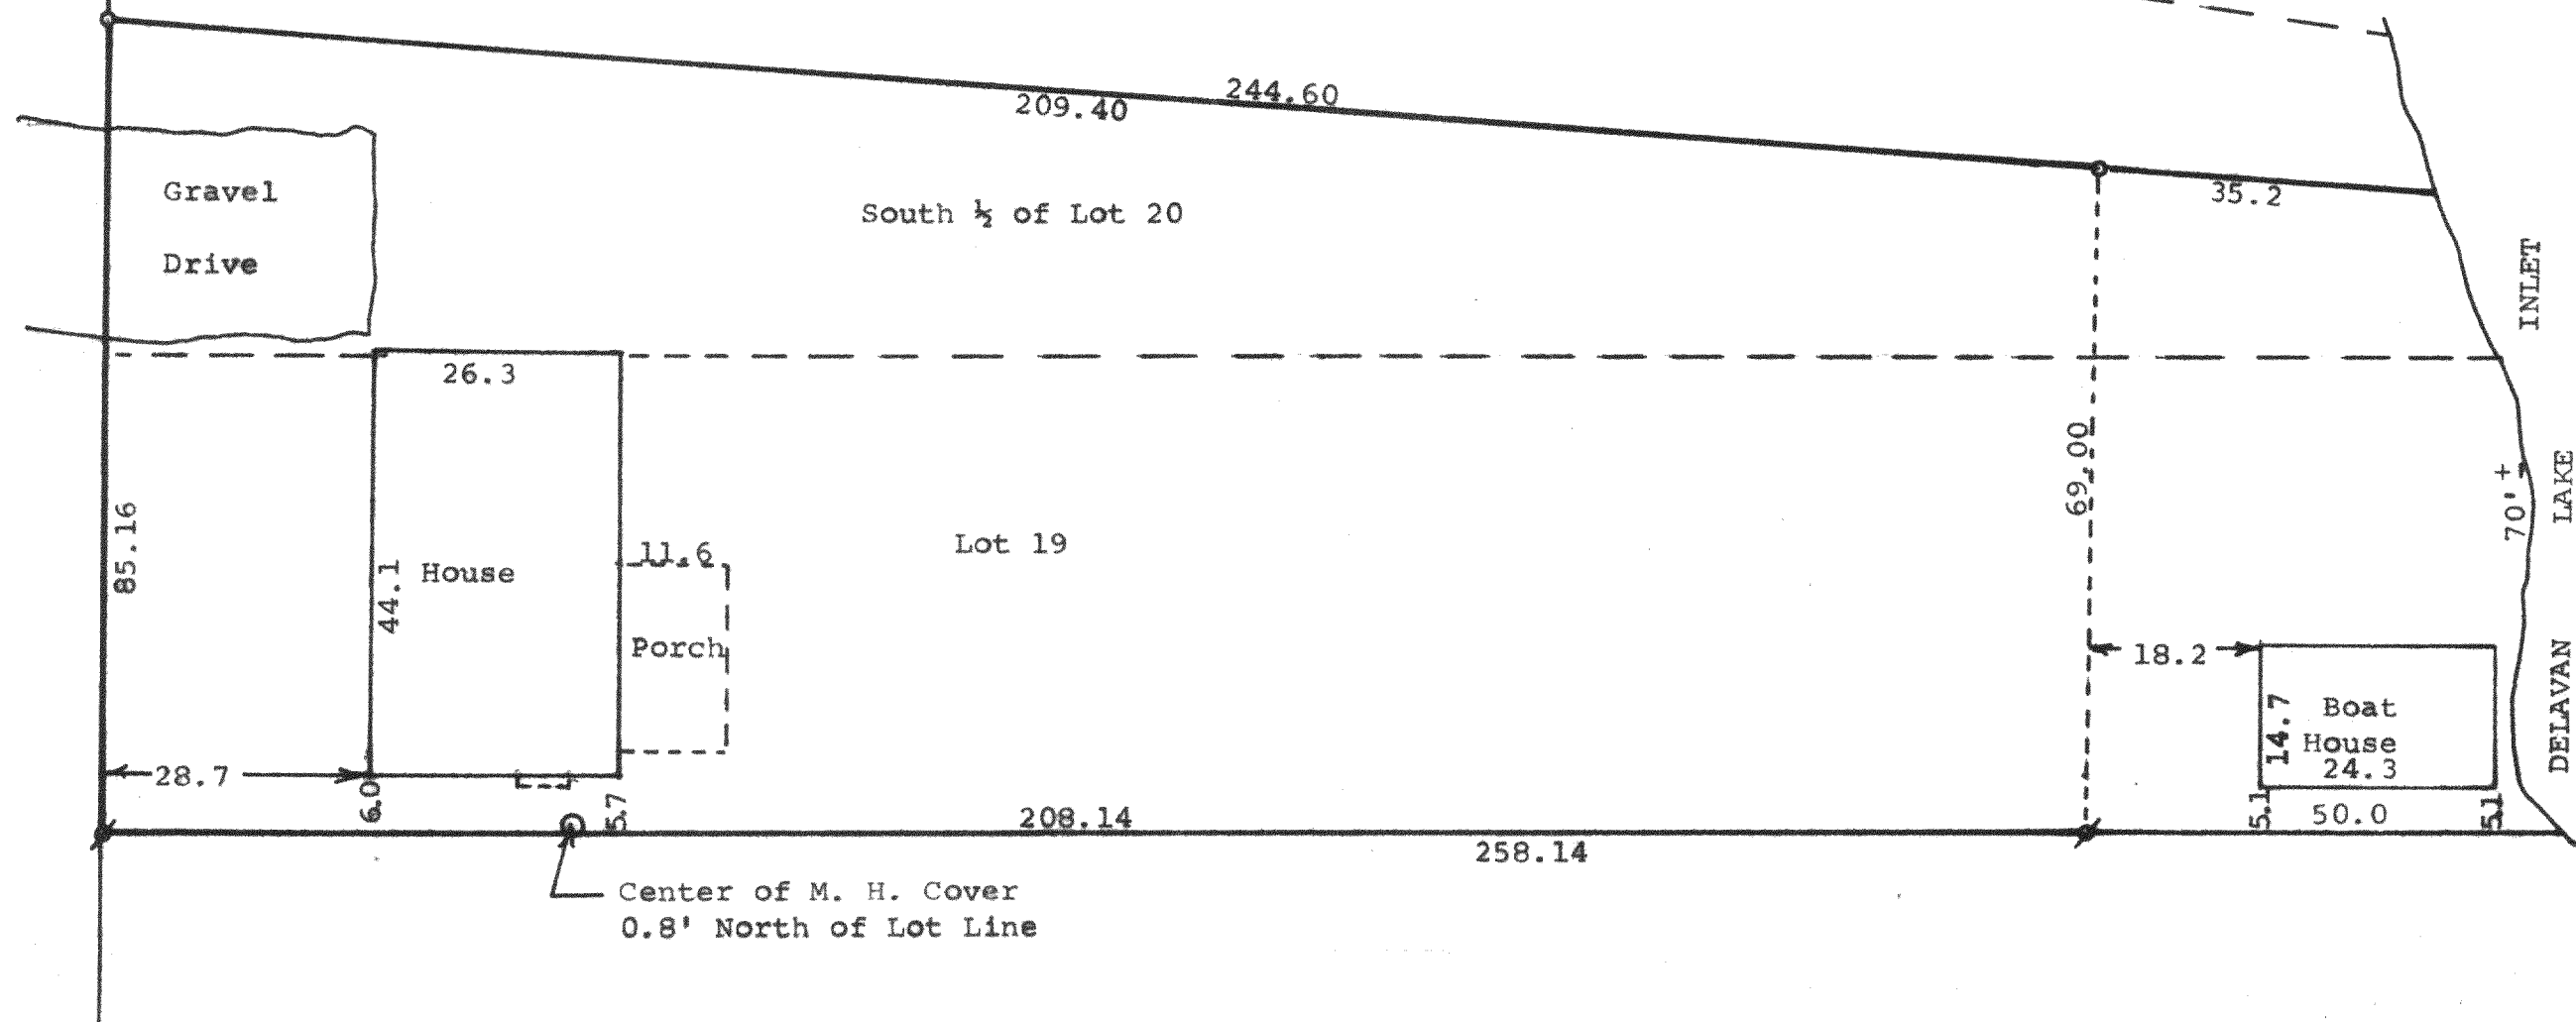