


GEORGE T. DUNHAM
SURVEYING & SUBDIVIDING
DELAVAN, WISCONSIN

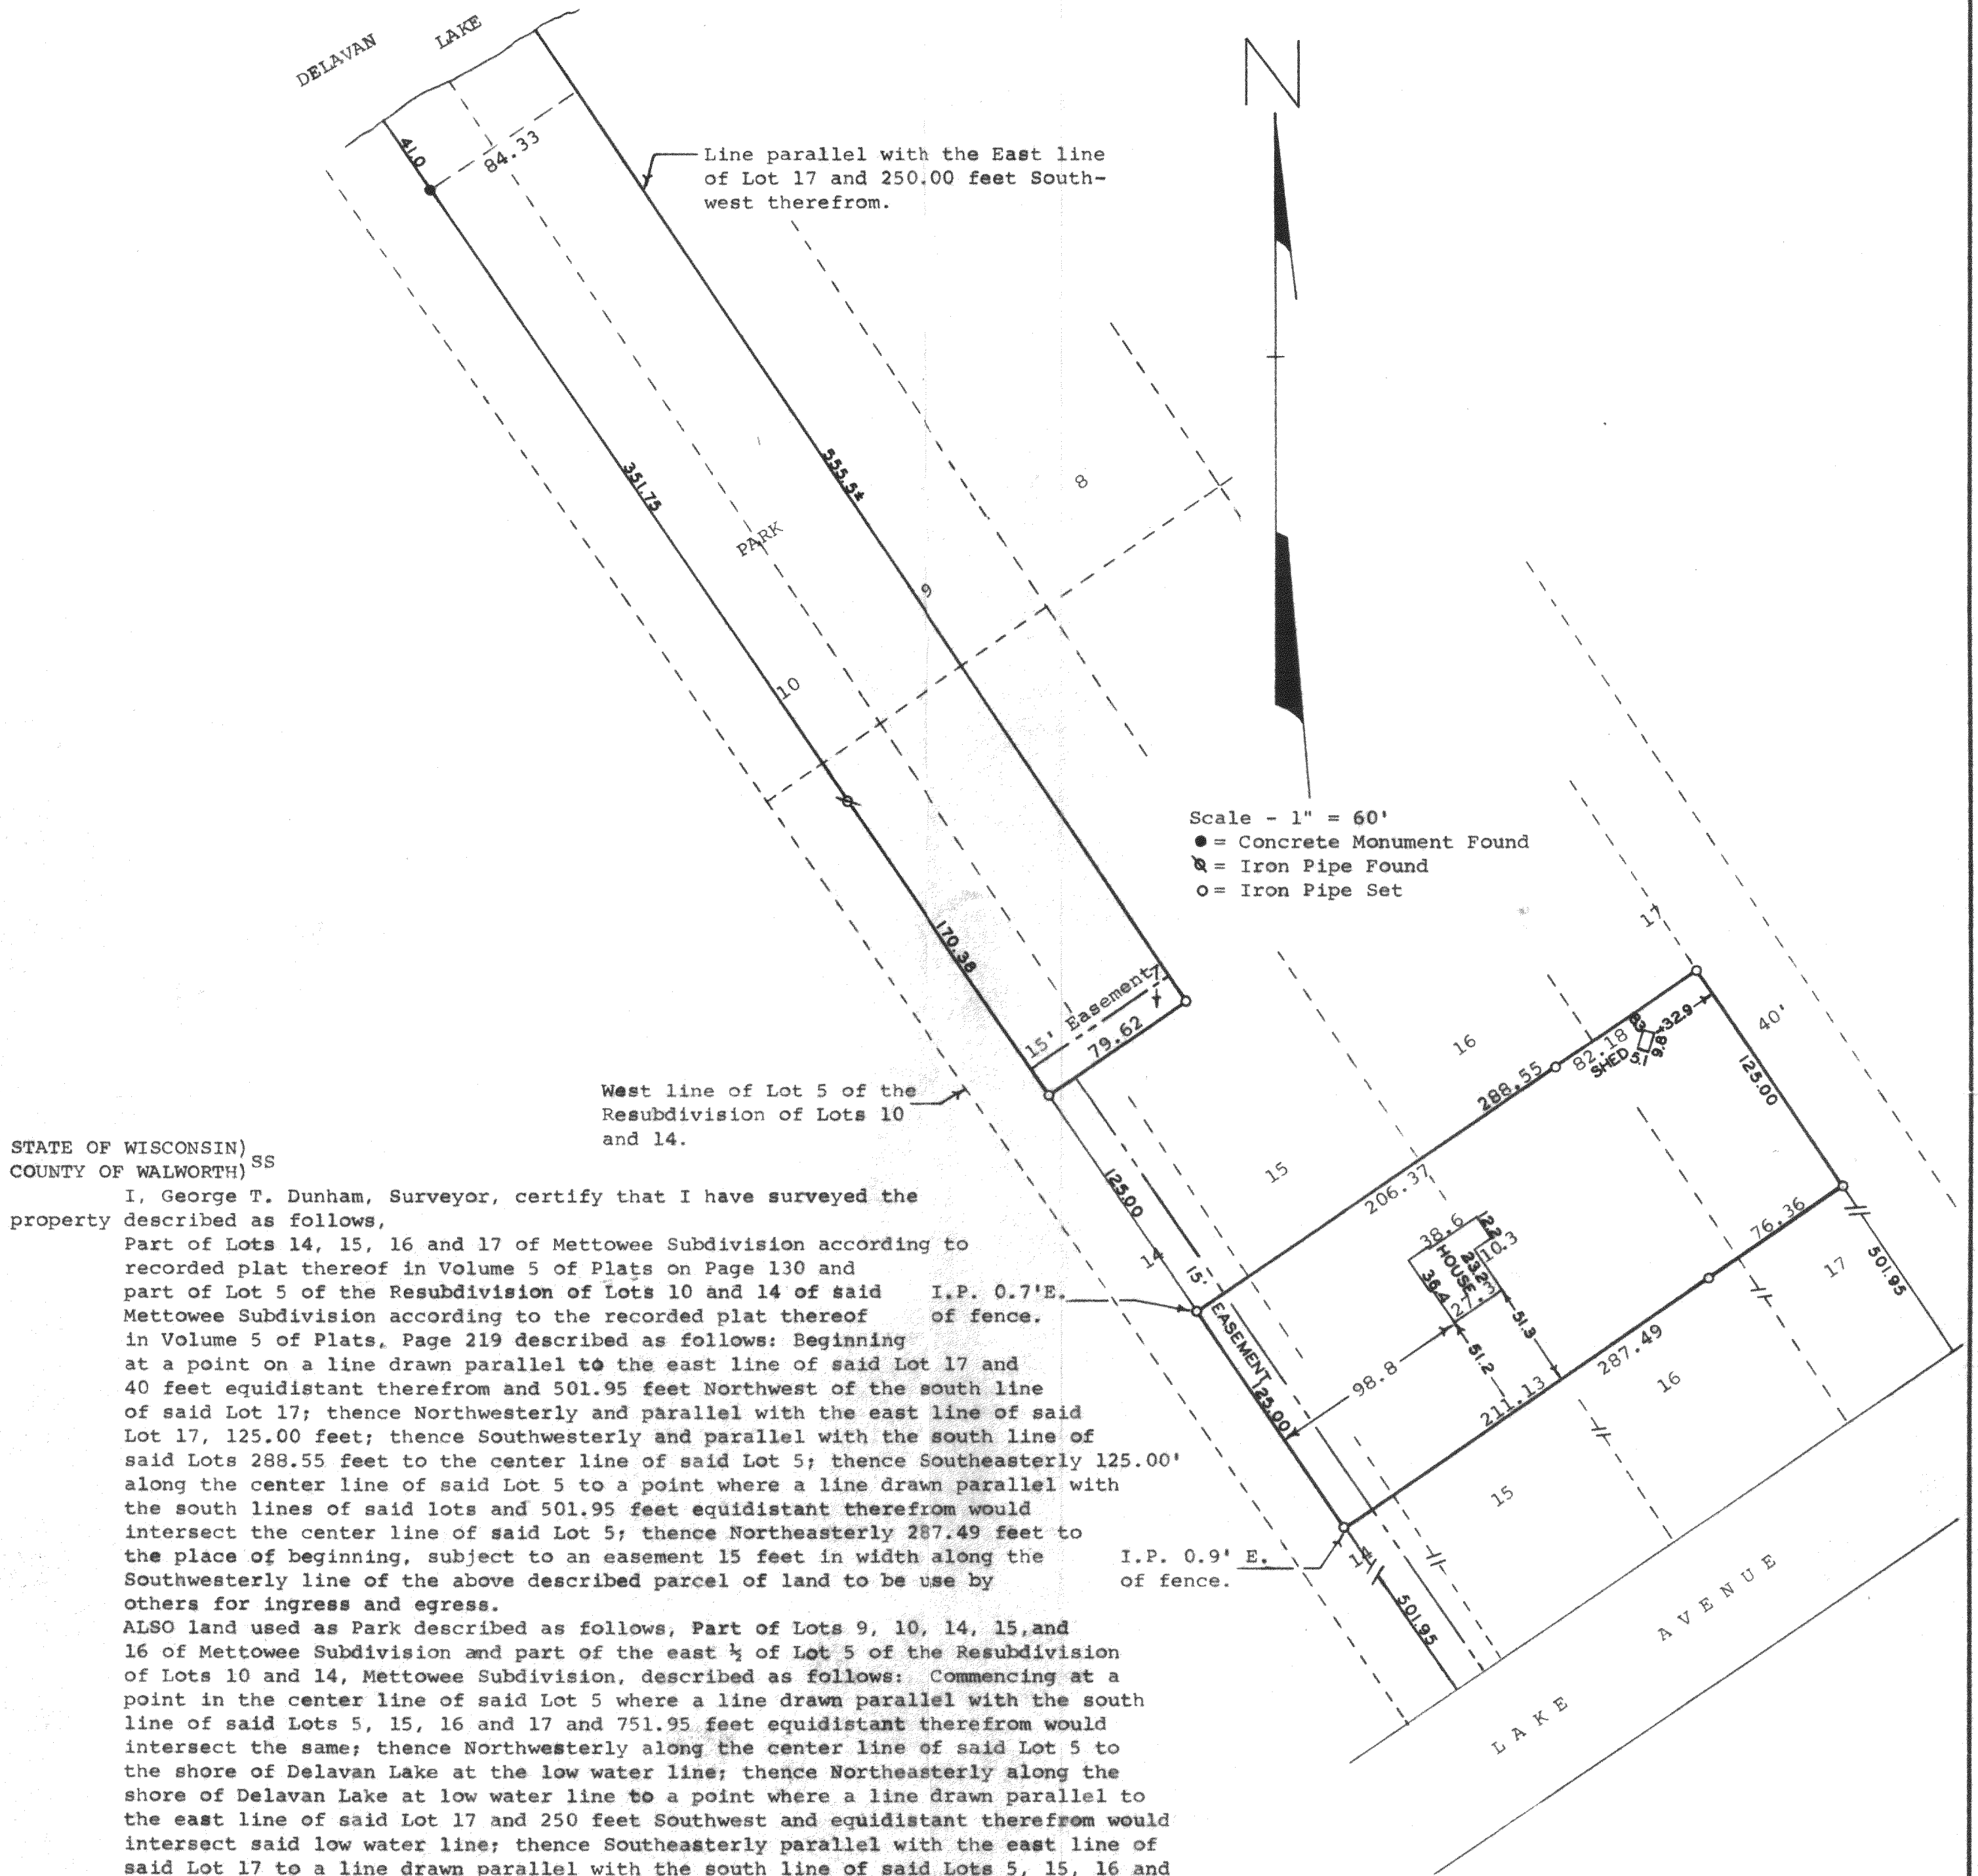

STATE OF WISCONSIN)
COUNTY OF WALWORTH) SS

I, George T. Dunham, Surveyor, certify that I have surveyed the property described as follows,

Part of Lots 14, 15, 16 and 17 of Mettowee Subdivision according to recorded plat thereof in Volume 5 of Plats on Page 130 and part of Lot 5 of the Resubdivision of Lots 10 and 14 of said Mettowee Subdivision according to the recorded plat thereof in Volume 5 of Plats, Page 219 described as follows: Beginning at a point on a line drawn parallel to the east line of said Lot 17 and 40 feet equidistant therefrom and 501.95 feet Northwest of the south line of said Lot 17; thence Northwesterly and parallel with the east line of said Lot 17, 125.00 feet; thence Southwesterly and parallel with the south line of said Lots 288.55 feet to the center line of said Lot 5; thence Southeasterly 125.00' along the center line of said Lot 5 to a point where a line drawn parallel with the south lines of said lots and 501.95 feet equidistant therefrom would intersect the center line of said Lot 5; thence Northeasterly 287.49 feet to the place of beginning, subject to an easement 15 feet in width along the Southwesterly line of the above described parcel of land to be use by others for ingress and egress.

ALSO land used as Park described as follows, Part of Lots 9, 10, 14, 15, and 16 of Mettowee Subdivision and part of the east 1/4 of Lot 5 of the Resubdivision of Lots 10 and 14, Mettowee Subdivision, described as follows: Commencing at a point in the center line of said Lot 5 where a line drawn parallel with the south line of said Lots 5, 15, 16 and 17 and 751.95 feet equidistant therefrom would intersect the same; thence Northwesterly along the center line of said Lot 5 to the shore of Delavan Lake at the low water line; thence Northeasterly along the shore of Delavan Lake at low water line to a point where a line drawn parallel to the east line of said Lot 17 and 250 feet Southwest and equidistant therefrom would intersect said low water line; thence Southeasterly parallel with the east line of said Lot 17 to a line drawn parallel with the south line of said Lots 5, 15, 16 and 17 and 751.95 feet Northwesterly and equidistant therefrom; thence Southwesterly to the place of beginning, subject to an easement 15 feet in width along the Southeasterly line of the above described parcel of land to be used by others for ingress and egress. ALSO an easement is granted to the owners of the above described parcels of land, 15 feet in width lying adjacent to and Northeasterly of the center line of Lot 5 of the Resubdivision of Lots 10 and 14 of Mettowee Subdivision, extending from the Northerly line of Lake Avenue, Northwesterly 751.95 feet to the Southeasterly line of land used as Park, and an easement 15 feet in width off the Southeasterly end of land used as Park.


All above described land is located in the Southeast Fractional 1/4 of Section 28 and the Northeast Fractional 1/4 of Section 33, T 2 N, R 16 E, Walworth County, Wisconsin.

and the above map is a true representation thereof and shows the size and location of the property, its exterior boundaries, the location and dimensions of all structures thereon, fences, apparent easements and roadways and visible encroachments, if any.

This survey is made for the exclusive use of the present owners of the property, and also those who purchase, mortgage, or guarantee the title thereto within one (1) year from date hereof; and as to them I warrant the accuracy of said survey and map.

October 4, 1976

George T. Dunham
George T. Dunham, Surveyor

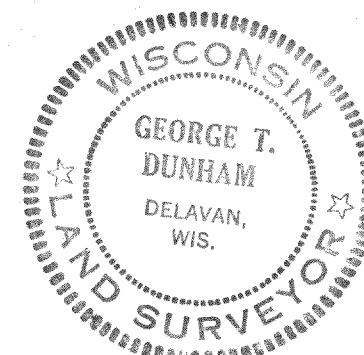

FMT-6B
↓
Park
FMT-6E

216-575