


DUNHAM SURVEYING, S.C.
SURVEYING & SUBDIVIDING
DELAVER, WISCONSIN 53115




Scale - 1" = 20'
o = Iron Pipe Set
Ø = Iron Pipe Found

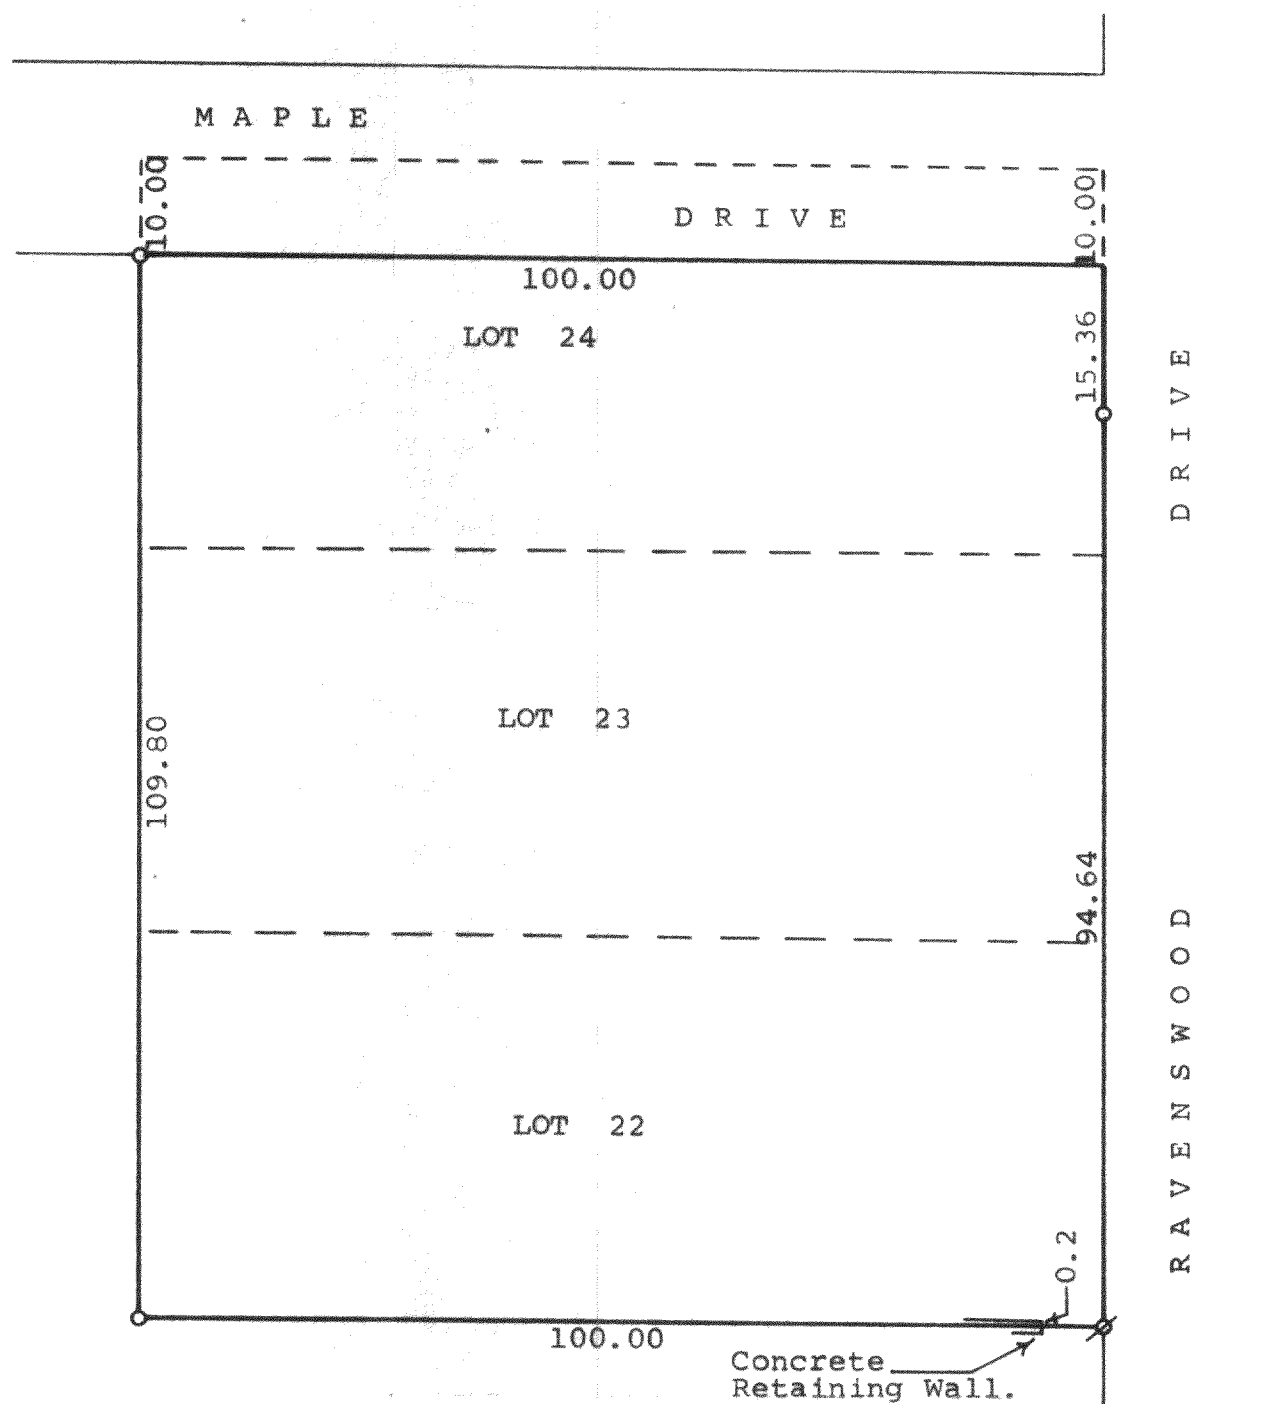

STATE OF WISCONSIN)
COUNTY OF WALWORTH) SS

I, George T. Dunham, Surveyor, certify that I have surveyed the property described as follows,
Lots 22, 23, and 24, excepting therefrom the North 10.00 feet of said Lot 24 in Ravenswood Subdivision, a subdivision located in Section 31, T 2 N, R 16 E, Walworth County, Wisconsin, and the above map is a true representation thereof and shows the size and location of the property, its exterior boundaries, the location and dimensions of all structures thereon, fences, apparent easements and roadways and visible encroachments, if any.
This survey is made for the exclusive use of the present owners of the property, and also those who purchase, mortgage, or guarantee the title thereto within one (1) year from date hereof; and as to them I warrant the accuracy of said survey and map.
December 22, 1976

George T. Dunham
George T. Dunham, Surveyor

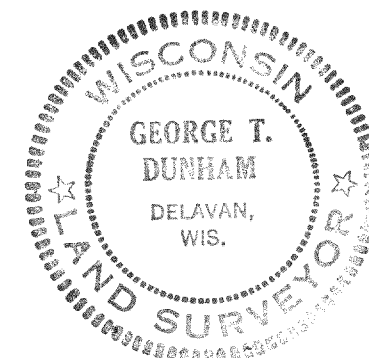

FR-13

216-578