
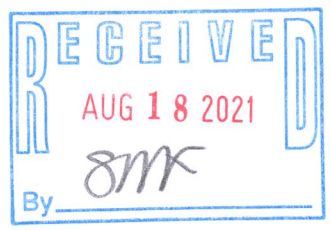
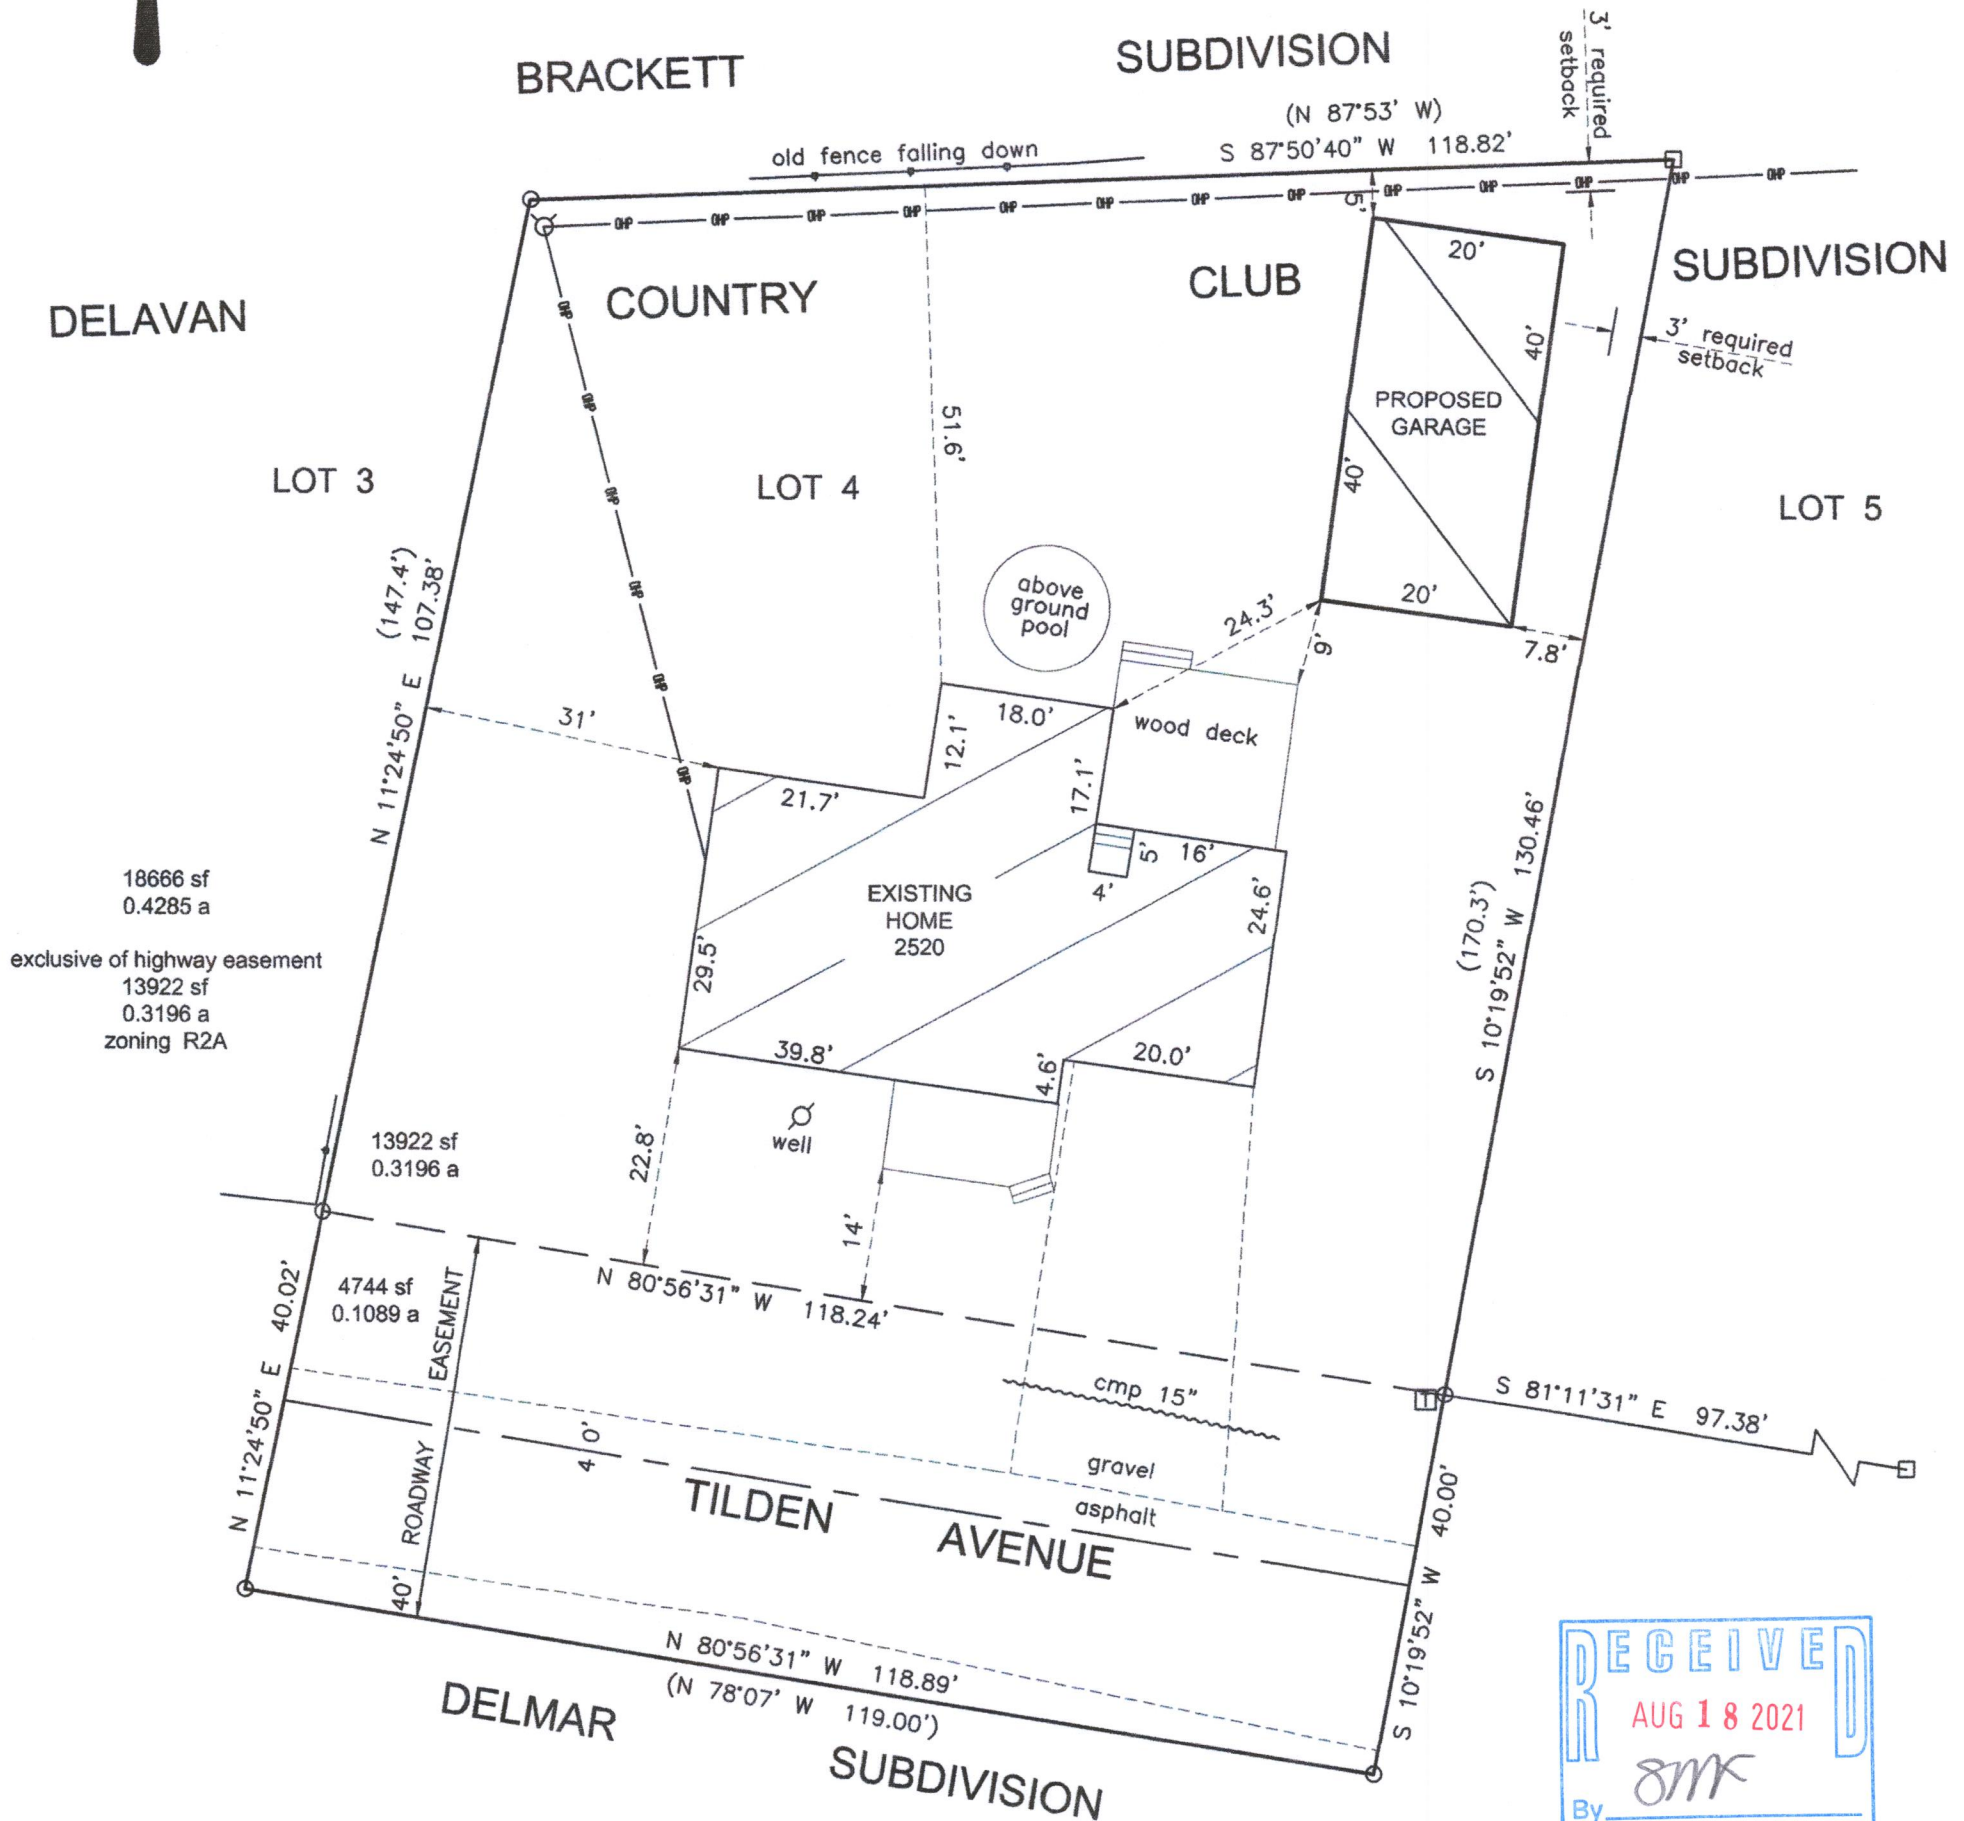


# PLAT OF SURVEY

- OF -

PREPARED FOR:  
 TRINITY CONSTRUCTION  
 FOR TYLER GREEN

Lot 4 in Delavan Country Club Subdivision situated in Section 27, Township 2 North, Range 16 East being in the Township of Delavan, Walworth County, Wisconsin.

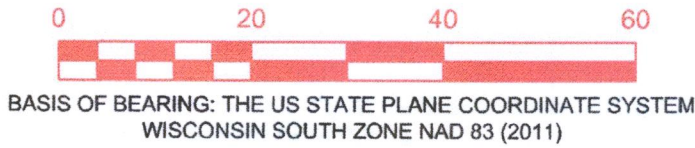

- (XXX) = RECORDED AS
- = FOUND IRON PIPE
- = FOUND IRON BAR
- ⊞ = COMMUNICATIONS PEDESTAL
- ⊙ = UTILITY POLE
- OP— = OVERHEAD UTILITY LINES

I HEREBY CERTIFY THAT I HAVE SURVEYED THE ABOVE DESCRIBED PROPERTY AND THE ABOVE MAP IS A TRUE REPRESENTATION THEREOF AND SHOWS THE SIZE AND LOCATION OF THE PROPERTY, ITS EXTERIOR BOUNDARIES, THE LOCATION AND DIMENSIONS OF ALL STRUCTURES THEREON, FENCES, APPARENT EASEMENTS, ROADWAYS, AND VISIBLE ENCROACHMENTS, IF ANY.

THIS SURVEY IS MADE FOR THE PRESENT OWNERS OF THE PROPERTY, AND THOSE WHO PURCHASE, MORTGAGE, OR GUARANTEE THE TITLE THERETO WITHIN ONE YEAR FROM THIS DATE HEREOF.

DATED THIS 12TH DAY OF AUGUST 2021



*Steven L. Schmidt*  
 STEVEN L. SCHMIDT S - 2813  
 Wisconsin Professional Land Surveyor

SCALE 1" = 20'  
 JOB NO. 2021-027  
 TAX ID # FDCC 00002A

216-5815