
FARRIS, HANSEN & ASSOCIATES, INC.

ENGINEERING - ARCHITECTURE - SURVEYING 7 RIDGWAY COURT - P.O. BOX 437 - ELKHORN, WISCONSIN PHONE: (262) 723-2098 FAX: (262) 723-5886

PLAT OF SURVEY - ASBUILT

PART OF LOT 29 & LOT 30 OF BLOCK 17 OF DELAVAN LAKE VIEW CREST - WORK ORDERED BY -LOCATED IN PART OF THE NW 1/4 OF THE NE 1/4 OF SECTION 31, TOWN 2 NORTH, RANGE 16 EAST,

4306 HIGHLAND DRIVE DELAVAN, WI 53115

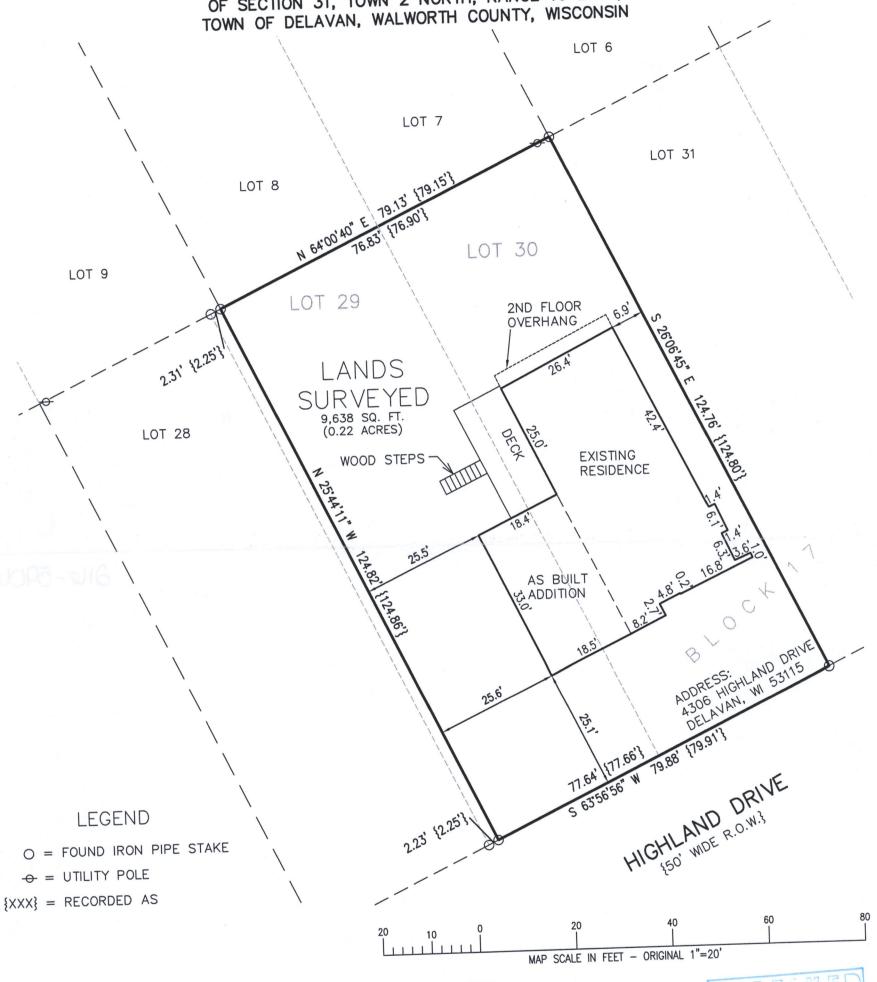

NOTE: COPIES OF THIS MAP TO WHICH THE FOLLOWING CERTIFICATE WILL APPLY SHOW THE SURVEYOR'S ORIGINAL SEAL AND SIGNATURE IN RED INK. COPIES BY ANY OTHER MEANS MAY HAVE ALTERATIONS WHICH DO NOT REPRESENT THE SURVEYOR'S WORK PRODUCT.

I HEREBY CERTIFY THAT THE ABOVE DESCRIBED PROPERTY HAS BEEN SURVEYED UNDER MY DIRECTION AND THAT THE ABOVE MAP IS A TRUE REPRESENTATION THEREOF AND SHOWS THE SIZE AND LOCATION OF THE PROPERTY AND ITS EXTERIOR BOUNDARIES. THIS SURVEY IS MADE FOR THE USE OF THE PRESENT OWNERS OF THE PROPERTY, AND ALSO THOSE WHO PURCHASE, MORTGAGE, OR GUARANTEE THE TITLE THERETO WITHIN ONE YEAR FROM THE DATE HEREOF.

DATED: _

01/18/2022

REVISED 01/18/2022 TO SHOW ADDITION AS BUILT.

PROJECT: 10075 DATE: 02/05/2019 SHEET 1 OF 1

WILLIAM CON O'M

2760 PALMYRA

P.L.S. 2760 CHRISTOPHER A. HODGES

FDLV-142

216-5906