
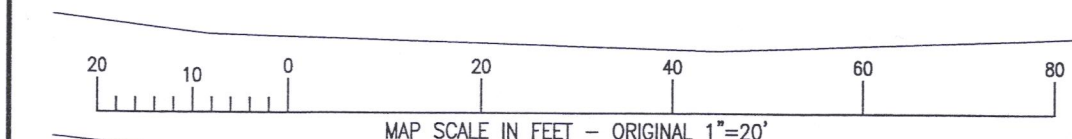
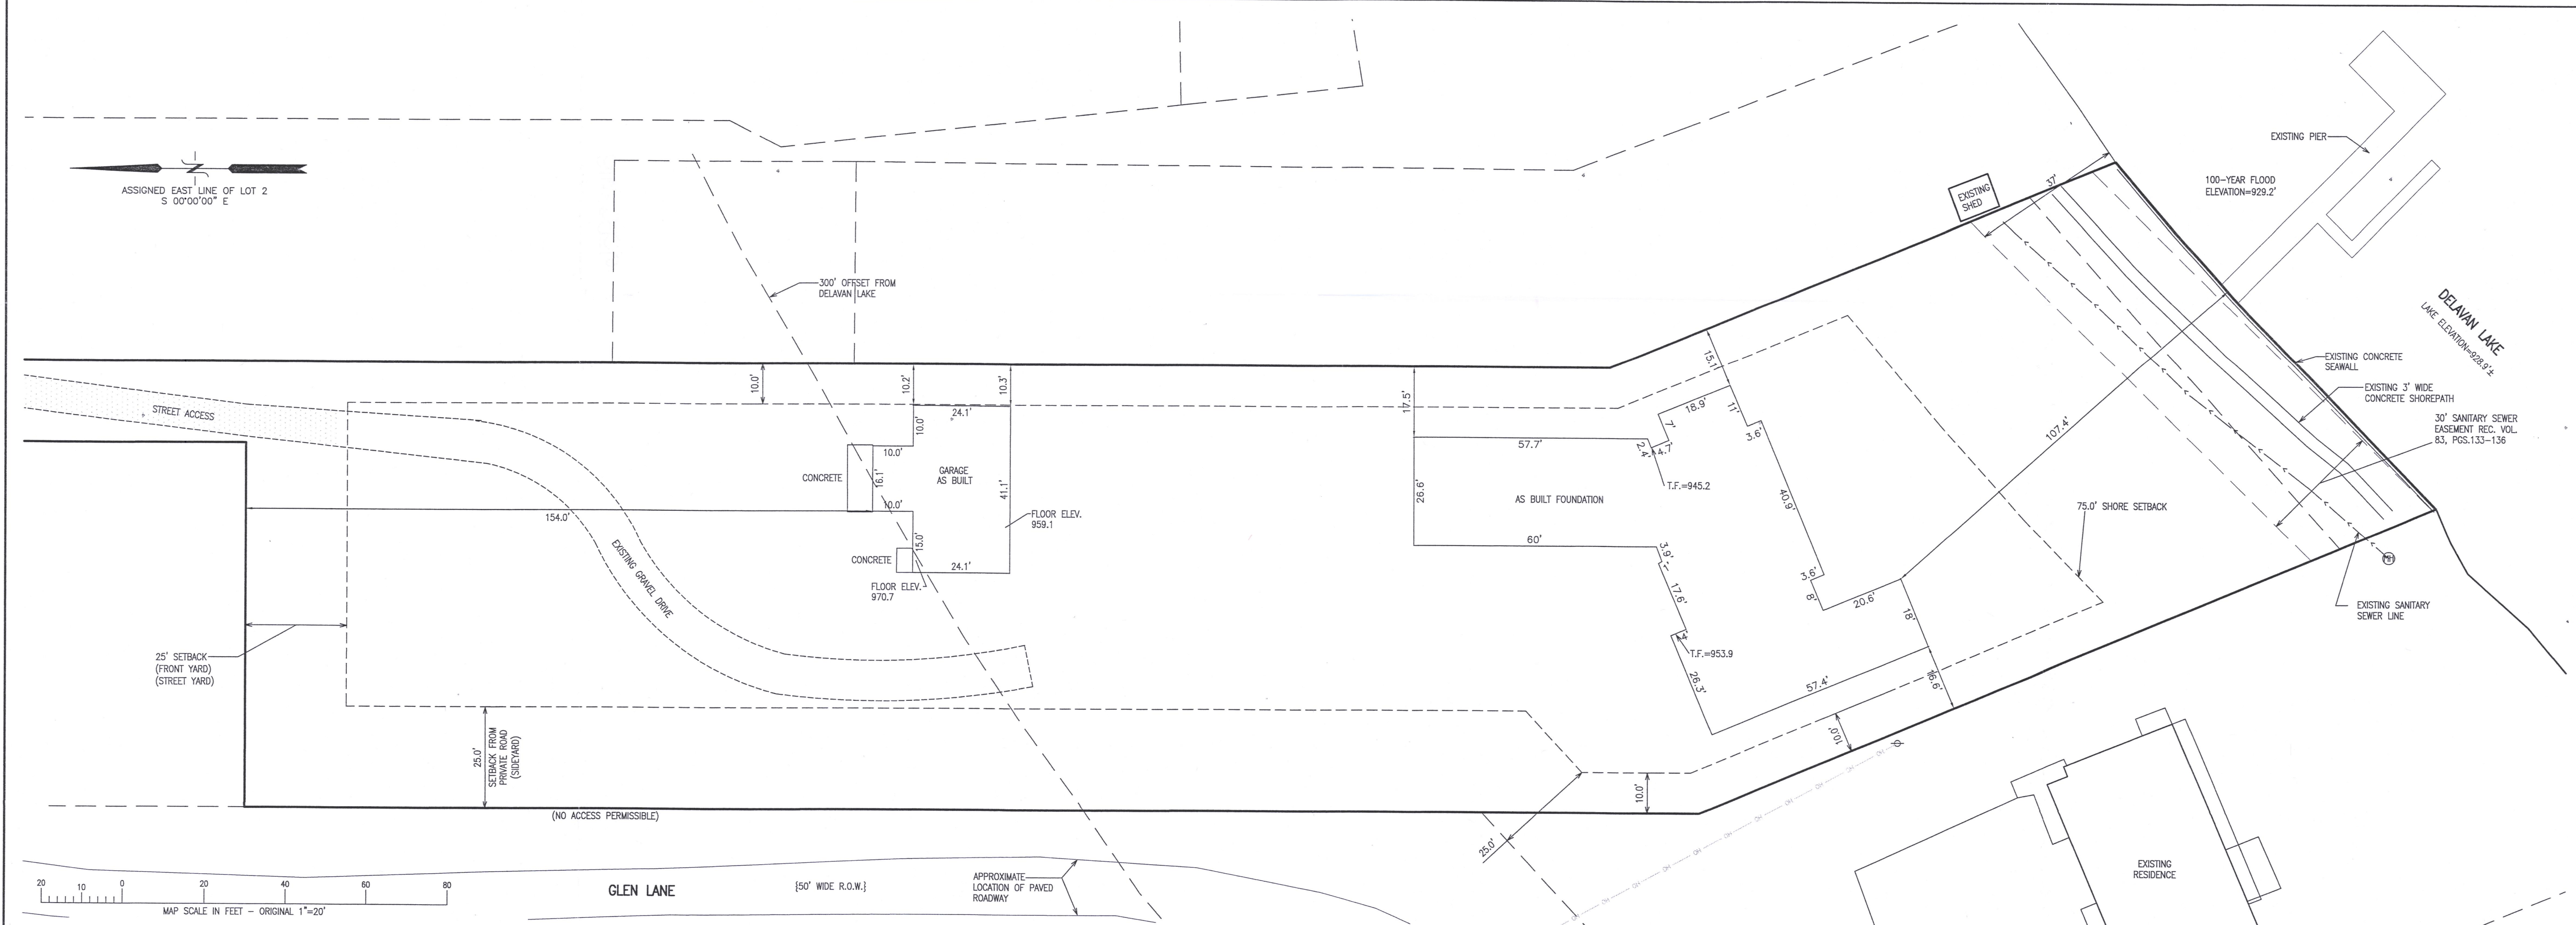
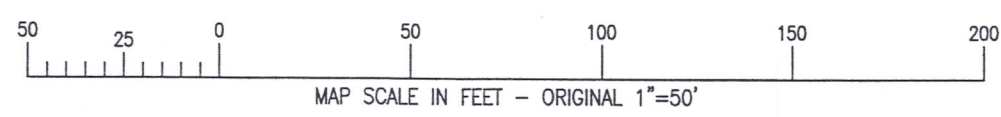


PLAT OF SURVEY
LOT 2 OF GLEN EYRIE SUBDIVISION

LOCATED IN PART OF THE NW 1/4 OF THE SW 1/4
OF SECTION 28, TOWN 2 NORTH, RANGE 16 EAST,
TOWN OF DELAVAN, WALWORTH COUNTY, WISCONSIN

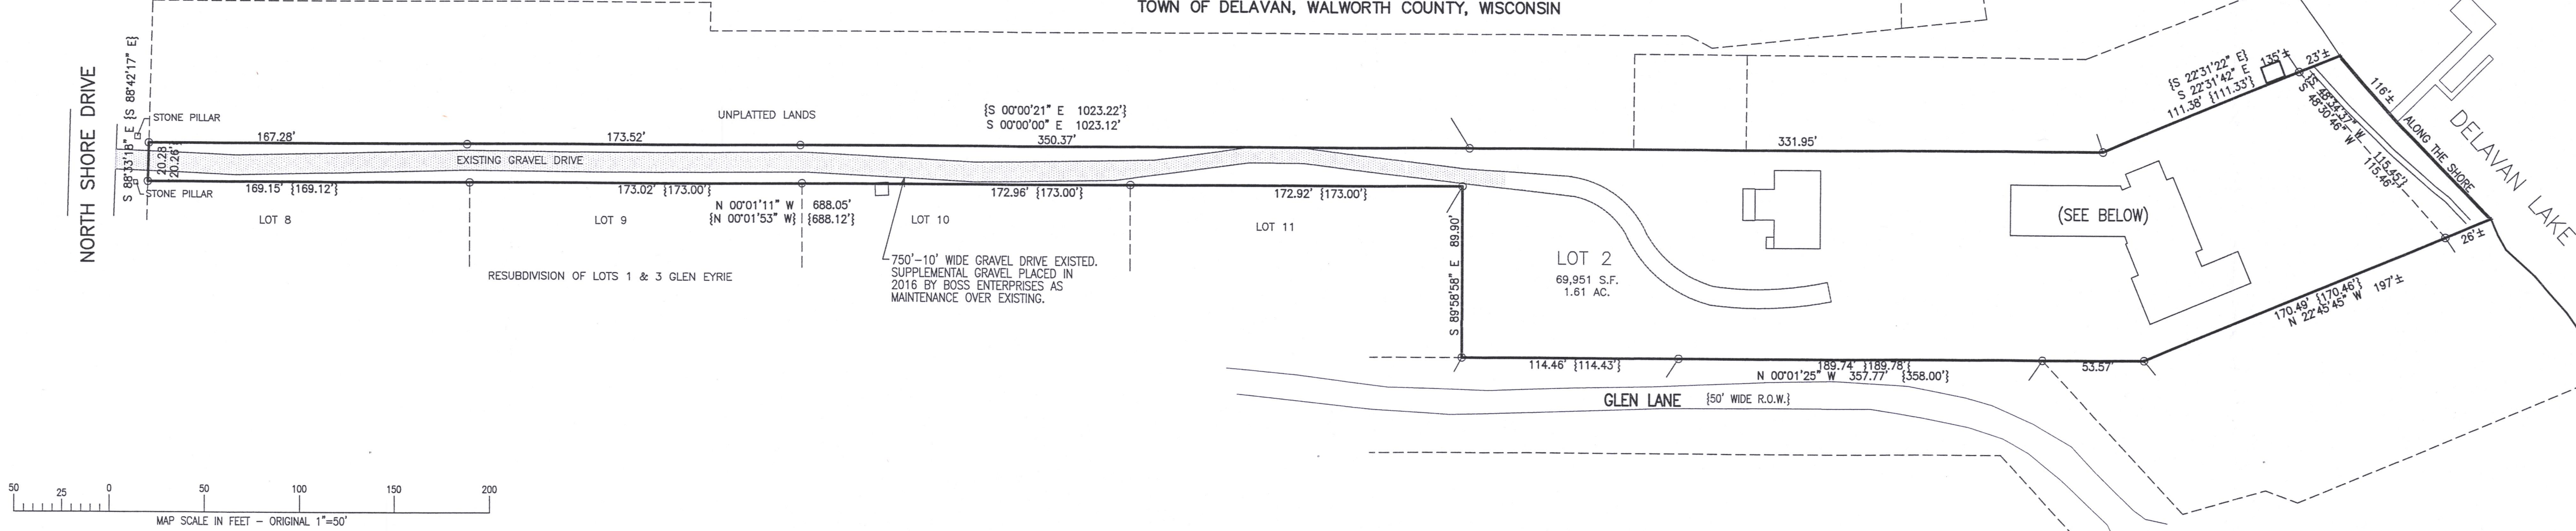

LEGEND


- = FOUND IRON PIPE
- T.F. = TOP OF FOUNDATION
- {xxx} = RECORDED AS

NOTE: COPIES OF THIS MAP TO WHICH THE FOLLOWING CERTIFICATE WILL APPLY SHOW THE SURVEYOR'S ORIGINAL SEAL AND SIGNATURE IN RED INK. COPIES BY ANY OTHER MEANS MAY HAVE ALTERATIONS WHICH DO NOT REPRESENT THE SURVEYOR'S WORK PRODUCT.

I HEREBY CERTIFY THAT THE ABOVE DESCRIBED PROPERTY HAS BEEN SURVEYED UNDER MY DIRECTION AND THAT THE ABOVE MAP IS A TRUE REPRESENTATION THEREOF AND SHOWS THE SIZE AND LOCATION OF THE PROPERTY AND ITS EXTERIOR BOUNDARIES. THIS SURVEY IS MADE FOR THE USE OF THE PRESENT OWNERS OF THE PROPERTY, AND ALSO THOSE WHO PURCHASE, MORTGAGE, OR GUARANTEE THE TITLE THERETO WITHIN ONE YEAR FROM THE DATE HEREOF.

DATED: 9/15/2022
CHRISTOPHER A. HODGES P.L.S. 2760

REVISED 07/09/2018 TO SHOW SIZE AND LOCATION OF AS BUILT FOUNDATION (RESIDENCE)
9/15/2022 - REVISED A PLAT OF SURVEY PREPARED BY BRIAN M. CARLSON DATED 07/09/2018 TO SHOW SIZE AND LOCATION OF GARAGE AS BUILT

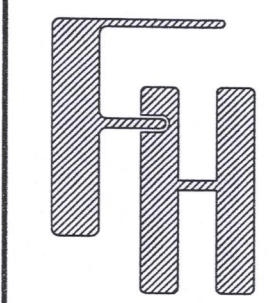

PLAT OF SURVEY
HUBERTZ RESIDENCE
2588 NORTH SHORE DRIVE
DELAVAN, WI 53115

WORK ORDERED BY -
CRAIG HUBERTZ
2130 HORSESHOE LANE
DELAVAN, WI 53115

FARRIS, HANSEN & ASSOCIATES, INC.
ENGINEERING - ARCHITECTURE - SURVEYING
7 RIDGWAY COURT P.O. BOX 437
ELKHORN, WISCONSIN 53121
OFFICE: (262) 723-2098 FAX: (262) 723-5666

REVISIONS
07/24/2017 - SB ADVANCEMENT
01/23/2018 - LB UPDATE PROPOSED RESIDENCE & SHOP
01/25/2018 - LB UPDATE SUDCEP
01/29/2018 - LB UPDATE IMPERVIOUS
03/02/2018 - DSR
02/12/2018 - DSR REVISED SILT FENCE & DIST. AREA NOTATION
02/15/2018 - DSR PER COUNTY COMMENTS
2/21/2018 - LK ADVANCEMENT
03/02/2018 - DSR PER COUNTY COMMENTS
03/16/2018 - DSR ADJ. CONST. SEQ. NOTES
04/26/2018 - SB ADVANCEMENT

PROJECT NO. 9645
DATE 1/17/2017
SHEET NO. 1 OF 1

X:\PROJECTS\9645\ACAD\9645_SCDCEP.DWG

