Plat of a survey for HARRY AND DIANE WARNAAR of Lot 1 and 2, and the East 1/2 of Lot 3, Block "C", Jackson's Subdivision, located in the Southeast 1/4 of Section 21, Township 2 North, Range 16 East of the Fourth Principal Meridian, in the Town of Delavan, Walworth County, Wisconsin.

Certificate

The above-described property has been surveyed under my direction and the map hereon drawn is a correct representation thereof to the best of my knowledge and belief.


SURVE





JACKSON PARK DRIVE (BLOCK "D" 14' WIDE)

(S)

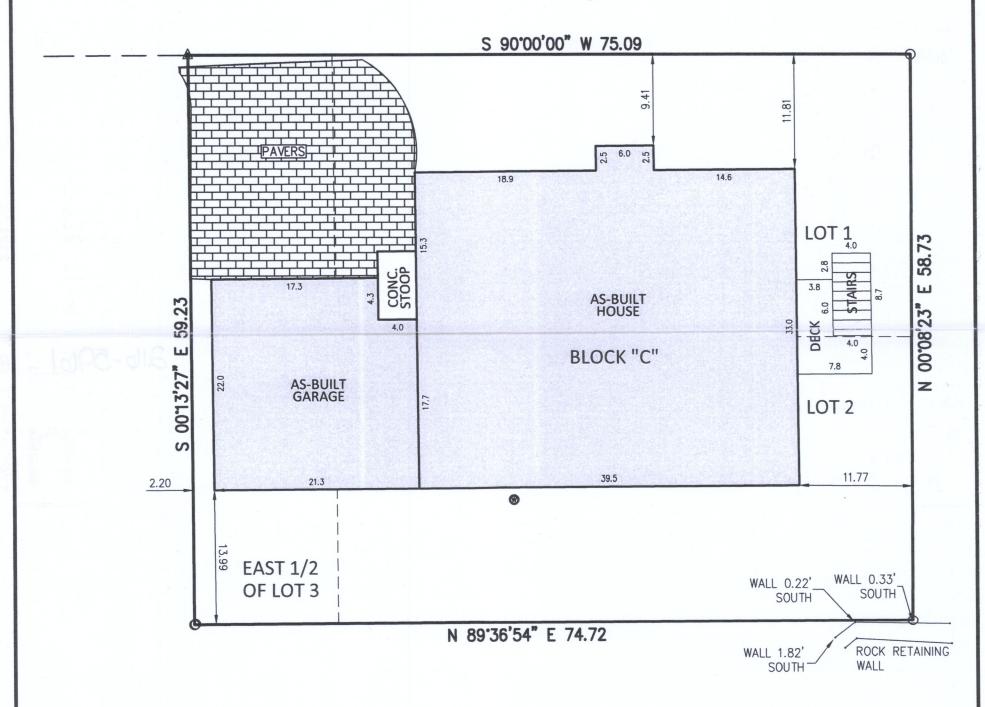

NOTES

PM

3:23:04

2022

21,

Monday, February

BEARING BASE: GRID NORTH, WISCONSIN COORDINATE SYSTEM, SOUTH ZONE. BASED UPON NAD 1983 / 2011

LEGEND

O IRON STAKE FOUND

♠ "PK" NAIL

WELL

SANITARY MANHOLE




PAVERS

Nielsen Madsen + Barber

1458 Horizon Blvd. Suite 200, Racine, WI. 53406 Tele: (262)634-5588 Website: www.nmbsc.net



4418 S.F. 100% HOUSE 1771 S.F. 40.1% **PAVERS** 500 S.F. 11.3% CONCRETE 28 S.F. 0.6% **GRASS** 2032 S.F. 46.0% DECK/STAIRS 87 S.F. 2.0%

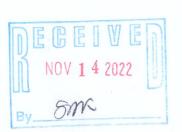


FIELD WORK 12-09-2021 BY JWP/KRF DRAWN 12-10-2021 BY SCB

SCALE 1" = 10'

SHEET 1 OF 1 SHEETS

JOB NO. 2020.0227.01

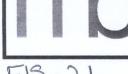

Tarcel # FJS 00021

216-5961