


PLAT OF SURVEY & PARTIAL TOPOGRAPHIC MAPPING LAS OLAS, A SUBDIVISION AND PART OF VACATED PROSPECT AVENUE

LOCATED IN PART OF THE SW 1/4 OF THE SE 1/4 OF SECTION 28 AND PART OF THE NE 1/4 AND NW 1/4 OF THE NE 1/4 OF SECTION 33, ALL IN TOWN 2 NORTH, RANGE 16 EAST, WALWORTH COUNTY, WISCONSIN



RECEIVED
JUN 16 2023
By: *[Signature]*

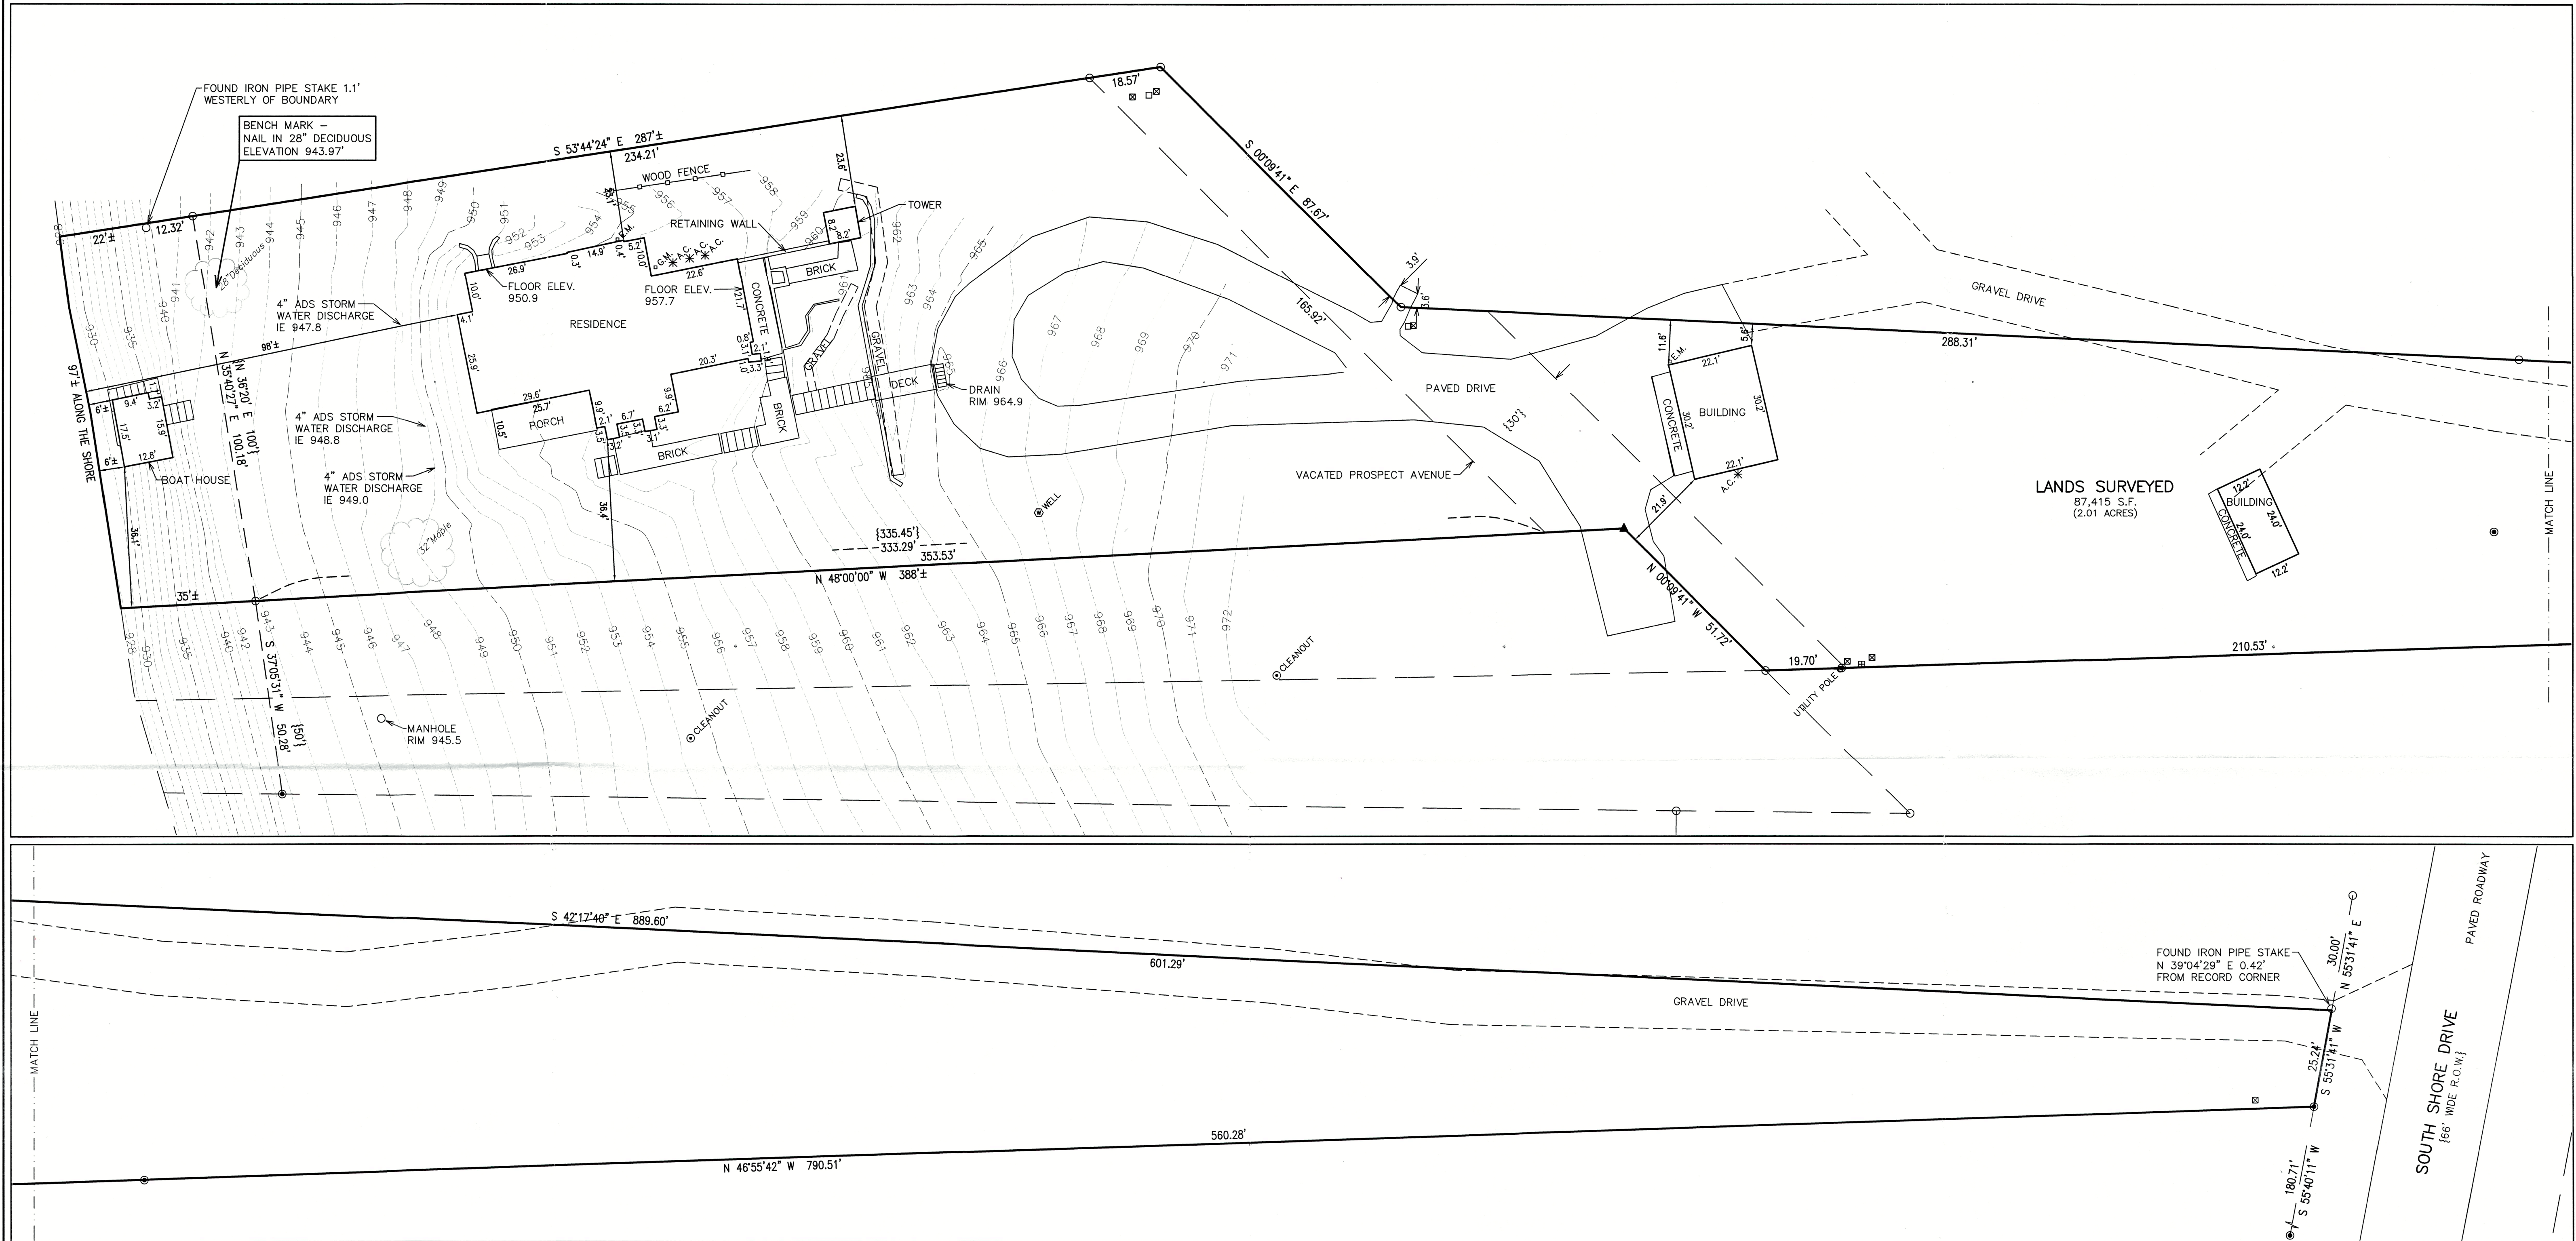


NOTE: COPIES OF THIS MAP TO WHICH THE FOLLOWING CERTIFICATE WILL APPLY SHOW THE SURVEYOR'S ORIGINAL SEAL AND SIGNATURE IN RED INK. COPIES BY ANY OTHER MEANS MAY HAVE ALTERATIONS WHICH DO NOT REPRESENT THE SURVEYOR'S WORK PRODUCT.

I HEREBY CERTIFY THAT THE ABOVE DESCRIBED PROPERTY HAS BEEN SURVEYED UNDER MY DIRECTION AND THAT THE ABOVE MAP IS A TRUE REPRESENTATION THEREOF AND SHOWS THE SIZE AND LOCATION OF THE PROPERTY AND ITS EXTERIOR BOUNDARIES. THIS SURVEY IS MADE FOR THE USE OF THE PRESENT OWNERS OF THE PROPERTY, AND ALSO THOSE WHO PURCHASE, MORTGAGE, OR GUARANTEE THE TITLE THERETO WITHIN ONE YEAR FROM THE DATE HEREOF.

DATED: 4/26/2023
[Signature]
CHRISTOPHER A. HODGES P.L.S. 2760

ASSIGNED TO THE WESTERLY BOUNDARY OF LOT 6 OF PLOT 148-0000-W

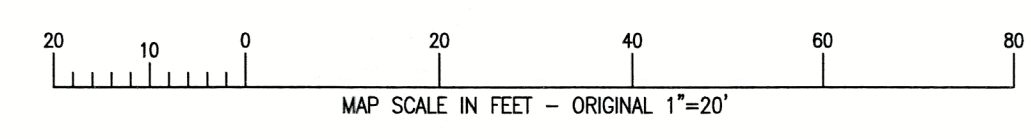

- LEGEND**
- = CONCRETE MONUMENT LOCATED
 - = IRON PIPE STAKE LOCATED
 - ▲ = SET MAG NAIL IN PAVEMENT
 - = UTILITY BOX LOCATED
 - G.M. = GAS METER LOCATED
 - E.M. = ELECTRIC METER LOCATED
 - A.C. = AIR CONDITIONING UNIT LOCATED
 - {XXX} = RECORDED AS

<p>TOPOGRAPHIC SURVEY</p> <p>3211 SOUTH SHORE DRIVE DELANAV, WISCONSIN</p>	<p>— WORK ORDERED BY — MIKE LOPRESTI 2520 INDIAN RIDGE DRIVE GLENVIEW, IL 60026</p>	<p>FARRIS, HANSEN & ASSOCIATES, INC. ENGINEERING — ARCHITECTURE — SURVEYING</p> <p>7 RIDGWAY COURT P.O. BOX 437 ELKHORN, WISCONSIN 53121 PHONE: (262) 723-2098 e-mail: office@farrishansen.com</p>	<p>REVISIONS</p> <table border="1" style="width: 100%; border-collapse: collapse;"> <tr> <td style="width: 50%;">5-4-23-CAH ADD MISC ITEMS MISSED ON ORIGINAL FIELD WORK</td> <td style="width: 50%;"></td> </tr> </table>	5-4-23-CAH ADD MISC ITEMS MISSED ON ORIGINAL FIELD WORK		<p>PROJECT NO. 10853</p> <p>DATE 04/26/2023</p> <p>SHEET NO. 1 OF 1</p>
			5-4-23-CAH ADD MISC ITEMS MISSED ON ORIGINAL FIELD WORK			
<p>316-6019</p>						

X:\PROJECTS\10853\ACAD\10853.dwg

FLO-1