
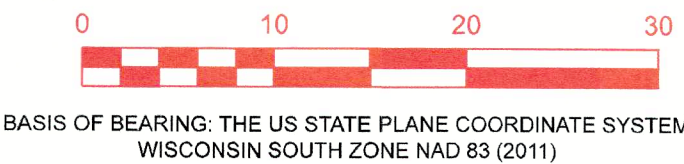


PLAT OF SURVEY


OF

LOT 18 IN LAKE DELAVAN HIGHLANDS, BEING A SUBDIVISION LOCATED IN THE SOUTH 1/2 OF THE SOUTHEAST 1/4 OF SECTION 31, TOWN 2 NORTH, RANGE 16 EAST, TOWN OF DELAVAN, WALWORTH COUNTY, WISCONSIN.

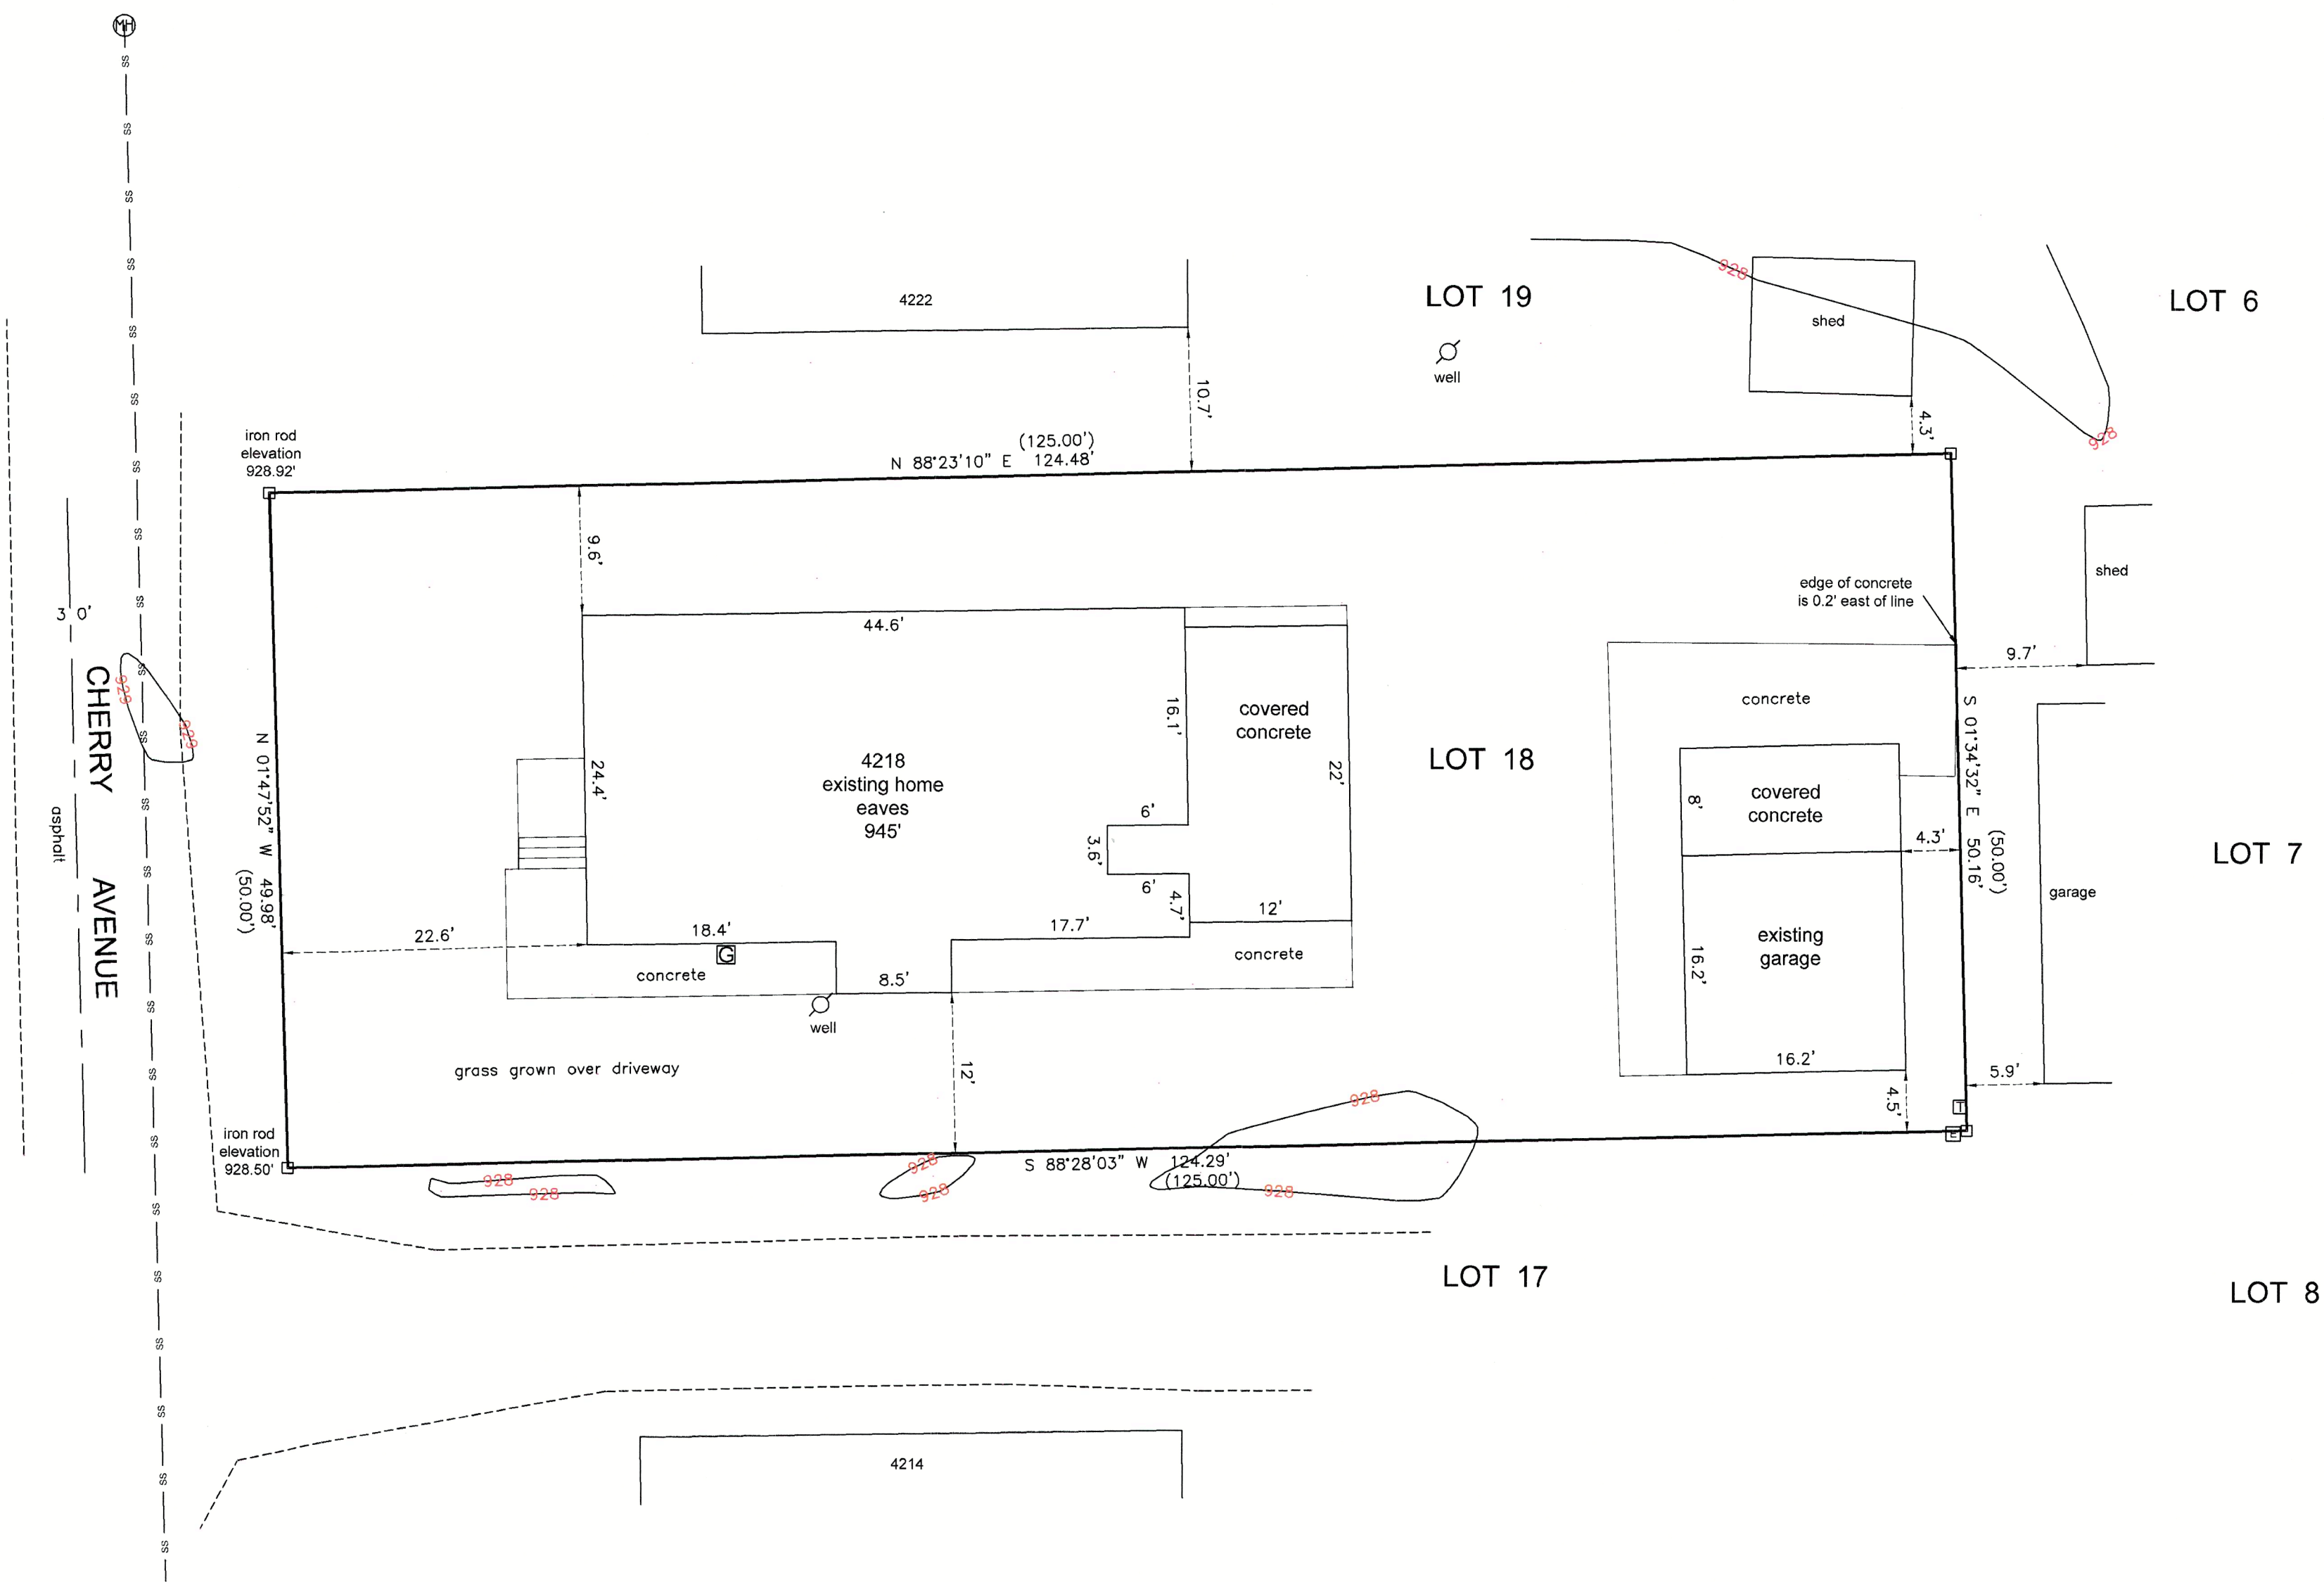

0.1435 Acres  
Soils - Pa  
Zoning R-2A, Shoreland

- (XXX) = RECORDED AS  
□ = FOUND IRON ROD  
⊞ = GAS METER  
⊞ = COMMUNICATIONS PEDESTAL  
⊞ = ELECTRICAL PEDESTAL
- SCALE 1" = 10'  
JOB NO. 2023-049  
TAX ID # FLAD 00016

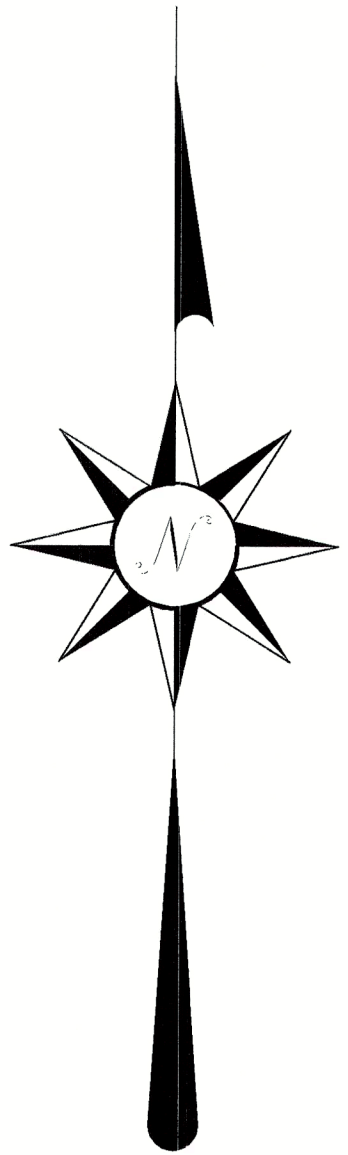

PREPARED FOR:  
ANGELO DIRENZO  
ANGEL GOMEZ

I HEREBY CERTIFY THAT I HAVE SURVEYED THE ABOVE DESCRIBED PROPERTY AND THE ABOVE MAP IS A TRUE REPRESENTATION THEREOF AND SHOWS THE SIZE AND LOCATION OF THE PROPERTY, ITS EXTERIOR BOUNDARIES, THE LOCATION AND DIMENSIONS OF ALL STRUCTURES THEREON, FENCES, APPARENT EASEMENTS, ROADWAYS, AND VISIBLE ENCROACHMENTS, IF ANY.

THIS SURVEY IS MADE FOR THE PRESENT OWNERS OF THE PROPERTY AND THOSE WHO PURCHASE, MORTGAGE, OR GUARANTEE THE TITLE THERETO WITHIN ONE YEAR FROM THIS DATE HEREOF.

DATED THIS 22ND DAY OF AUGUST 2023



LAKELAND SURVEYORS LLC  
P O BOX 188  
DELAVAN, WI 53115  
262-475-9567  
email: lakelandsurveyors@outlook.com



STEVEN L. SCHMIDT S - 2813  
Wisconsin Professional Land Surveyor

FLAD-16

016-6041