


West line of the Southeast 1/4 of Section 19-2-16  
N0°16'05"E 2654.17'  
recorded as(N1°16'03"W 2654.25')State Plane

## of


a subdivision located in the Northwest 1/4 of the Southeast 1/4 of Section 19, Town 2 North, Range 16 East, Town of Delavan, Walworth County, Wisconsin.

Coordinates are referenced to the Wisconsin State Plane Coordinate System, South Zone, (NAD-27).

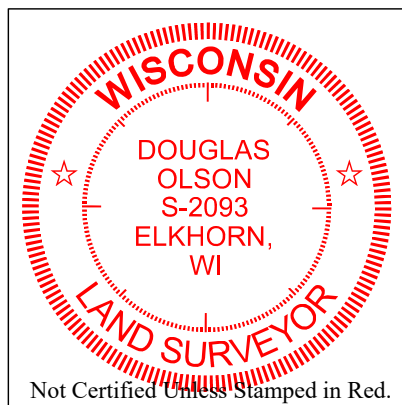

- 1) This Plat of Survey is not certified unless signed and sealed in red ink.
- 2) This survey is subject to Wisconsin lien laws. This Plat of Survey is the notice of intent to file lien. Lien waiver required.
- 3) The Survey Date shown on this Plat of Survey is the completion date of the field work.

Block  
Corner

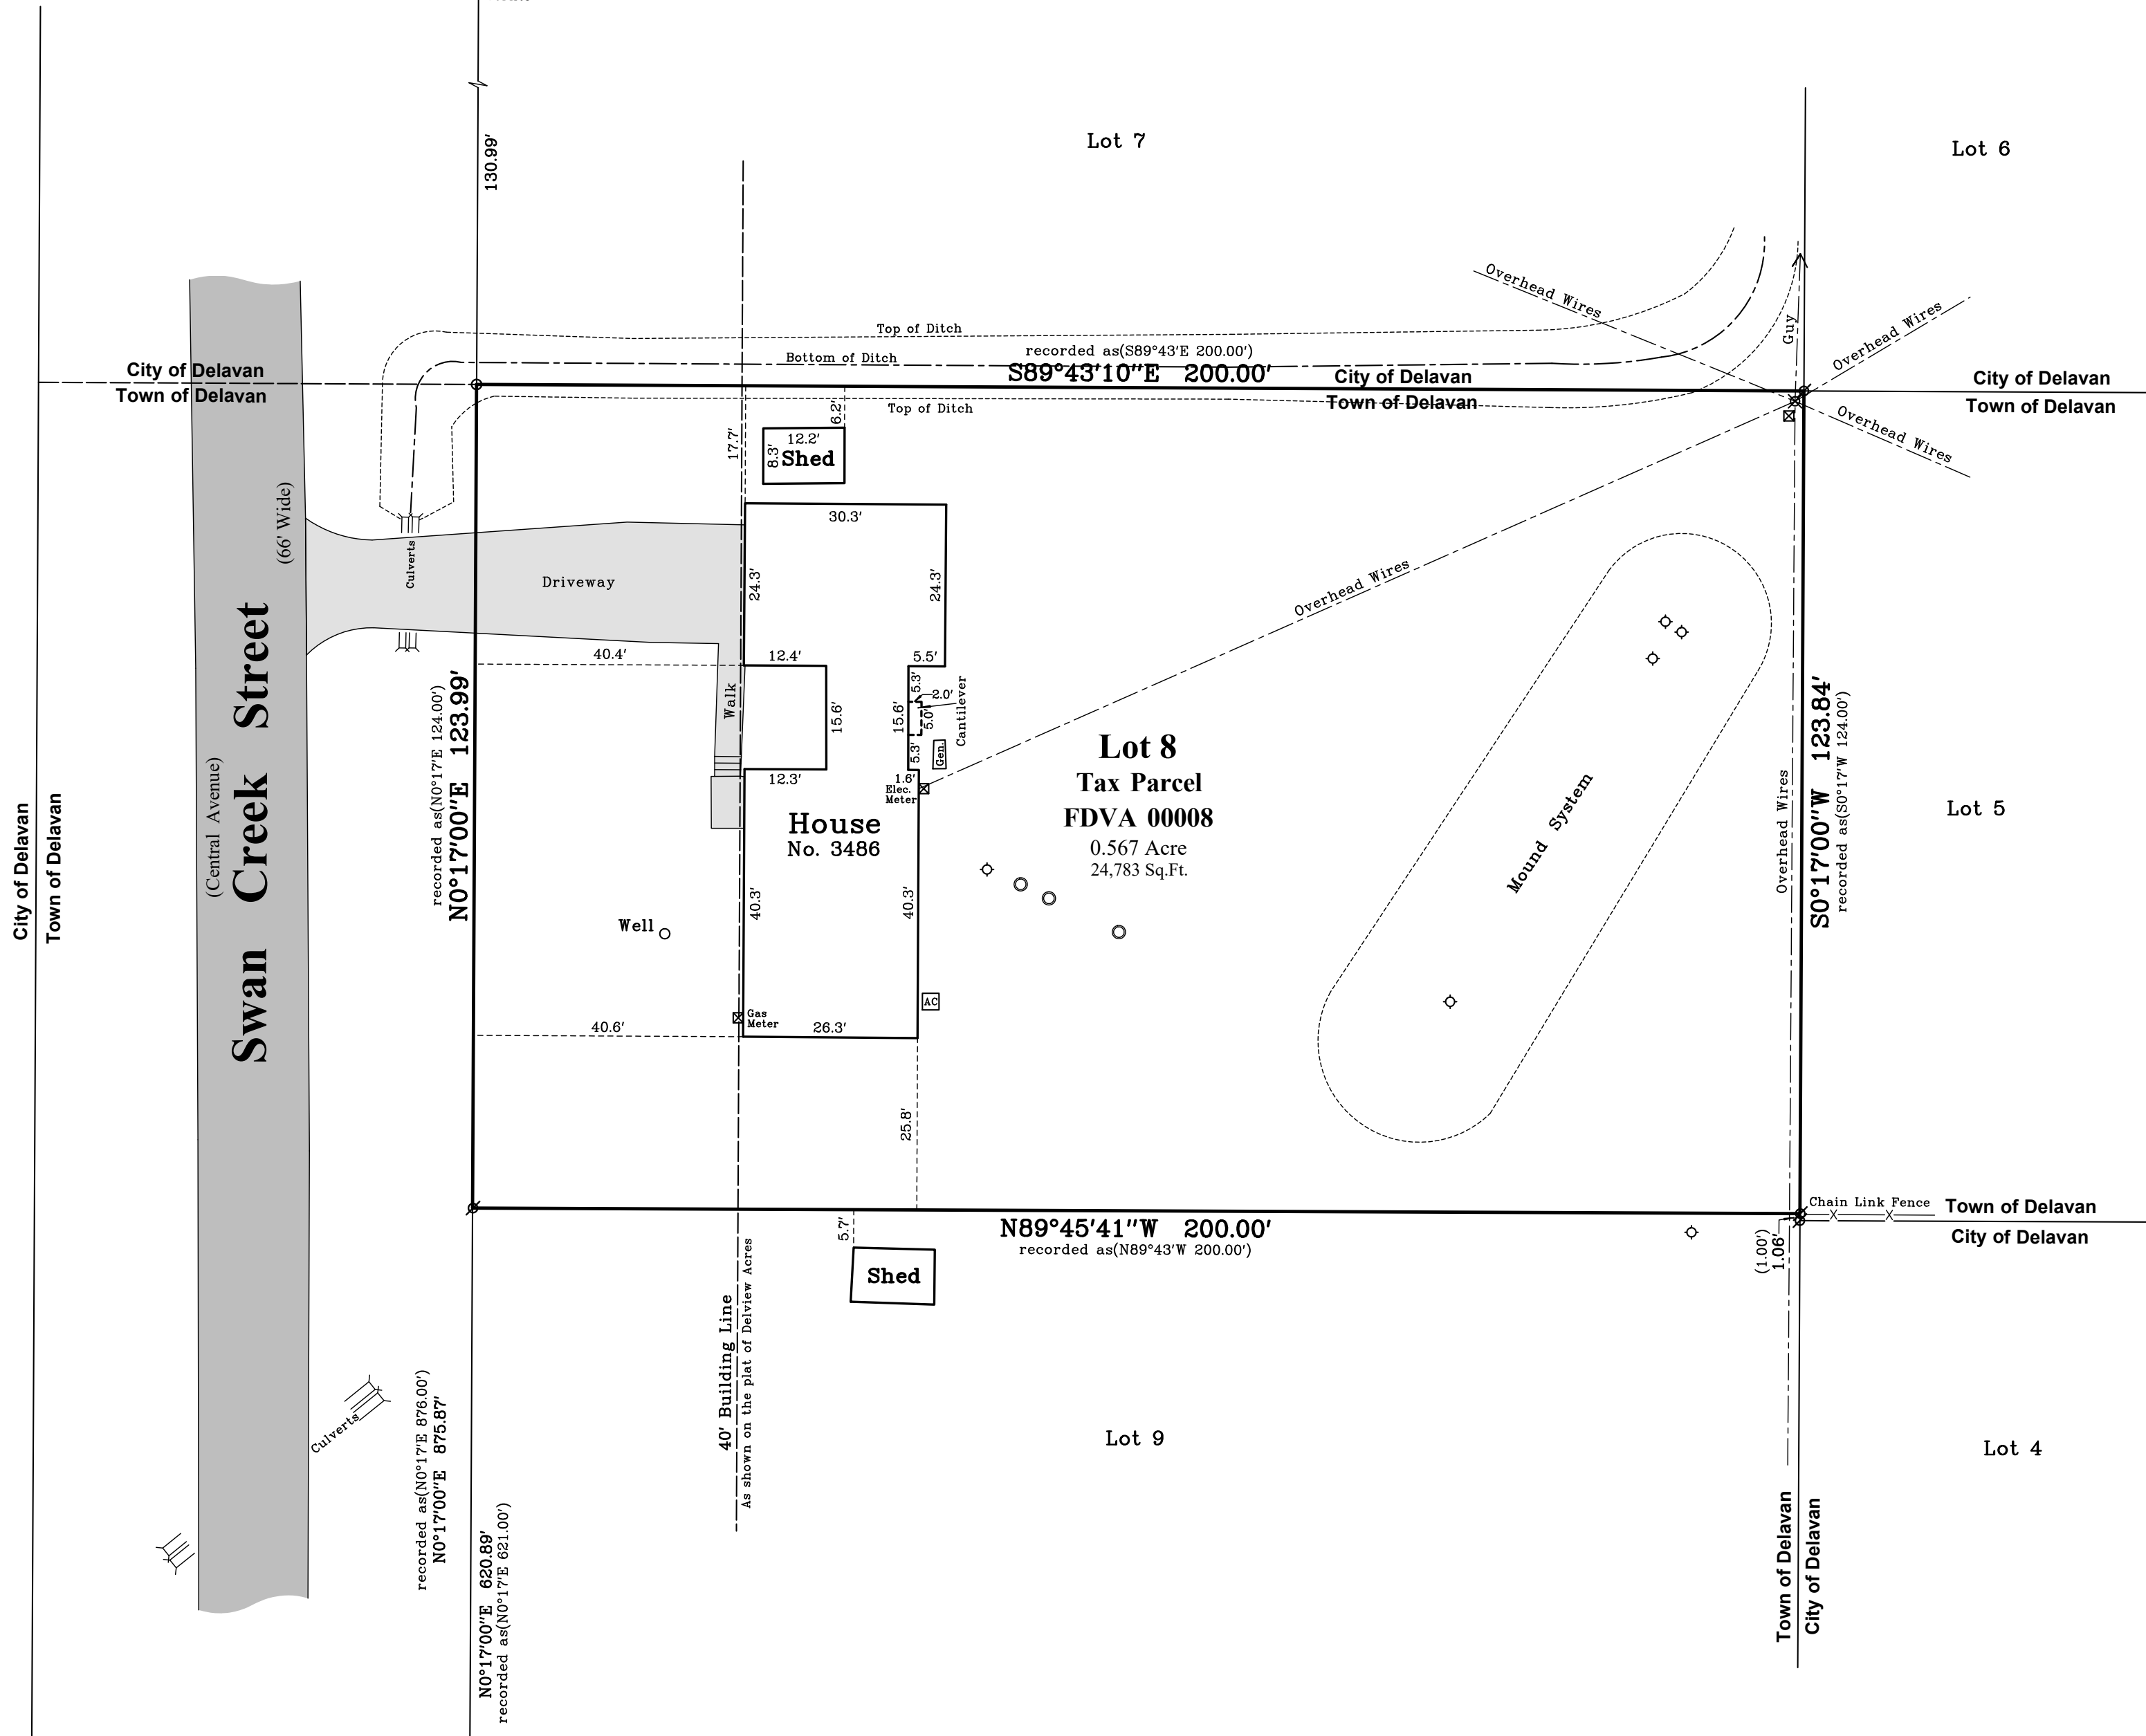

All rights reserved. No part of this survey plat may be reproduced or transmitted in any form by any means - graphic, electronic, or mechanical, including photocopying, tracing, or information storage and retrieval systems - without permission in writing from Douglas G. Olson, Olson Land Surveying, LLC.

This survey is made for the exclusive use of the present owners of the property, and also those who purchase, mortgage or guarantee title thereto, within one year from the date hereof.

Douglas G. Olson  
Wisconsin Professional Land Surveyor - 2093

Scale in Feet  
1" = 20'



A horizontal scale bar with alternating black and white segments. The segments are labeled 0', 10', 20', 40', and 60' from left to right. The bar is 60 feet long in total.

45 South Wisconsin Street | P.O. Box 322  
Elkhorn, Wisconsin. 53121  
Telephone: (262) 723-3434  
Facsimile: (262) 723-8044  
Email: [doug@olsonsurveying.com](mailto:doug@olsonsurveying.com)  
Website: [www.olsonsurveying.com](http://www.olsonsurveying.com)



**OLSON**  
LAND SURVEYING, LLC

Rural | Residential | Commercial

**Legend of Symbols & Abbreviations**

■ Found	County Section Corner	N North
○ Found Iron Pipe		S South
○ Set Iron Pipe, 1" dia.		E East
○ Recorded Information		W West
○ Utility Pole		in Bearings
○ Utility Pedestal		° Degrees
○ Concrete Cover		" Minutes
○ Concrete Cover		" Seconds
○ Septic Vent		in Distances
○ Asphalt Surface		inches
○ Concrete Surface		

Sheet 1 of 1 Sheets  
 Drawing Name:  
 Job Reference Number  
 2023.017

**2023.017**