


**LAND-MARK SURVEYING**  
**Mark L. Miritz**  
Wisconsin Professional Land Surveyor S-2582

N9330 Knuteson Drive  
Whitewater, WI 53190  
Phone: (262) 949-1239  
MARKMIRITZ@  
LAND-MARKSURVEYING.COM

LOT 73 AND LOT 74, LAKE DELAVAN HIGHLANDS SUBDIVISION,  
LOCATED IN THE SOUTHEAST 1/4 OF SECTION 31, TOWN 2 NORTH,  
RANGE 16 EAST, DELAVAN TOWNSHIP, WALWORTH COUNTY,  
WISCONSIN.

OWNERS: PATRICK R. MIHALSKI  
FRANCES D. MIHALSKI  
4237 S. CENTRAL BLVD.  
DELAVAN, WI 53115

PLAT OF SURVEY

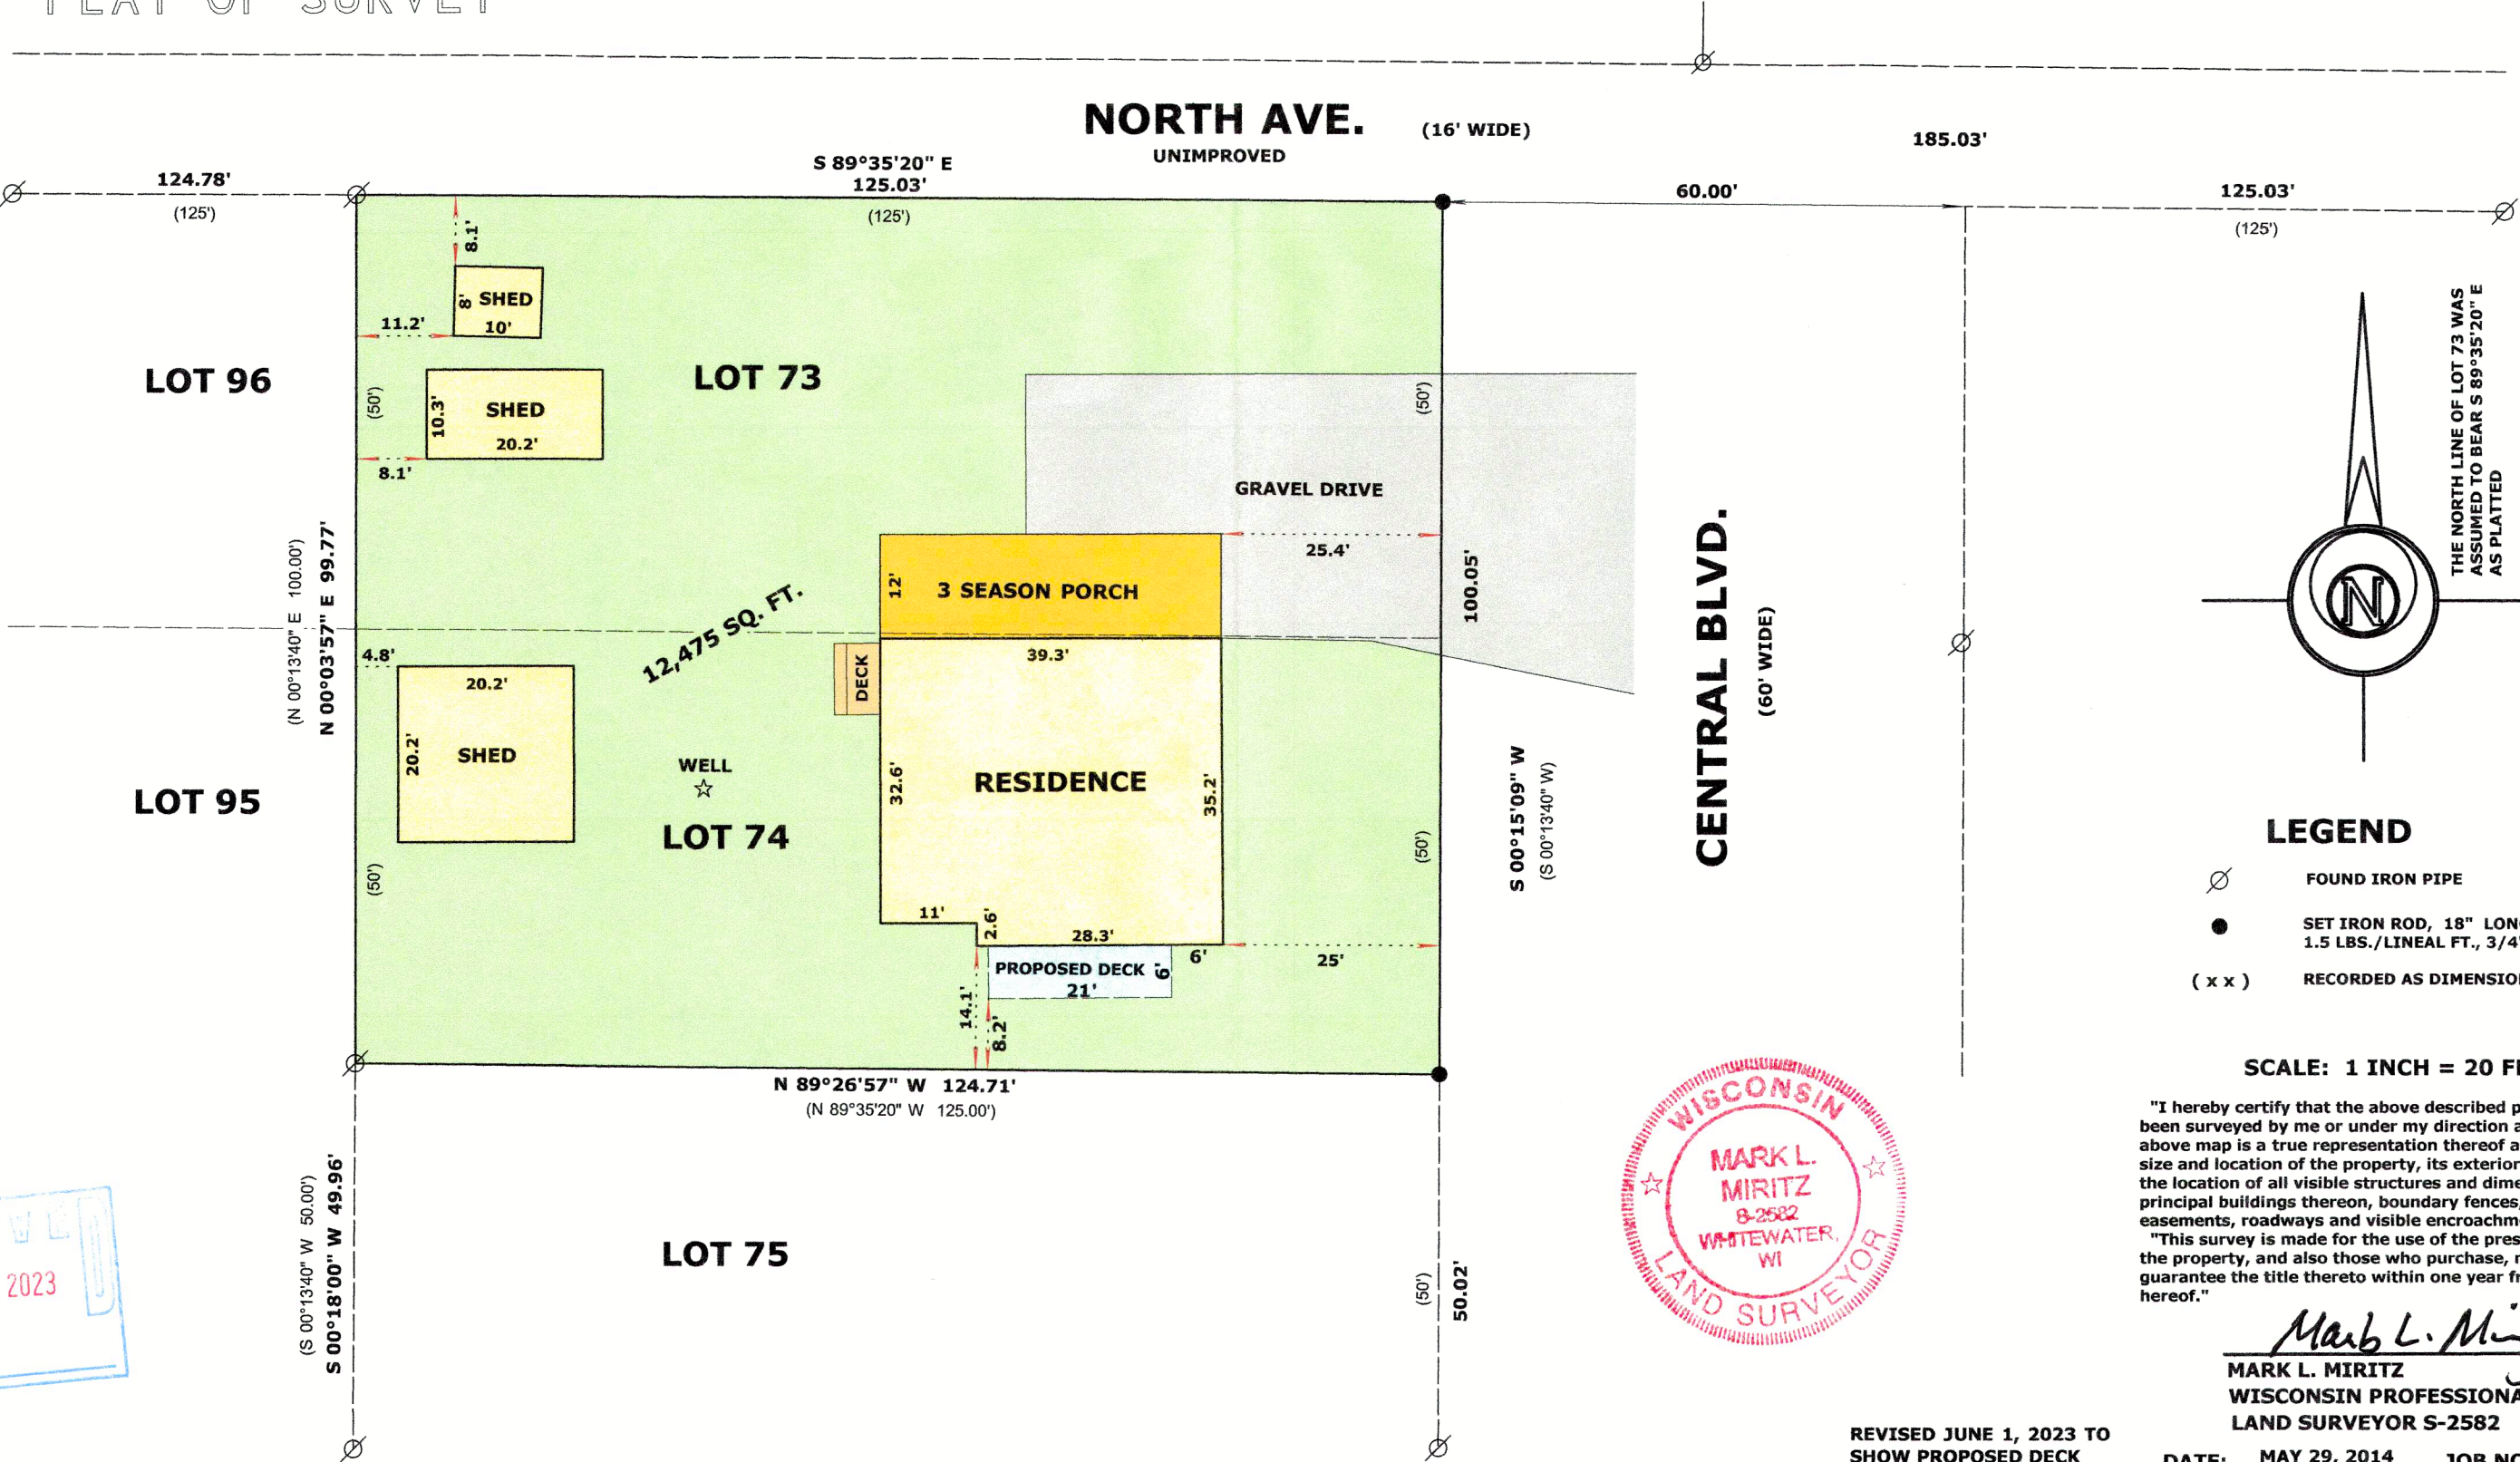

RECEIVED  
SEP 20 2023  
By SHF



FLAD-68

216-6067