


LAND-MARK SURVEYING
Mark L. Miritz
 Wisconsin Professional Land Surveyor S-2582

N9330 Knuteson Drive
 Whitewater, WI 53190
 Phone: (262)949-1239
 MARKMIRITZ@
 LAND-MARKSURVEYING.COM

LOT 73 AND LOT 74, LAKE DELAVAN HIGHLANDS SUBDIVISION,
 LOCATED IN THE SOUTHEAST 1/4 OF SECTION 31, TOWN 2 NORTH,
 RANGE 16 EAST, DELAVAN TOWNSHIP, WALWORTH COUNTY,
 WISCONSIN.

OWNERS: PATRICK R. MIHALSKI
 FRANCES D. MIHALSKI
 4237 S. CENTRAL BLVD.
 DELAVAN, WI 53115

PLAT OF SURVEY

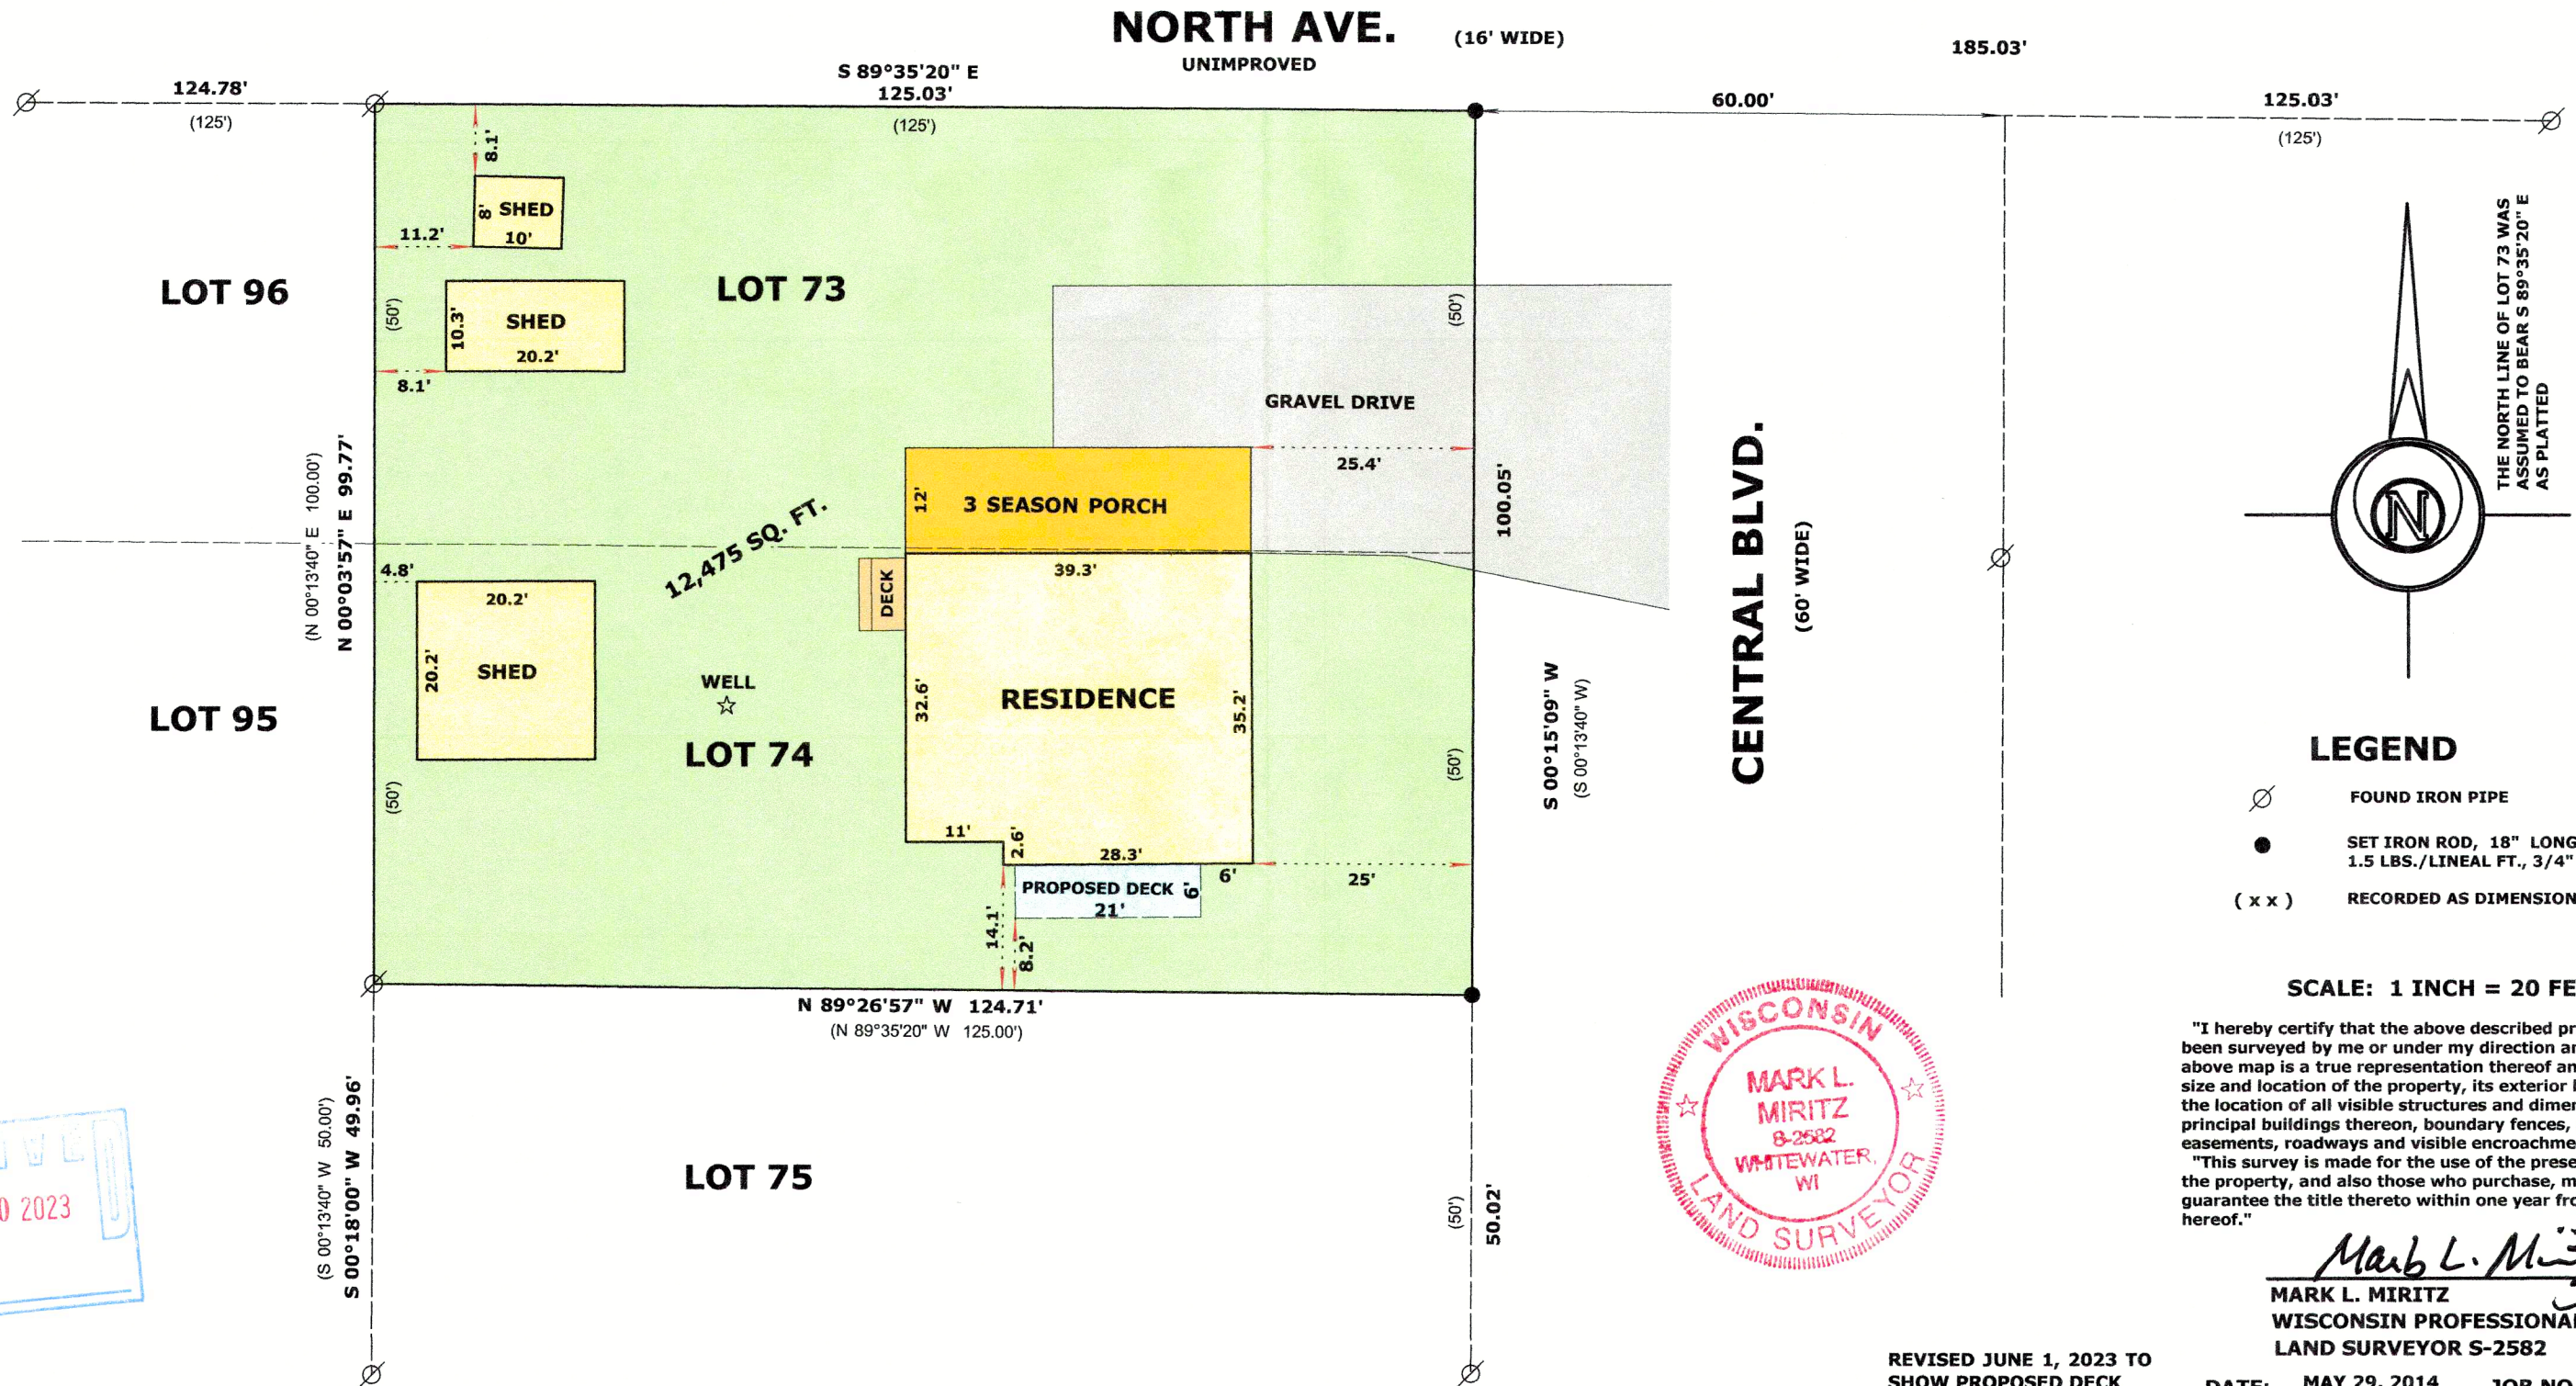

RECEIVED
 SEP 20 2023
 By SHF



Mark L. Miritz
 MARK L. MIRITZ
 WISCONSIN PROFESSIONAL
 LAND SURVEYOR S-2582
 DATE: MAY 29, 2014 JOB NO. 14.501

FLAD-68

216-6067