
PLAT OF SURVEY PERMIT PLAT FOR SIGNAGE

LOTS 39-43, BLOCK 2, INLET OAKS SUBDIVISION NO. 3 LOCATED IN PART OF SECTIONS 15 AND 22, TOWN 2 NORTH, RANGE 16 EAST, TOWN OF DELAVAN, WALWORTH COUNTY, WISCONSIN

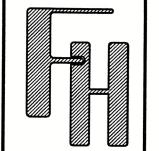


REVISIONS

12/08/2023 -TS ADD SIGNAGE

PROJECT NO. 3410.10

07/20/2010 SHEET NO. 1 OF 1

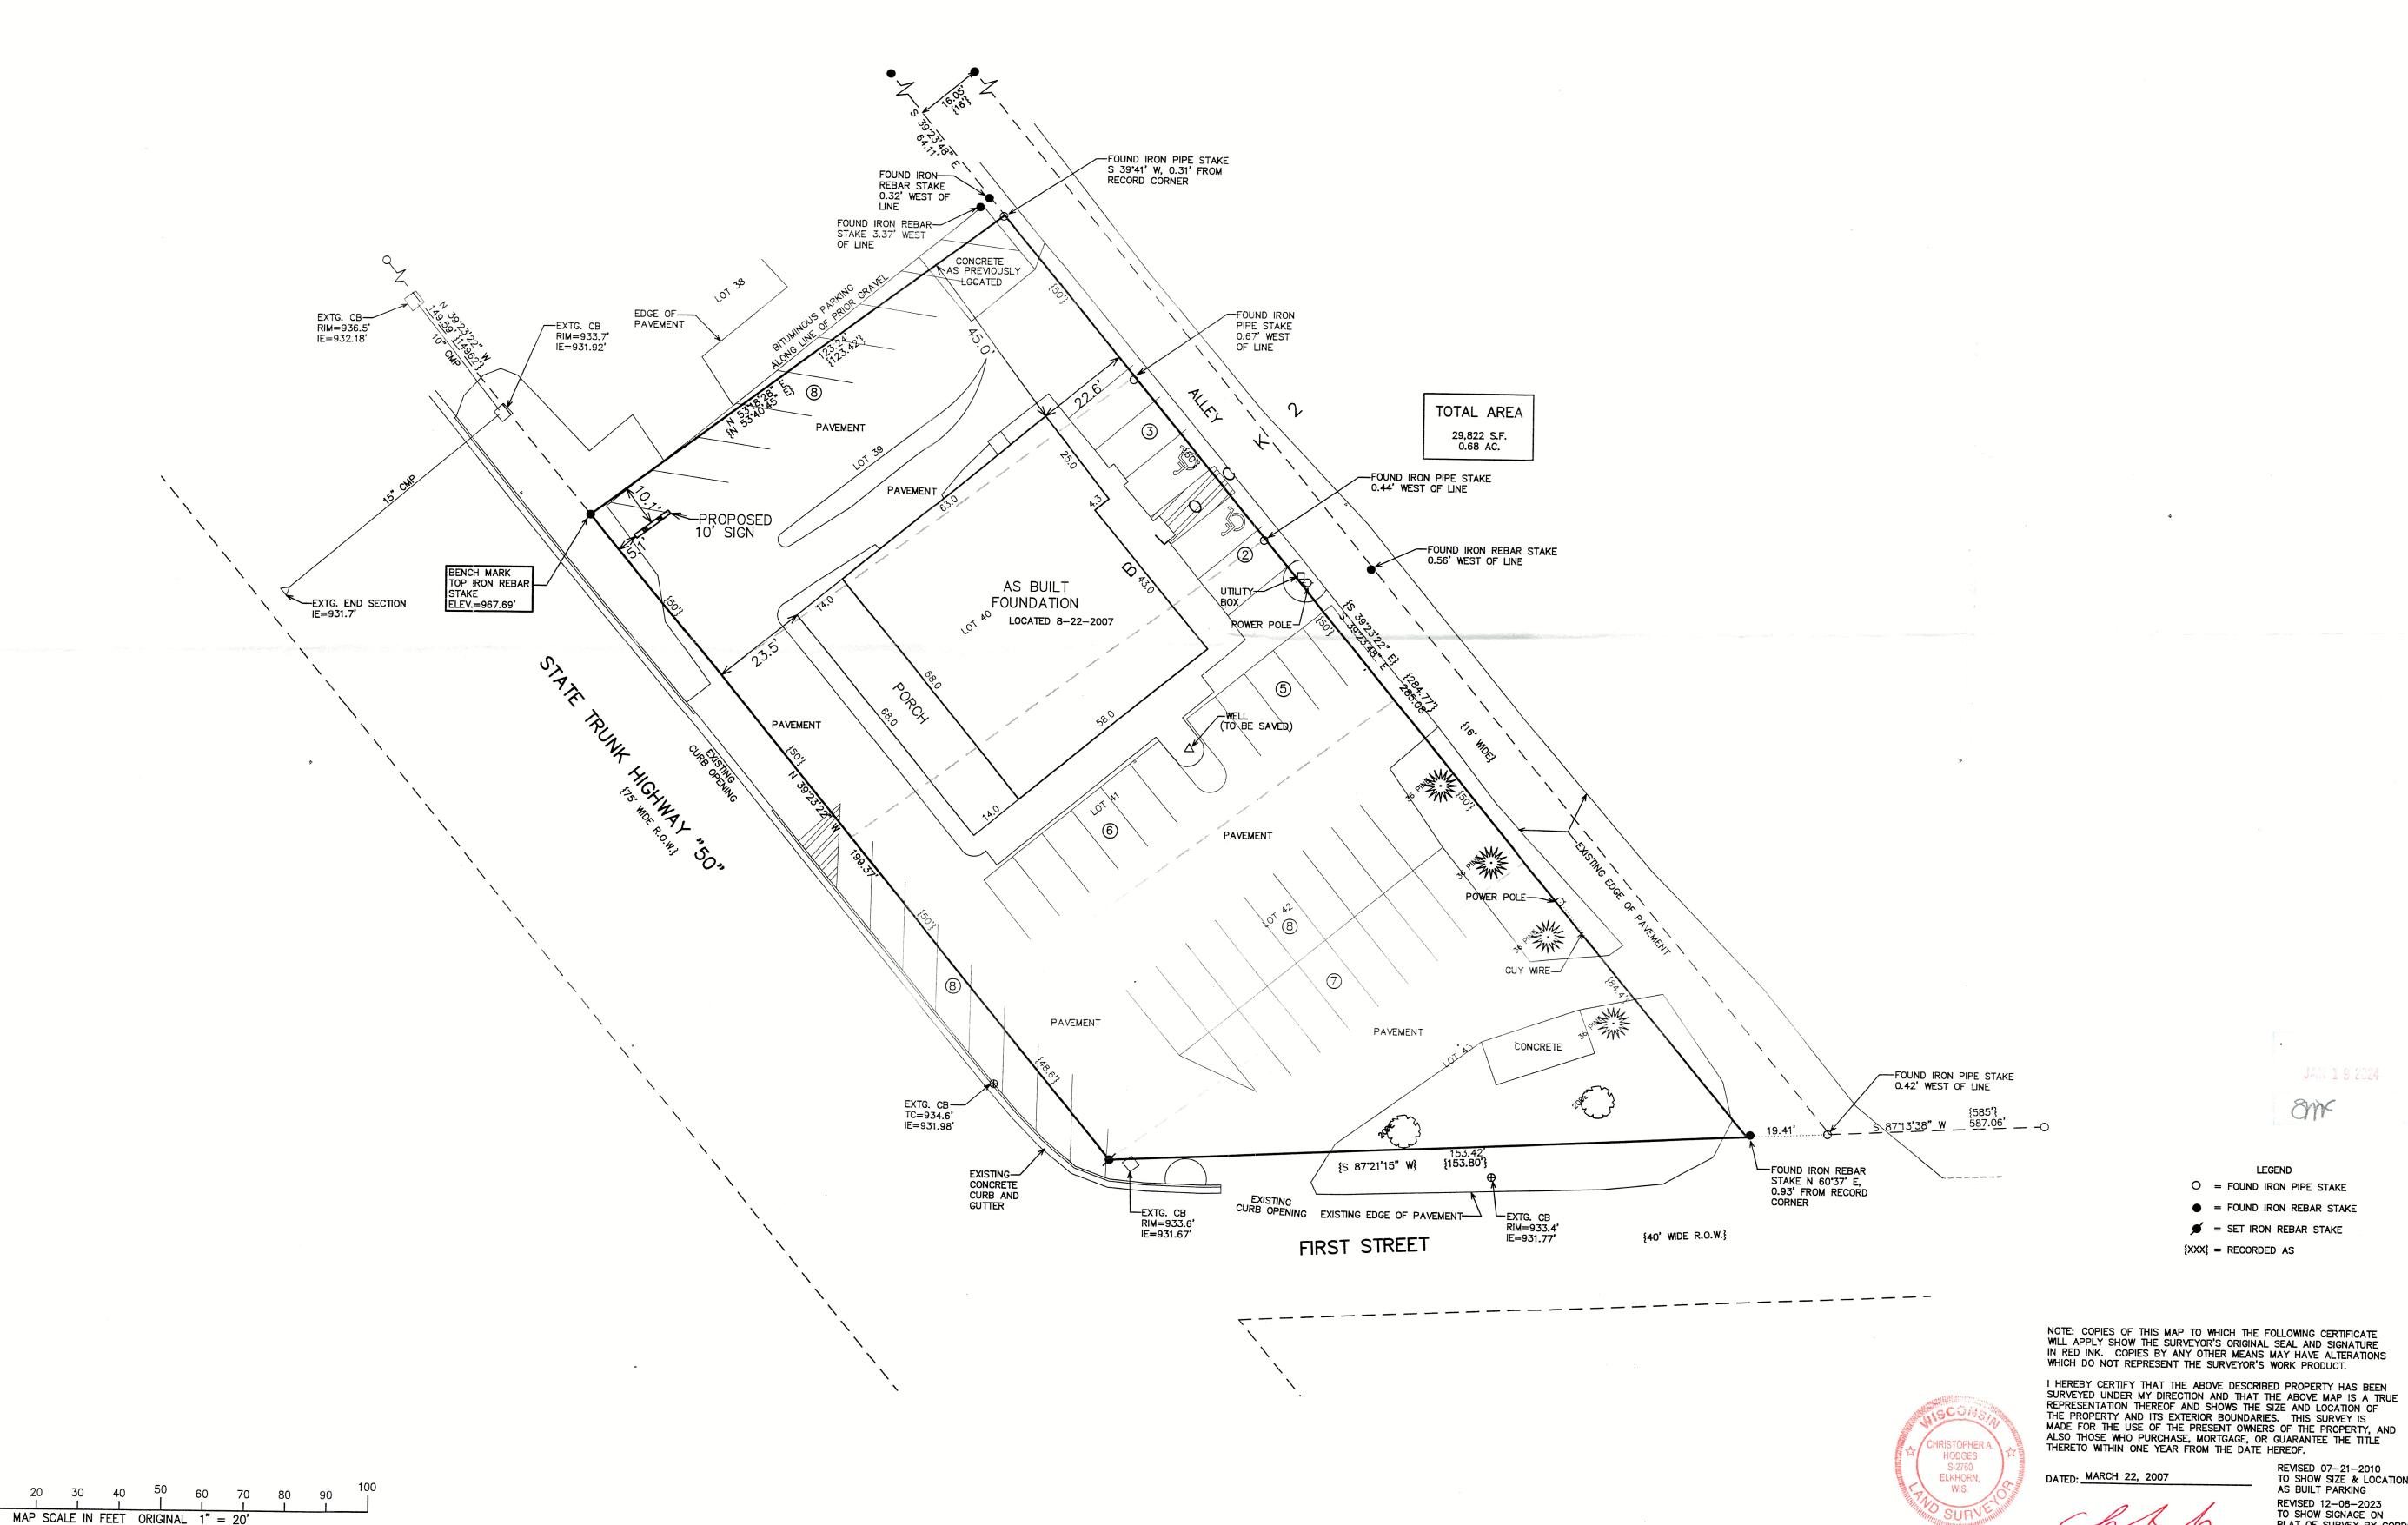

FIN3-53

CHRISTOPHER A. HODGES P.L.S. 2760

REVISED 07-21-2010 TO SHOW SIZE & LOCATION OF AS BUILT PARKING

REVISED 12-08-2023 TO SHOW SIGNAGE ON PLAT OF SURVEY BY GORDON

LEGEND