



PLAT OF SURVEY

Lot 16 in Block 1 in South Shore Manor, being a Subdivision of a part of Section 5, in Township 1 North, Range 16 East and Section 32, Township 2 North, Range 16 East, in the Townships of Walworth and Delavan.

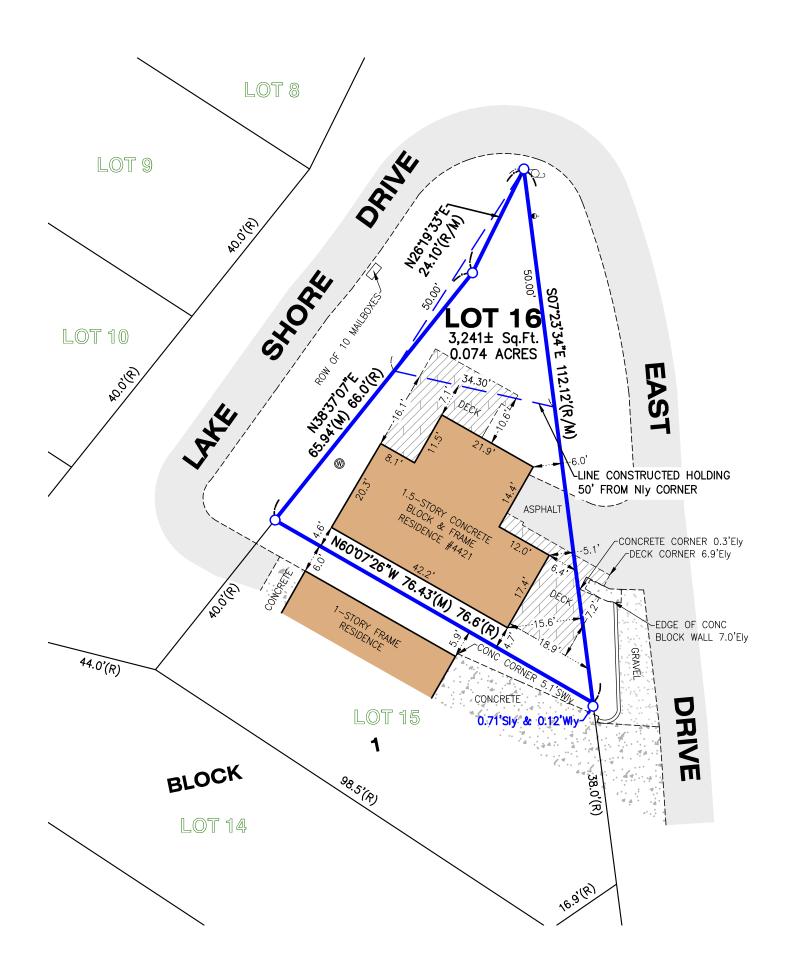

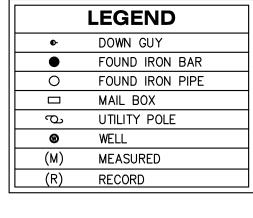

20' 0' 20' 40'

SCALE: 1" = 20'

SCALE: 1" = 20'

OTE: Only those Building Line Restrictions or Plants shown on a Recorded Subdivision Plants

NOTE: Only those Building Line Restrictions or Easements shown on a Recorded Subdivision Plat are shown hereon unless the description ordered to be surveyed contains a proper description of the required building lines or easements.

- * No distance should be assumed by scaling.
- * No underground improvements have been located unless shown and noted.
- * No representation as to ownership, use,
- or possession should be hereon implied.

 * This Survey and Plat of Survey are void without original embossed or colored seal and signature affixed.

Compare your description and site markings with this plat and AT ONCE report any discrepancies which you may find.

12/08/23 - CKV - ADDED "VISION TRIANGLE" AND ADDITIONAL TIES

CONS

ARTHUR P.

GRITMACKER S-3021

WOODSTOCK

ILLINOIS


SURVE

In my professional opinion, and based on my observations, I hereby certify that the above described property has been surveyed under my direction and that the above map is a true representation thereof and shows the size and location of all visible structures, and dimensions of all principle buildings thereon, boundary fences, apparent easements, roadways, and visible encroachments, if any. This survey is made for the use of the present owners of the property, and also those who purchase, mortgage, or guarantee the title thereto within one year from the date hereof.

Dated at Woodstock, McHenry County, Illinois 06/01 A.D., 2023.

Vanderstappen Land Surveying, Inc. Design Firm No. 184-002792

By: Misconsin Registered Land Surveyor No. S3021

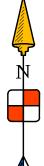

JOB NO.: 230404

FIELDWORK COMP.: 05/30/23 BK. PG.

ALL DISTANCES SHOWN IN FEET AND DECIMAL PARTS THEREOF CORRECTED TO 68° F.