


PLAT OF SURVEY – AS BUILT
GLIEBE RESIDENCE

LOT 8 IN BLOCK 1 OF
WOODLAWN BAY COMMUNITY
A SUBDIVISION LOCATED IN GOVERNMENT LOT 1 IN THE NE 1/4 OF SEC 28
TOWN 2 NORTH, RANGE 16 EAST, TOWN OF DELAVAN, WALWORTH COUNTY, WISCONSIN

RECEIVED
APR 23 2024
cus

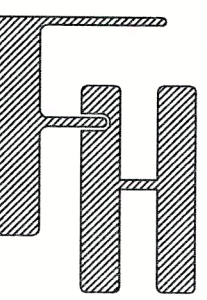

AS-BUILT
GLIEBE RESIDENCE

WORK ORDERED BY –
LOWELL CUSTOM HOMES
401 GENEVA NATIONAL AVE S 6
LAKE GENEVA, WI 53147


FARRIS, HANSEN & ASSOCIATES, INC.
ENGINEERING – ARCHITECTURE – SURVEYING
7 RIDGWAY COURT P.O. BOX 437
ELKHORN, WISCONSIN 53121
OFFICE: (262) 723-2098 FAX: (262) 723-5886

REVISIONS
7/13/2023 – DHC
NEW HOUSE DESIGN
HOUSE ELEV. CHANGE
7/20/2023 – DHC
REVISE THE REVISIONS
8/16/2023 – DHC
MOVED GARAGE 3" (W)
RAISED IT 8"
10/04/2023 – DHC
ADDED DUMPSTER
AND EROSION CONTROL
2/01/2024 – DHC
AS-BUILT RESIDENCE


PROJECT NO.
10488

DATE
06/22/2021

SHEET NO.
1 OF 1

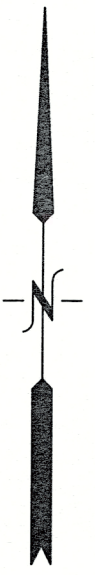

(MARINE TERRACE)
LAKEVIEW DRIVE
(50' WIDE)

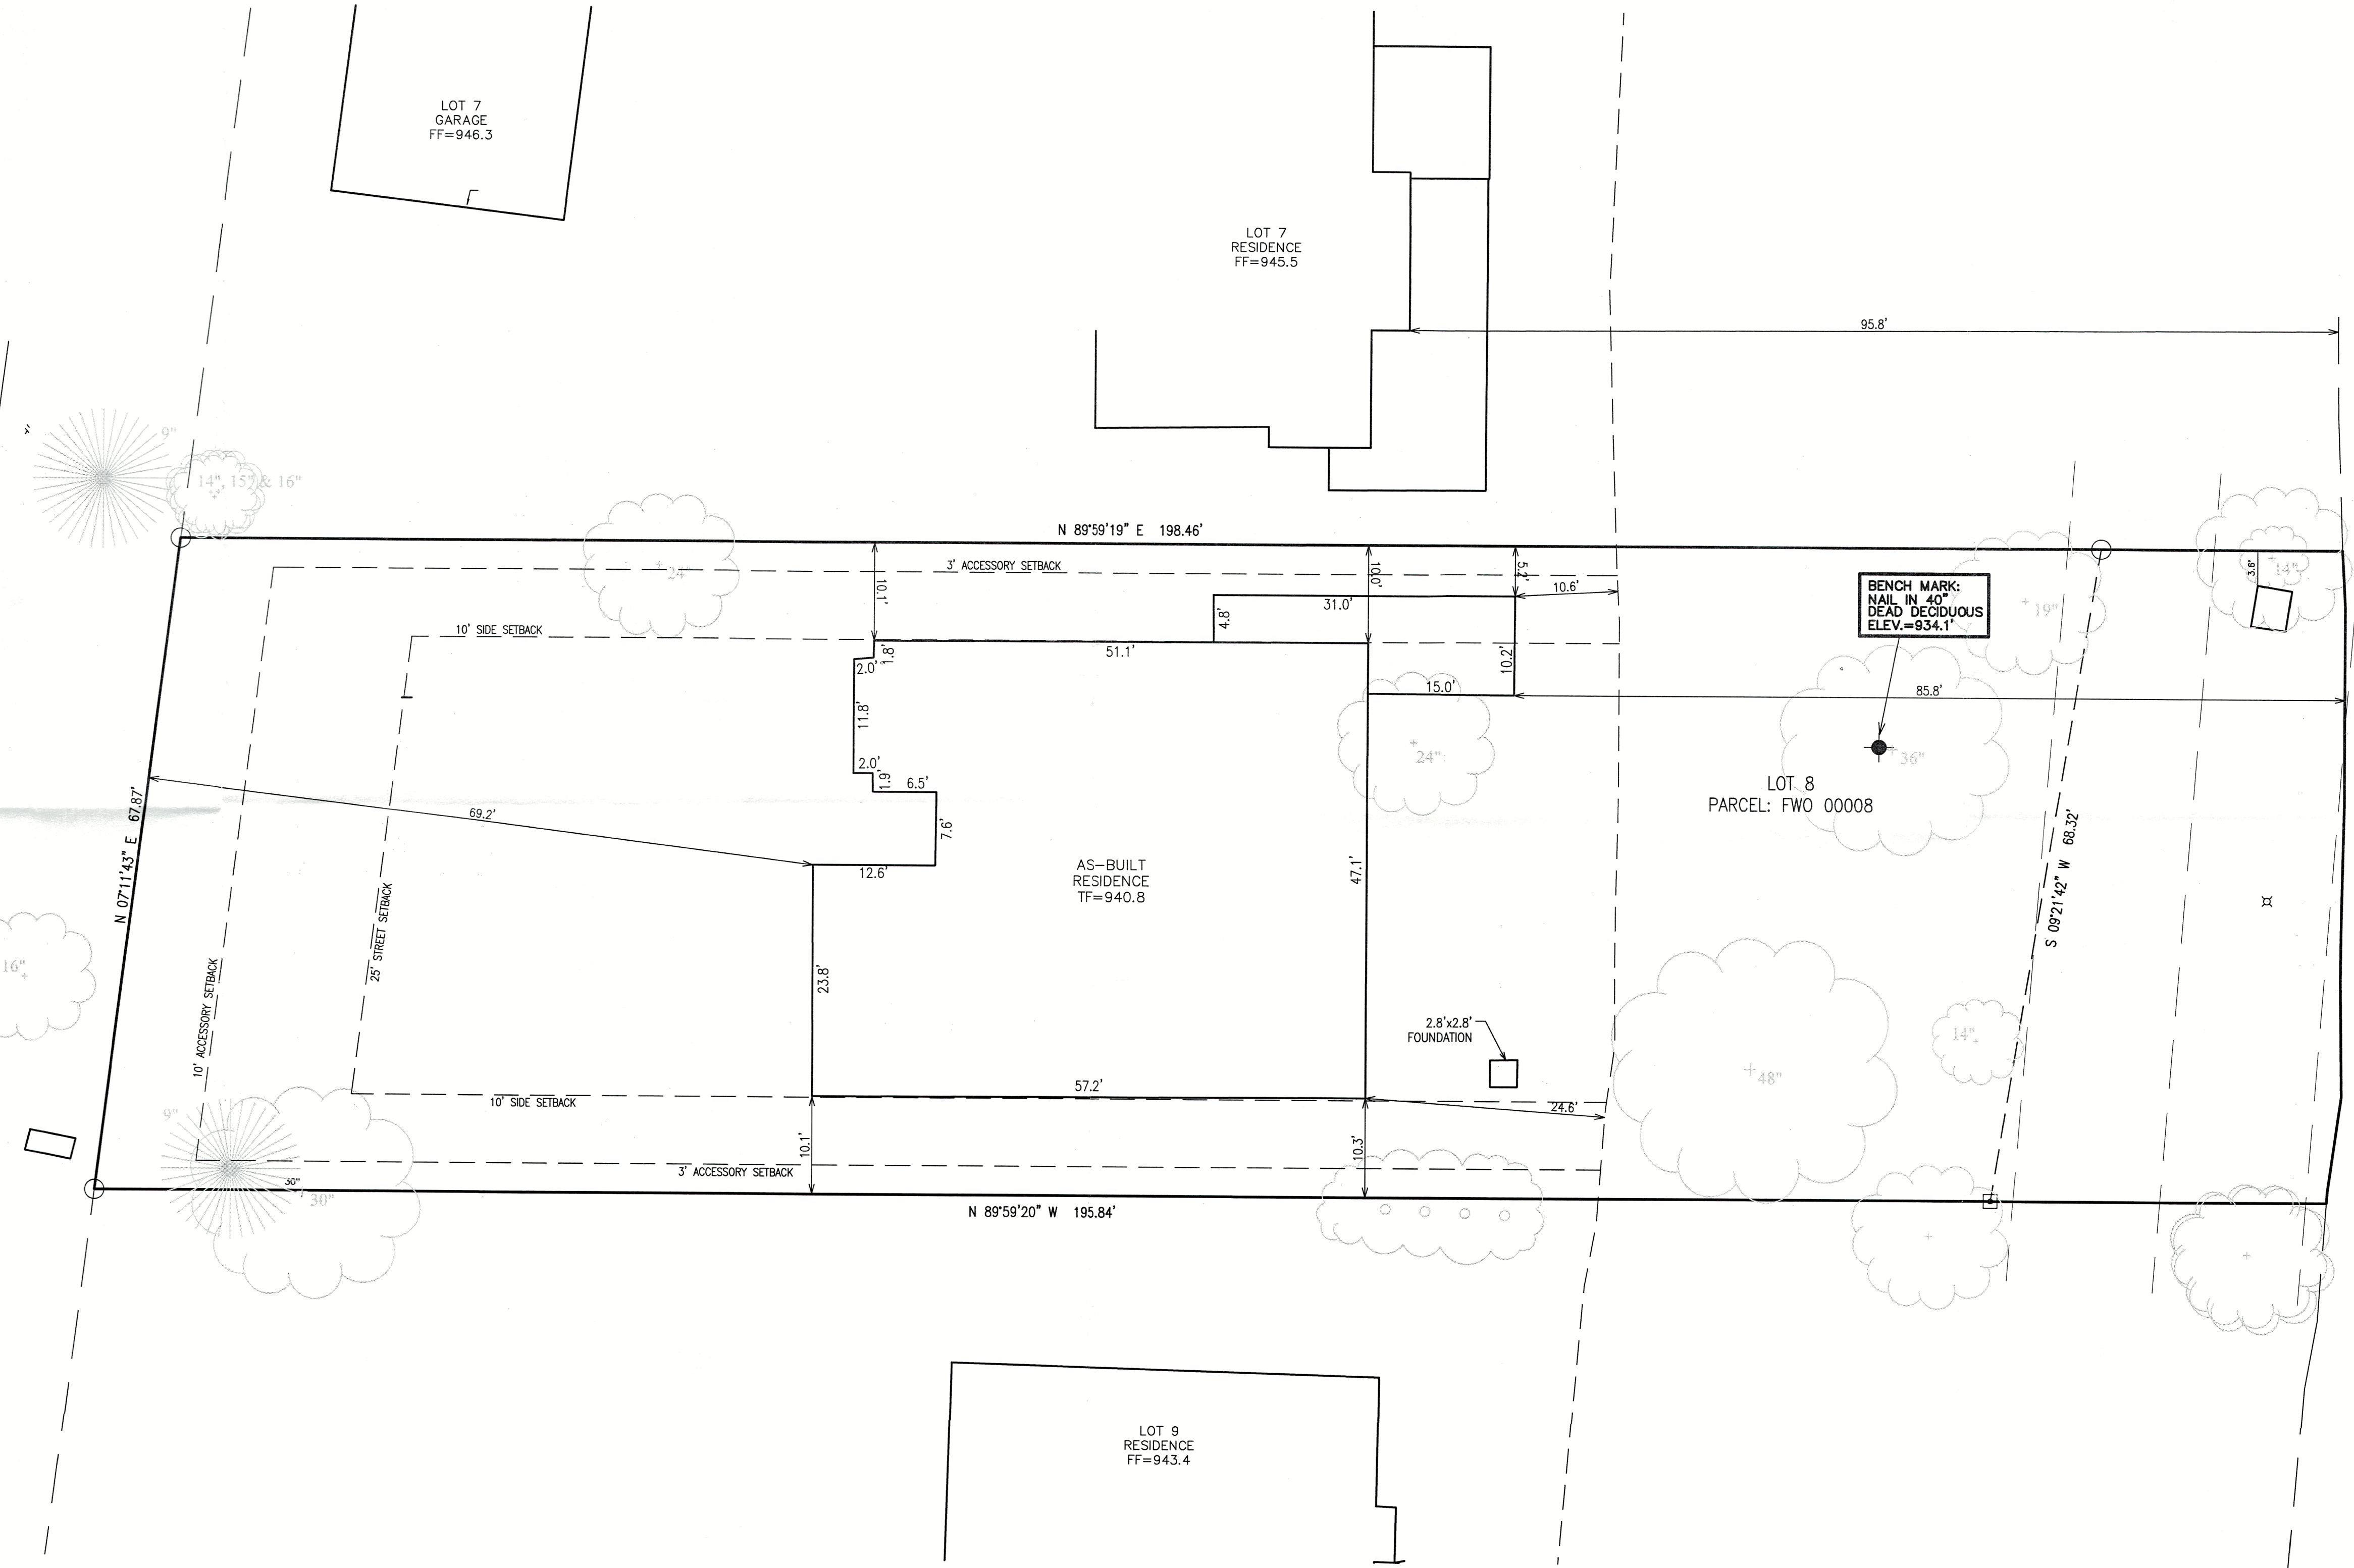


- LEGEND
- CONCRETE MONUMENT
 - IRON PIPE FOUND 1 3/8" O.D.
 - BENCHMARK
 - RECORDED AS
 - TOP OF FOUNDATION ELEVATION
 - FIRST FLOOR ELEVATION

NOTE: COPIES OF THIS MAP TO WHICH THE FOLLOWING CERTIFICATE WILL APPLY SHOW THE SURVEYOR'S ORIGINAL SEAL AND SIGNATURE IN RED INK. COPIES BY ANY OTHER MEANS MAY HAVE ALTERATIONS WHICH DO NOT REPRESENT THE SURVEYOR'S WORK PRODUCT.

I HEREBY CERTIFY THAT THE ABOVE DESCRIBED PROPERTY HAS BEEN SURVEYED UNDER MY DIRECTION AND THAT THE ABOVE MAP IS A TRUE REPRESENTATION THEREOF AND SHOWS THE SIZE AND LOCATION OF THE PROPERTY AND ITS EXTERIOR BOUNDARIES. THIS SURVEY IS MADE FOR THE USE OF THE PRESENT OWNERS OF THE PROPERTY, AND ALSO THOSE WHO PURCHASE, MORTGAGE, OR GUARANTEE THE TITLE THERETO WITHIN ONE YEAR FROM THE DATE HEREOF.

DATED: 2/01/2024

CHRISTOPHER A. HODGES P.L.S. 2760

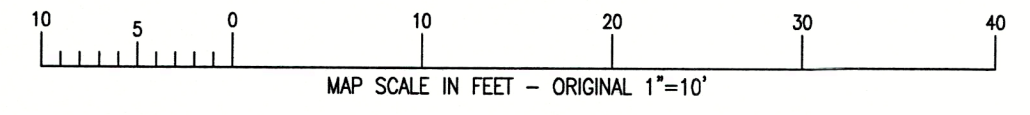

X:\Projects\10488\ACAD\10488-4 AsBuilt.dwg