




OAK AVE.

OAK

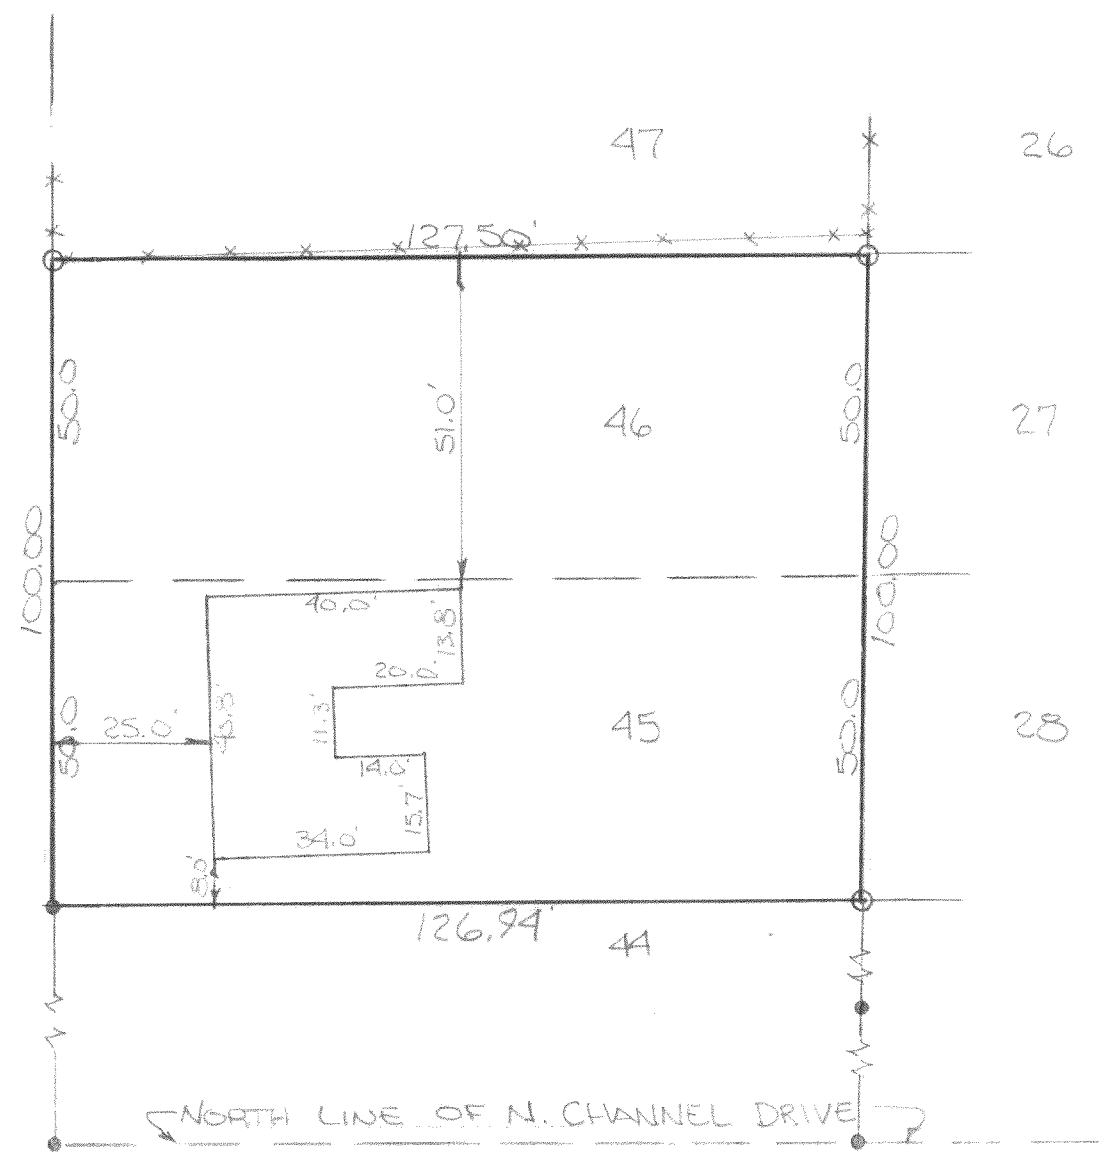

- - INDICATES IRON PIPE FOUND
- - INDICATES IRON PIPE SET
- × - INDICATES FENCE

DESCRIPTION:

Lots 45 & 46 of Lake Delavan Highlands, a subdivision located in the SE $\frac{1}{4}$ of Section 31, T2N, R16E, Walworth County, Wis.

CERTIFICATE:

I, Joseph M. Biagi, surveyor, do hereby certify that I have surveyed the property hereon described.

DATE:

February 13, 1973

Joseph M. Biagi

Joseph M. Biagi
Elkhorn, Wisconsin
RLS #12