
## PLAT OF SURVEY

Lots 31, and 32 of The Annex To Inlet Oaks, a subdivision located in the SE 1/4 of Section 15, and the NE 1/4 of Section 22, T 2 N, R 16 E, Town Of Delavan, Walworth County, Wisconsin.

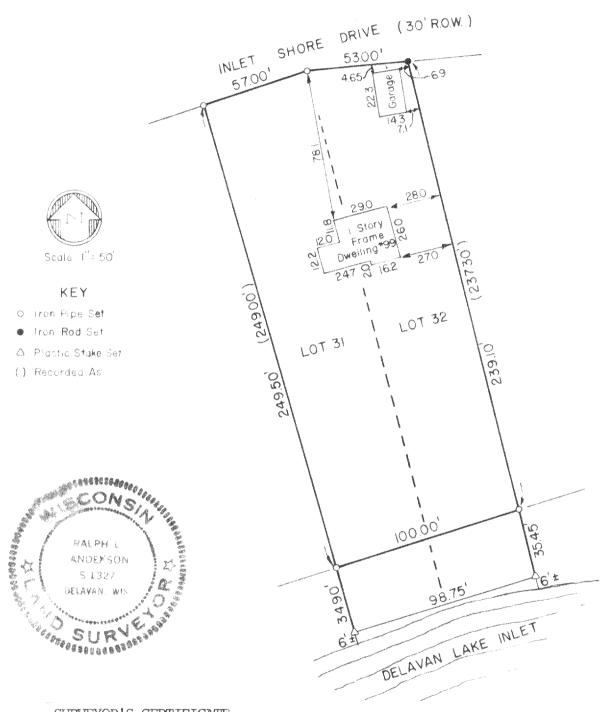

SURVEYOR'S CERTIFICATE

I have surveyed the above described property and the above map is a true representation thereof and shows the size and location of the property, its exterior boundaries, the location and dimensions of all visible structures thereon, fences, apparent easements and roadways and visible encroachments. This survey is made for the exclusive use of the present owners of the property, and also those who purchase, mortgage, or guarantee the title thereto within one (1) year from date hereof and as to them I warrant the accuracy of said survey and map.

Date 1977 Dalph J. Anderson, RLS 1327

F1A-24

Prepared By

VALENTINE AND ASSOCIATES, INC. DELAVAN, WISCONSIN

Prepared For

CHARLES SIANO
OAK LAWN, ILLINOIS

Date Sheet Number I of I

Job Number Reference file

016-614