
## PLAT OF SURVEY

FOR LOT 15 OF THE OAKS OF DELAVAN LAKE, A SUBDIVISON, AND BEING A PART OF THE SE 1/4 OF THE SOUTHWEST QUARTER OF SECTION 21, TOWN 2 NORTH, RANGE 16 EAST, TOWN OF DELAVAN, WALWORTH COUNTY, WISCONSIN.

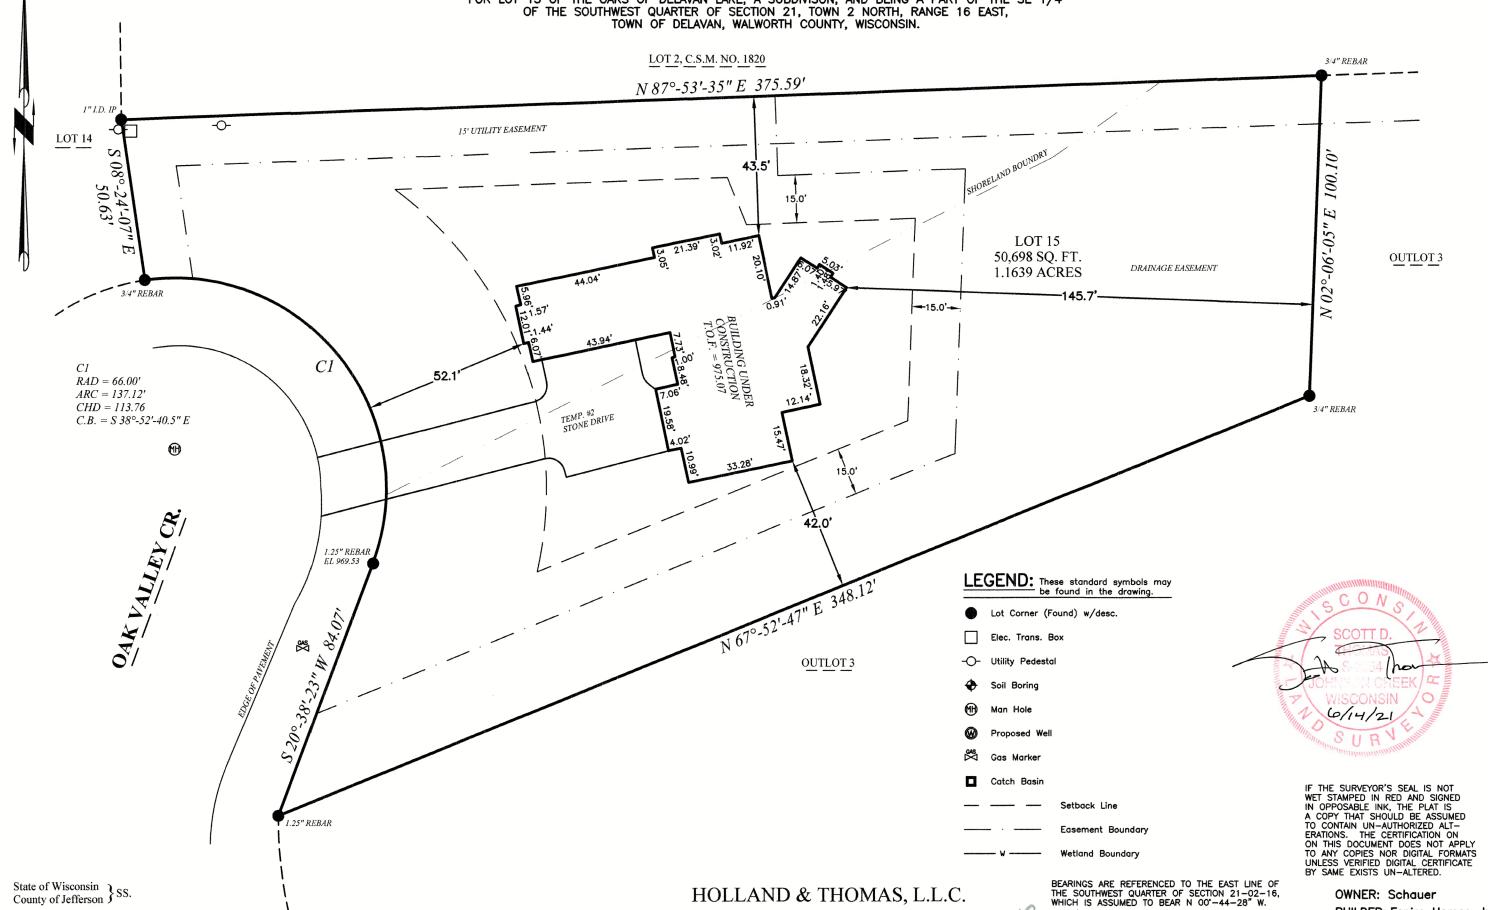

I, Scott D. Thomas, L.P.L.S., do hereby certify that I have made this survey and that the information as shown on the above Plat of Survey is a true and correct representation thereof. Lots are drawn from subdivision plats/C.S.M.s; unplatted lands from recorded deeds/surveys. Boundary survey plats reflect field-located information; consult a title attorney to discover all the legal encumberments attached to any property. 202 West Street Johnson Creek, WI 53038 (920) 699-3305

LAND SURVEYORS 216-6212

30' 30' **OWNER: Schauer** 

BUILDER: Espire Homes, Inc. 530 Hartbrook Dr. Hartland, WI 53029 Ph: (262) 746-2000