


PLAT OF SURVEY

OF PART OF THE N1/2 OF SEC. 31, T.2N, R.16E, OF THE 4TH
PRINCIPAL MERIDIAN, WALWORTH COUNTY, WISCONSIN

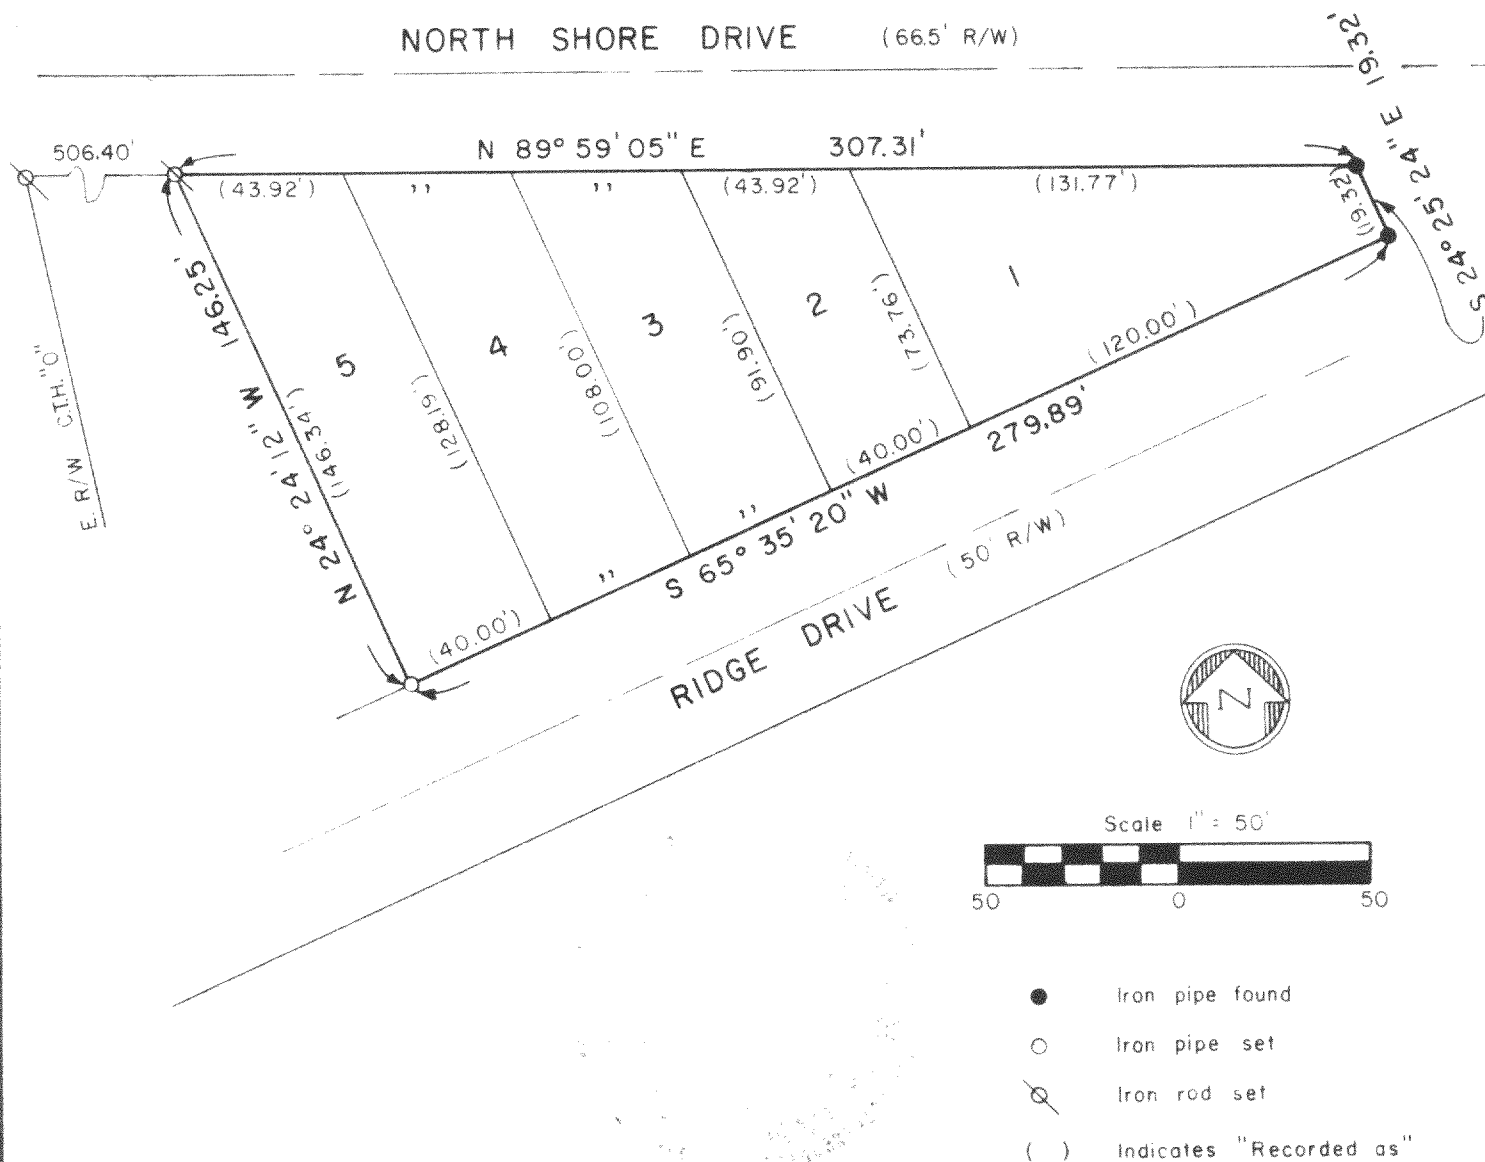

DESCRIPTION: Lots 1, 2, 3, 4 and 5 of Block 1 of Delavan

Lakeview Crest, a subdivision of part of the N 1/2 of Section 31, Township 2 North, Range 16 East, of the 4th Principal Meridian, Delavan Township, Walworth County, Wisconsin.

SURVEYOR'S CERTIFICATE: I hereby certify that I have surveyed the above described property and that the above map is a true representation thereof and shows the size and location of the property, its exterior boundaries, the location of all visible structures and dimensions of all principal buildings thereon, boundary fences, apparent easements, roadways and visible encroachments, if any. This survey is made for the use of the present owners of the property, and also those who purchase, mortgage, or guarantee the title thereto within one (1) year from date hereof.

February 2, 1979
Date

Dennis W. Valentine
Dennis W. Valentine, RLS S-1419

SURV.

FDLV-1

Prepared By VALENTINE AND ASSOCIATES, INC. DELAVAN, WISCONSIN	Prepared For DENNIS STONEWALL DELAVAN, WISCONSIN	Date 11/14/78	Sheet Number of
		Job Number 7827	Reference file

216-689