
DUNHAM SURVEYING, S.C.

SURVEYING & SUBDIVIDING
DELAVAN, WISCONSIN 53115

Center line of NORTH SHORE DRIVE

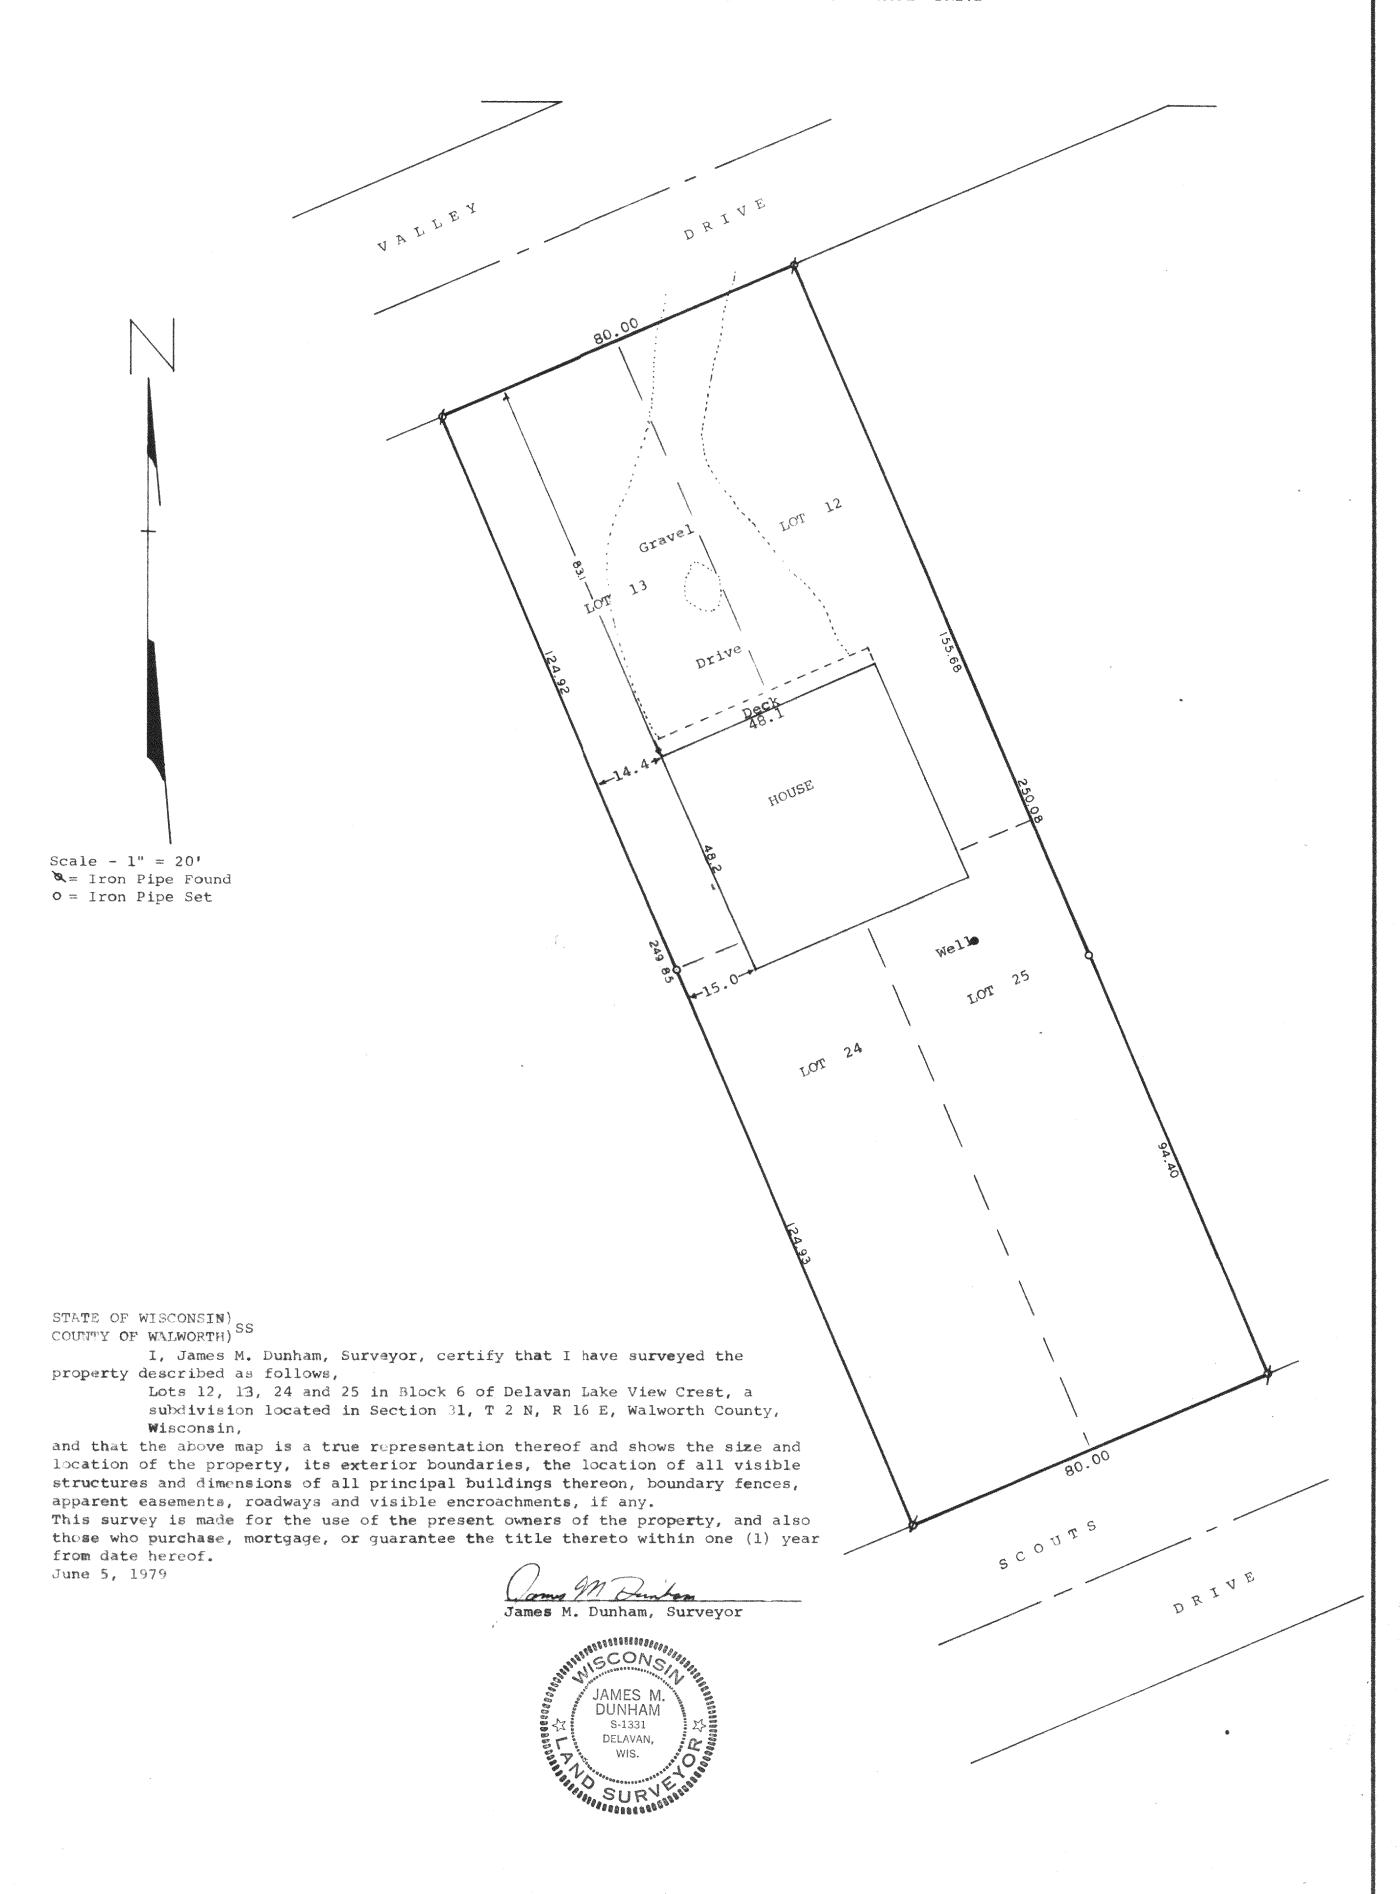

K & E 10-9155 250-9-76