
DUNHAM SURVEYING, S.C. SURVEYING & SUBDIVIDING DELAVAN, WISCONSIN 53115

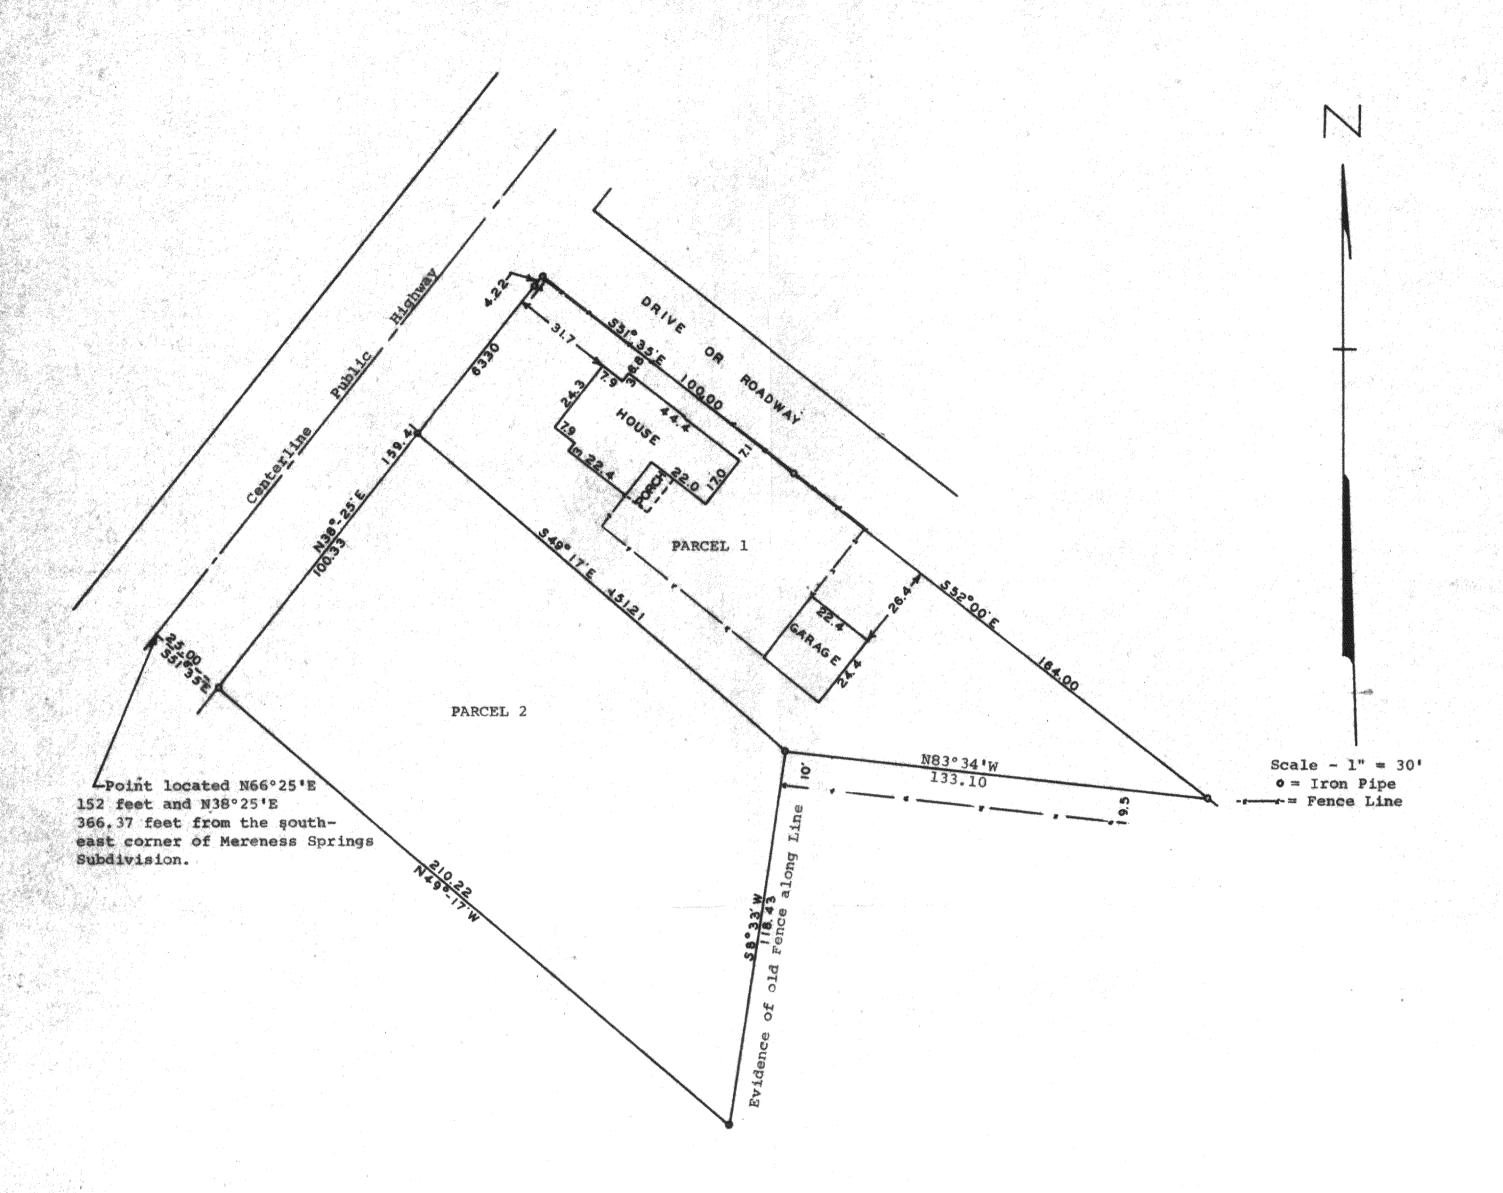

STATE OF WISCONSIN) SS COUNTY OF WALWORTH)

I, George T. Dunham, Surveyor, certify that I have surveyed the property described as follows:

Parcel 1 - A parcel of land located in the Southeast Fractional & of Fractional Section 22, T2N, R16E, Walworth County, Wisconsin, described as follows: Commencing at the southeast corner of Mereness Springs Subdivision; thence N66°25'E along a line which is the south line of said plat produced 152 feet to a point in the centerline of the public road; thence N38°25'E along said centerline 366.37 feet; thence S51°35'E 25.00 feet; thence N38°25'E along the edge of said road 100.33 feet to the place of beginning; thence continue N38°25'E along the edge of said road 63.30 feet; thence S51°35'E 100.00 feet; thence S52°00'E 164.00 feet; thence N83°34'W 133.10 feet; thence N49°17'W 151.21 feet to the place of beginning.

Parcel 2 - A parcel of land located in the Southeast Fractional & of Fractional Section 22, T2N, R16E, Walworth County, Wisconsin, described as follows: Commencing at the southeast corner of Mereness Springs Subdivision; thence N66°25'E along a line which is the south line of said plat produced 152 feet to a point in the centerline of the public road; thence N38°25'E along said centerline 366.37 feet; thence S51°35'E, 25.00 feet to an iron pipe And the place of beginning; thence N38°25'E along the edge of said road 100.33 feet; thence S49°17'E 151.21 feet; thence S8°33'W 118.43 feet; thence N49°17'W 210.22 feet to the place of beginning.

and that the above map is a true representation thereof and shows the size and location of the property, its exterior boundaries, the location of all visible structures and dimensions of all principal buildings thereon, boundary fences, apparent easements, roadways and visible encroachments, if any. This survey is made for the use of the present owners of the property, and also those who purchase, mortgage, or guarantee the title thereto within one (1) year from date hereof. June 2, 1980

George J. Dunham, Surveyor

DELAVAN, SURVENIES S