


DUNHAM SURVEYING, S.C.
SURVEYING & SUBDIVIDING
DELAVER, WISCONSIN 53115

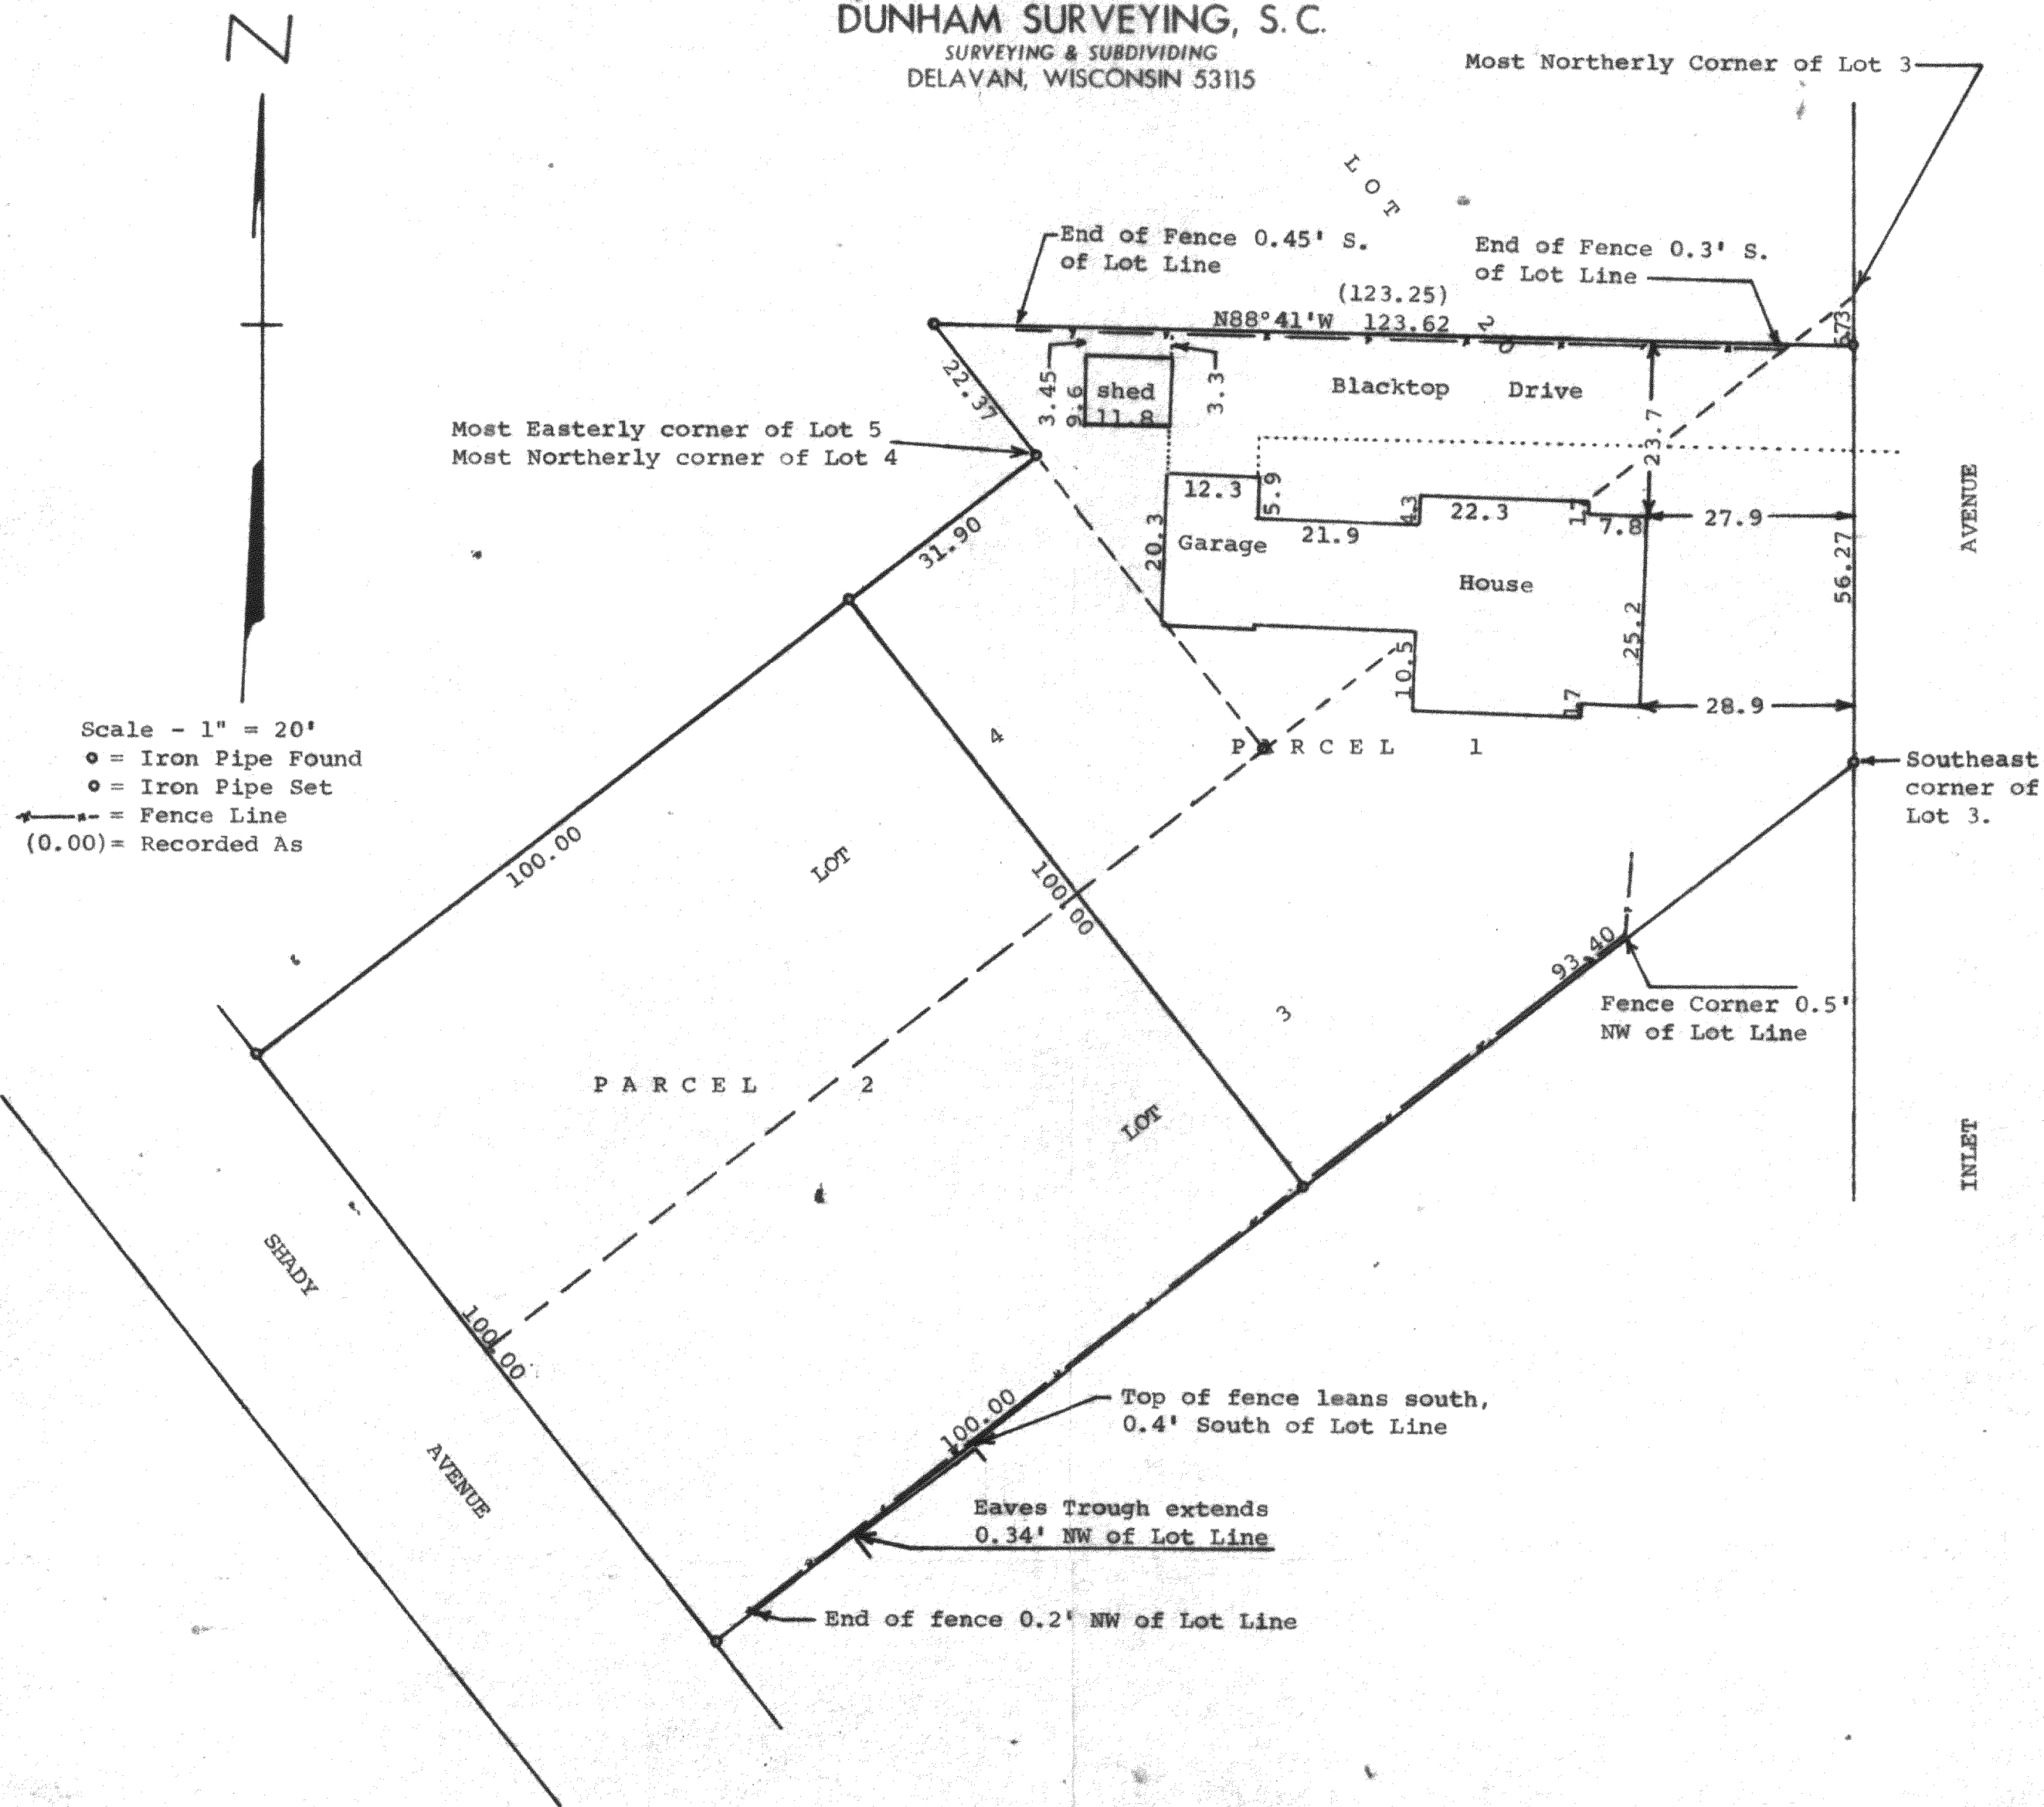

STATE OF WISCONSIN)
COUNTY OF WALWORTH) SS


I, George T. Dunham, Surveyor, certify that I have surveyed the property described as follows,

PARCEL 1: A part of Lots 3, 4 and 20, Block 3 of Inlet Oaks, a subdivision located in Section 22, T2N, R16E, Walworth County, Wisconsin, described as follows: Commencing at the most northerly corner of said Lot 3; thence South along the east line of said Lot 3, 6.73 feet to the place of beginning; thence N88°41'W 123.62 feet (recorded as 123.25 feet) to an iron pipe on the southwesterly line of said Lot 20 located 22.37 feet northwesterly of the most easterly corner of Lot 5 of said Block 3; thence Southeasterly 22.37 feet to the most northerly corner of said Lot 4; thence Southwesterly 31.90 feet to a point on the northwesterly line of said Lot 4 located 100.00 feet from the most westerly corner of said Lot 4; thence Southeasterly parallel with the southwesterly line of said Lots 3 and 4, 100.00 feet to the south-easterly line of said Lot 3; thence Northeasterly 93.40 feet to the south-easterly corner of said Lot 3; thence North along the easterly line of said Lot 3, 56.27 feet to the place of beginning. Separation of the above described parcel of land from the larger parcel is considered a lot line adjustment.

PARCEL 2: A part of Lots 3 and 4, Block 3 of Inlet Oaks, a subdivision located in Section 22, T2N, R16E, Walworth County, Wisconsin, described as follows: Beginning at the most westerly corner of said Lot 4; thence North-easterly along the northwesterly line of said Lot 4, 100.00 feet; thence South-easterly parallel with the southwesterly line of said Lots 3 and 4, 100.00 feet to the southeasterly line of said Lot 3; thence Southwesterly along said south-easterly line 100.00 feet; thence Northwesterly along the southwesterly line of said Lots 3 and 4, 100.00 feet to the place of beginning. Separation of the above described parcel of land from the larger parcel is considered a lot line adjustment.

and that the above map is a true representation thereof and shows the size and location of the property, its exterior boundaries, the location of all visible structures and dimensions of all principal buildings thereon, boundary fences, apparent easements, roadways and visible encroachments, if any. This survey is made for the use of the present owners of the property, and also those who purchase, mortgage, or guarantee the title thereto within one (1) year from date hereof.
August 4, 1980

George T. Dunham
George T. Dunham, Surveyor

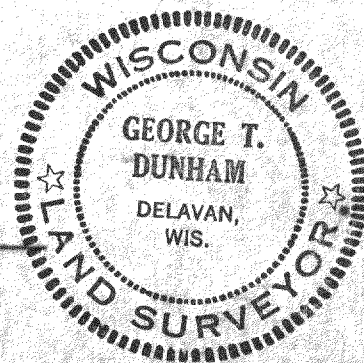

double check on map
FV-30, 30A, 31

FV-30, 30A, 31

216-718-D