


DUNHAM SURVEYING, S. C.
SURVEYING & SUBDIVIDING
DELAVAN, WISCONSIN 53115

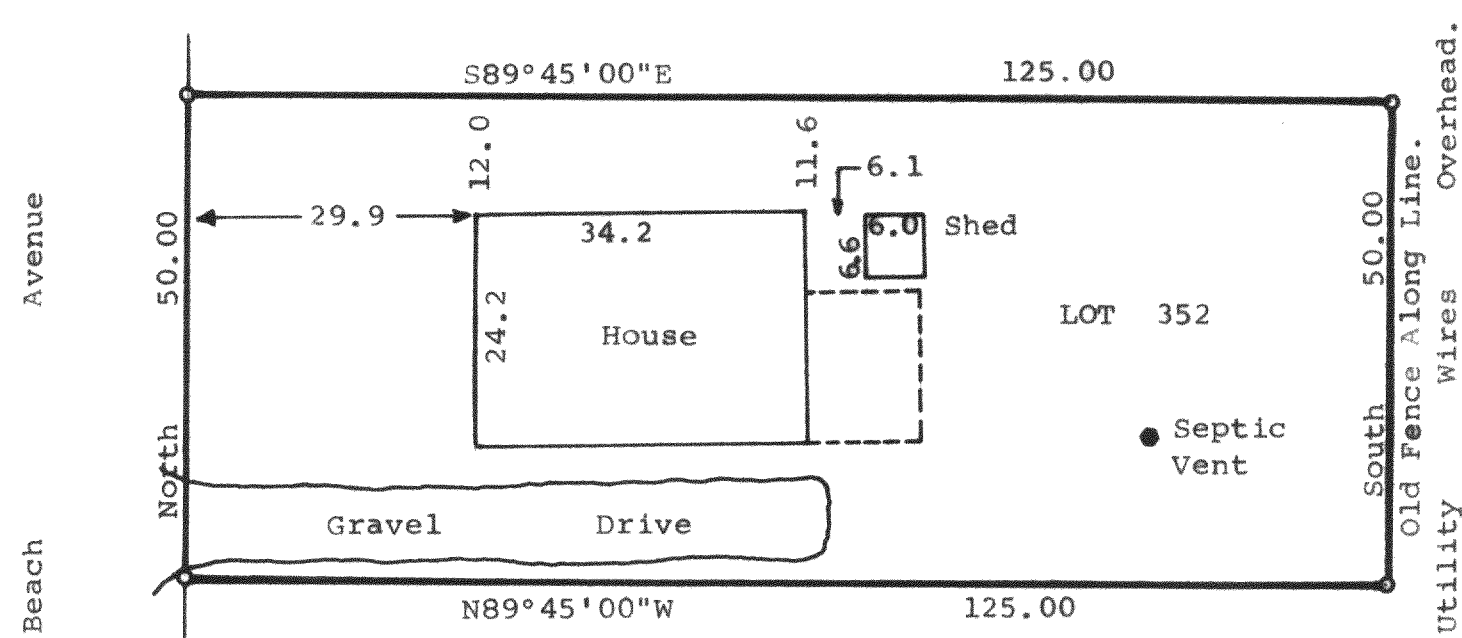

N

Scale - 1" = 20'
O = 3/4" Dia. Iron Pipe Found

Owner: William Carey
4108 Beach Avenue
Delavan, Wisconsin 53115
Note: Bearings are based on the East
line of Beach Avenue assumed
North-South.

STATE OF WISCONSIN)
COUNTY OF WALWORTH) SS

I, James M. Dunham, Surveyor, certify that I have surveyed
the property described as follows,

Lot 352 of Lake Delavan Highlands, a subdivision located in
the Southeast 1/4 of Section 31, T2N, R16E, Walworth County,
Wisconsin,

and that the above map is a true representation thereof and shows the
size and location of the property, its exterior boundaries, the location
of all visible structures and dimensions of all principal buildings
thereon, boundary fences, apparent easements, roadways and visible
encroachments, if any.

This survey is made for the use of the present owners of the property,
and also those who purchase, mortgage, or guarantee the title thereto
within one (1) year from date hereof.
July 7, 1982.

James M. Dunham
James M. Dunham, Surveyor

