


DUNHAM SURVEYING, S. C.
 SURVEYING & SUBDIVIDING
 DELAVAN, WISCONSIN 53115

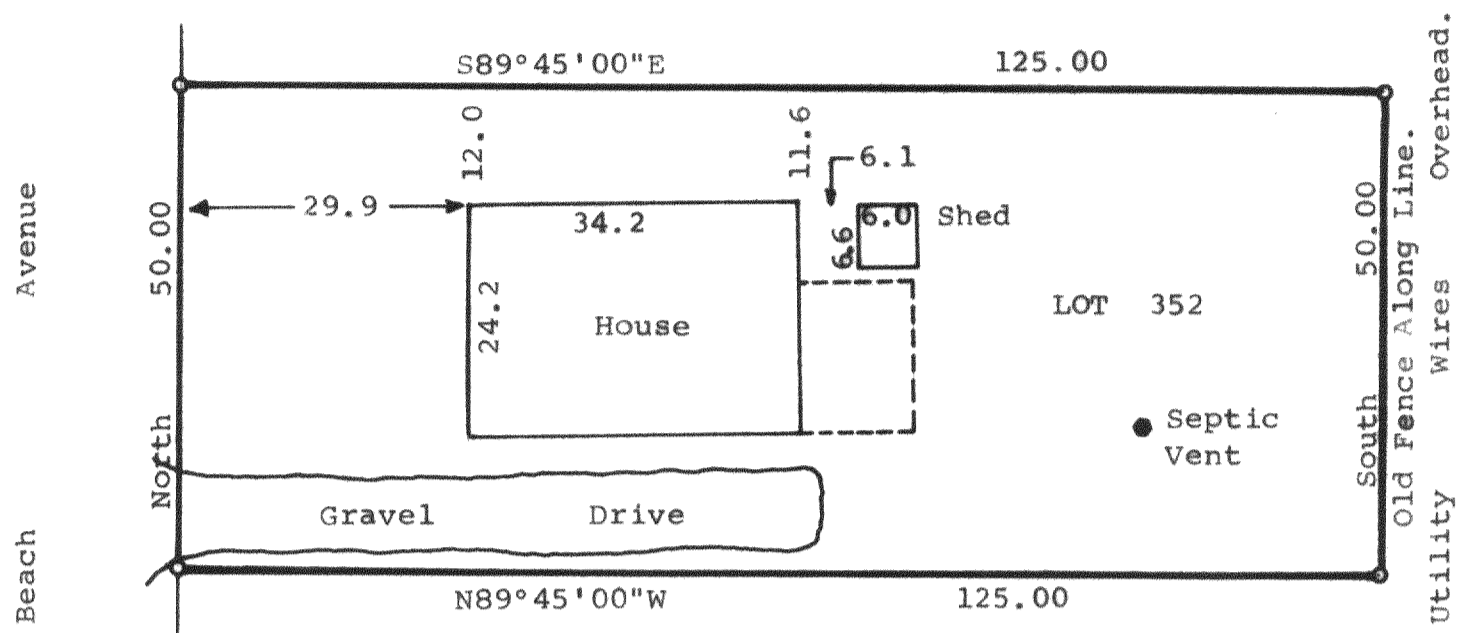

Scale - 1" = 20'
 O = 3/4" Dia. Iron Pipe Found

Owner: William Carey
 4108 Beach Avenue
 Delavan, Wisconsin 53115
 Note: Bearings are based on the East line of Beach Avenue assumed North-South.

STATE OF WISCONSIN)
 COUNTY OF WALWORTH) SS

I, James M. Dunham, Surveyor, certify that I have surveyed the property described as follows,

Lot 352 of Lake Delavan Highlands, a subdivision located in the Southeast 1/4 of Section 31, T2N, R16E, Walworth County, Wisconsin,

and that the above map is a true representation thereof and shows the size and location of the property, its exterior boundaries, the location of all visible structures and dimensions of all principal buildings thereon, boundary fences, apparent easements, roadways and visible encroachments, if any.

This survey is made for the use of the present owners of the property, and also those who purchase, mortgage, or guarantee the title thereto within one (1) year from date hereof.

July 7, 1982.

James M. Dunham
 James M. Dunham, Surveyor

