
## DUNHAM SURVEYING, S.C.

SURVEYING & SUBDIVIDING DELAVAN, WISCONSIN 53115



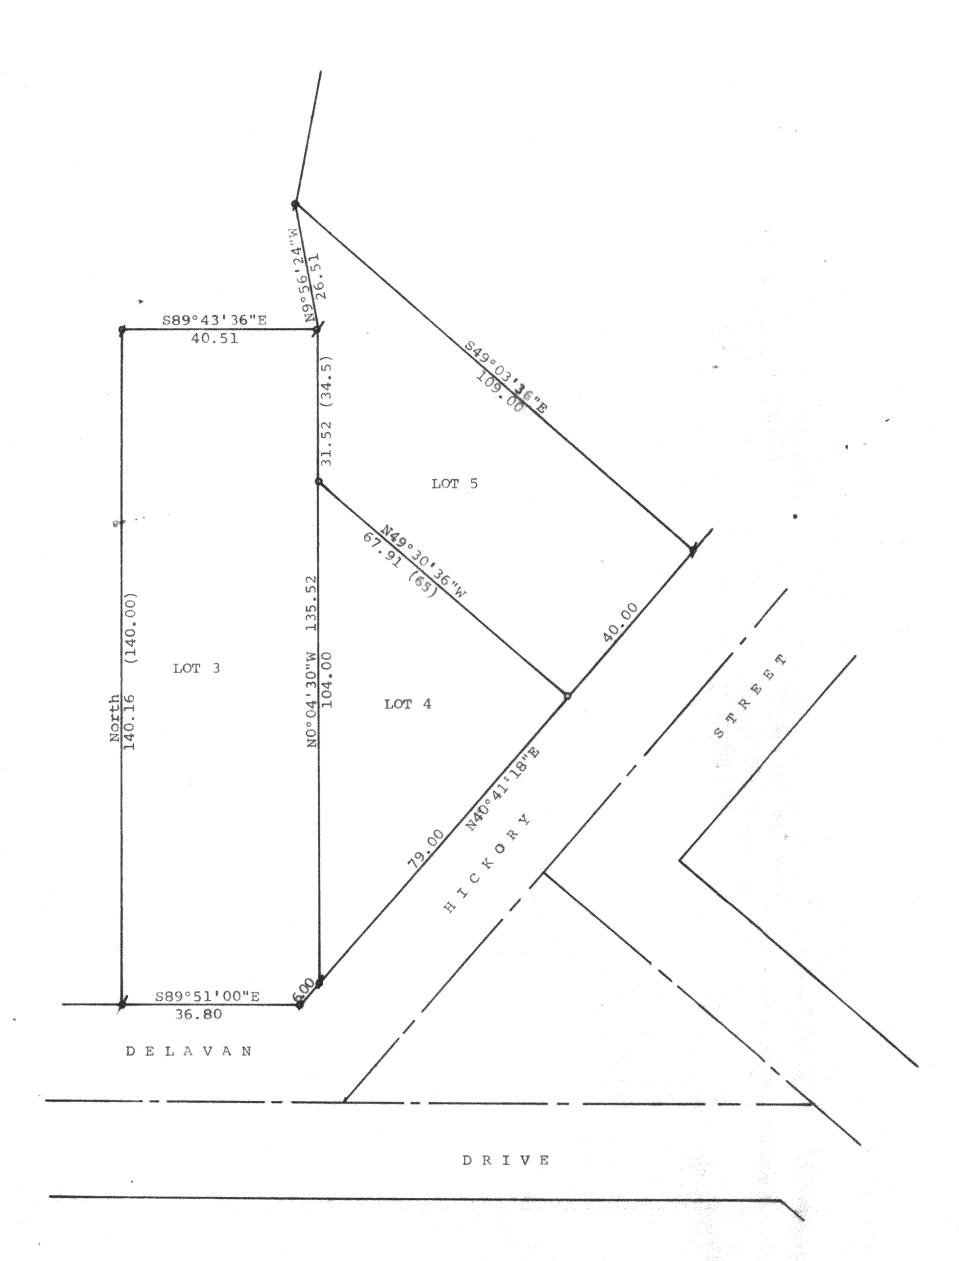

Scale -1" = 20"

o = Iron Pipe Set

Bearings referenced to the west line of

Lot 3. Assumed Bearing of North Owner: Patrick Sullivan

4524 West 99th Place

Oak Lawn, Illinois

STATE OF WISCONSIN) SS COUNTY OF WALWORTH)

I, George T. Dunham, Surveyor, certify that I have surveyed the

property described as follows:

Lot 3, 4, and 5 in Block 6, Inlet Oaks Subdivision No. 4 located in the Southeast Fractional % of Section 15, T 2 N, R 16 E, Walworth County, Wisconsin,


and that the above map is a true representation thereof and shows the size and location of the property, its exterior boundaries, the location of all visible structures and dimensions of all principal buildings thereon, boundary fences, apparent easements, roadways and visible

encroachments, if any. This survey is made for the use of the present owners of the property, and also those who purchase, mortgage, or guarantee the title thereto

within one (1) year from date hereof.

September 27, 1982

George T. Dunham, Surveyor

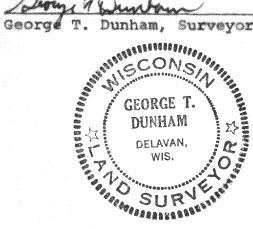

EINH-43