
DUNHAM SURVEYING, S.C. SURVEYING & SUBDIVIDING DELAYAN, WISCONSIN 53115

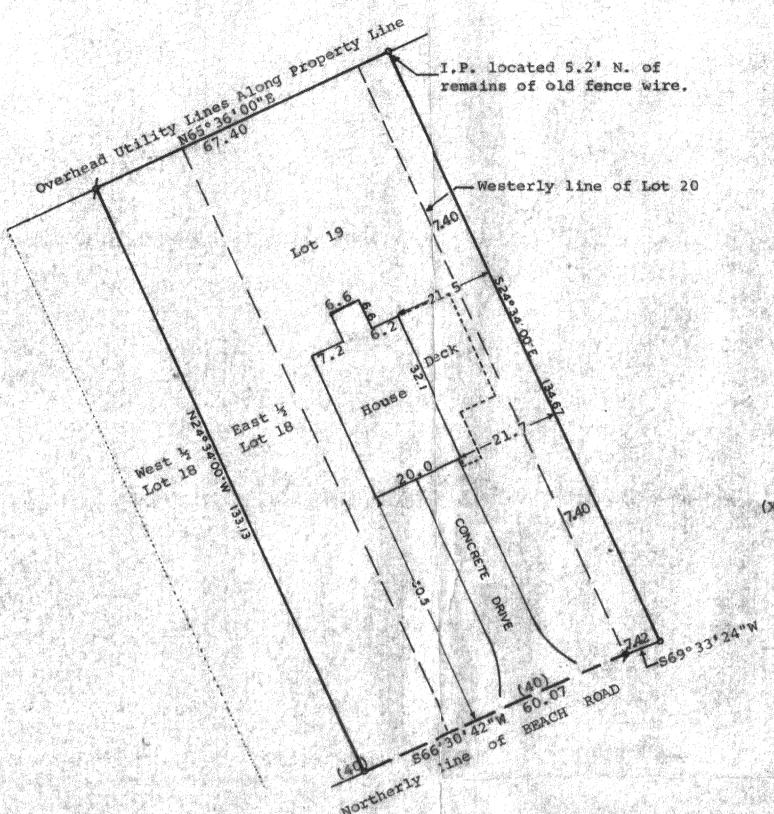

Scale - 1" = 20'

\$\mathcal{p}' = 3/4" Dia. Iron Pipe Found

\$\mathcal{o} = 1\mathcal{n}' Dia. Iron Pipe Found

\$\mathcal{p}' = 1\mathcal{n}'' Dia. Iron Pipe Found

(XX) = Recorded Distance

Bearings are referenced to the Northwesterly line of Lot 19. Assumed bearing is N65°36'00"w.

Ordered by: Keefe Real Estate, Inc.
Better Homes & Gardens
302 E. Walworth Ave.
Delavan, Wisconsin 53115

STATE OF WISCONSIN)

COUNTY OF WALWORTH) SIS

I, George T. Dunham, Surveyor, certify that I have surveyed the property described as follows,

The East 1/3 of Lot 18, Lot 19 and a strip of land 7.4 feet in width along the entire Westerly side of Lot 20, all in Block 18 of Delavan Take View Crest, a subdivision located in fractional Section 31, T 2 N, R 16 E, Walworth County, Wisconsin,

Section 31, T 2 N, R 16 E, Walworth County, Wisconsin, and that the above map is a true representation thereof and shows the size and location of the property, its exterior boundaries, the location of all visible structures and dimensions of all principal buildings thereon, boundary fences, apparent easements, roadways and visible encroachments, if any, and that I have surveyed the property hereon described according to the official records, to the best of my knowledge and belief.

March 28, 1983

George C. Dunham, Surveyor

