
DUNHAM SURVEYING, S.C. SURVEYING & SUBDIVIDING DELAVAN, WISCONSIN 53115

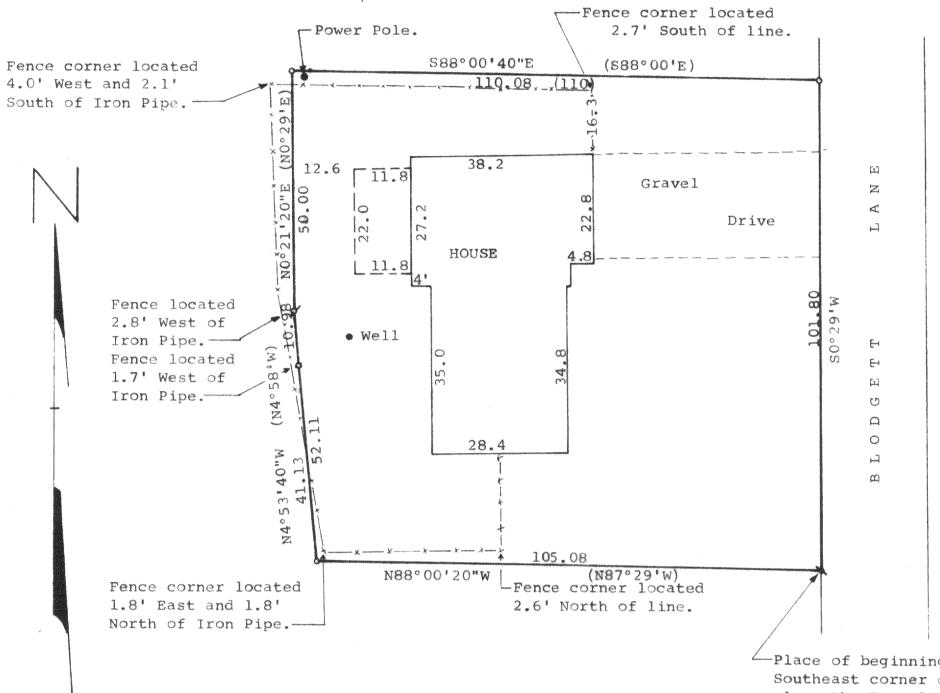

Place of beginning located by commencing at the Southeast corner of said Section 22; thence North along the East line of said section, 1274.34 feet; thence N85°40'W, 278.36 feet; thence S88°29'W, 50 feet; thence S0°29'W, 7.0 feet; thence S87°41'W, 132 feet; thence NO°29'E, 52.7 feet to the place of beginning.

ø = 3/4" Dia. Iron Pipe Found Bent and reset a = Found Iron Pipe Mark in Subsoil

o = 3/4" Dia. Iron Pipe Found

and l4"x24" Iron Pipe Set

(N00°00'W) = Recorded Bearing

Scale -1" = 20"

Bearings are referenced to the West line of Blodgett Lane, recorded bearing of S0°29'W. Owners: Kenneth Garecht

> Blodgett Lane Delavan, Wisconsin 53115

> > STATE OF WISCONSIN) COUNTY OF WALWORTH) SS

I, George T. Dunham, Surveyor, certify that I have surveyed

the property described as follows,

A parcel of land located in the Southeast Fractional & of Fractional Section 22, T2N, R16E, Walworth County, Wisconsin described as follows: Commencing at the Southeast corner of said Section 22; thence North along the East line of said Section, 1274.34 feet to a point; thence N85°40'W, 278.36 feet to a point; thence S88°29'W, 50 feet; thence S0°29'W, 7.0 feet; thence S87°41'W, 132 feet; thence N0°29'E, 52.7 feet to the place of beginning; thence N88°00'20"W (recorded as N87°29'W), 105.08 feet; thence N4°53'40"W (recorded as N4°58'W), 52.11 feet; thence N0°21'20"E (recorded as N0°29'E), 50.00 feet; thence S88°00'40"E, /110.08 feet (recorded, as S88°00'E, 110.00 feet); thence S0°29'W, 101.80 feet to the place of beginning.

and that the plat shown above is a true representation thereof and shows the size and location of the property, its exterior boundaries, the location of boundary fences, apparent easements, roadways and visible encroachments, if any, and that I have surveyed the property hereon described according to the official records to the best of my knowledge and belief.

March 27, 1984. George T. Dunham, Surveyor

