


DUNHAM SURVEYING, S.C.  
SURVEYING & SUBDIVIDING  
DELAVER, WISCONSIN 53115

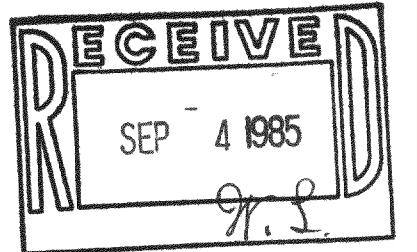


STATE OF WISCONSIN) SS  
COUNTY OF WALWORTH)

I, George T. Dunham, Surveyor, certify that I have surveyed the property described as follows,

Lots 23, 25, and 26 in Block 17 of Delavan Lake View Crest  
Subdivision, located in Section 31, T2N, R16E, Walworth  
County, Wisconsin,

and that the map shown above is a true representation thereof and shows the size and location of the property, its exterior boundaries, the location of all visible structures and dimensions of all principal buildings thereon, boundary fences, apparent easements, roadways and visible encroachments, if any and that I have surveyed the property hereon described according to the official records to the best of my knowledge and belief.  
March 29, 1985.

*George T. Dunham*  
George T. Dunham, Surveyor

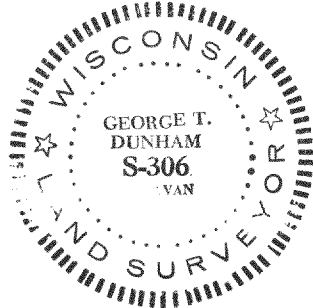

Scale - 1" = 20'  
X = 60 penny spike set on  
Northeast side of  
30" tree stump.  
X = 3/4" Dia. Iron Pipe  
Found.  
o = 1" Dia. Iron Pipe  
Found.  
(40) = Recorded Distance  
Bearings are based on the  
Northeasterly line of  
Highland Street, recorded  
bearing of N65°58'E.

Note: Iron Pipes found at the corners  
of the lots surveyed were set  
by Harold H. Kolb according to a  
survey dated May 12, 1971