
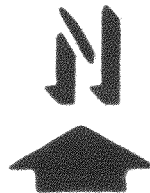


SHEET 1 OF 2 SHEETS
KOLB LAND CONSULTING, INC.
LAND SURVEYING • SUBDIVIDING • LAND PLANNING

929 WILLIAMS STREET

LAKE GENEVA, WISCONSIN 53147

414-248-3697

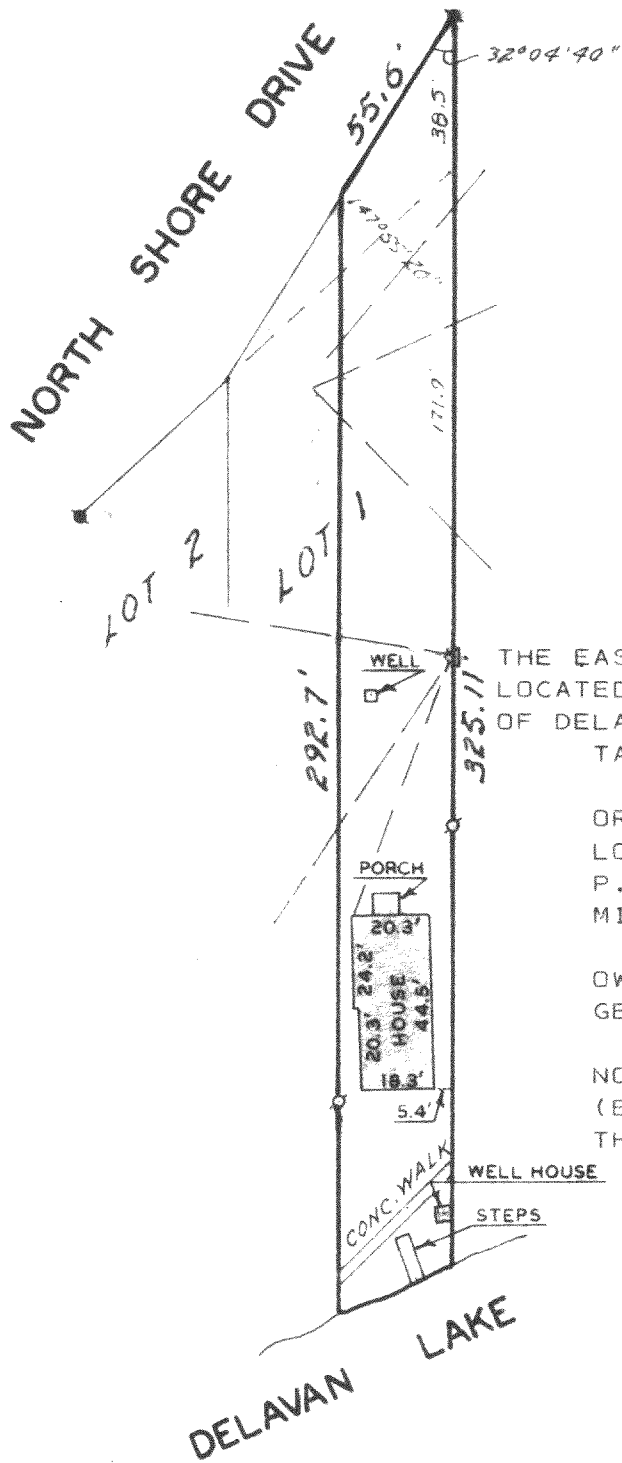

SCALE: 1" = 50'

LEGEND

- CONC. MONUMENT FOUND
- ⊘ IRON PIPE FOUND
- OVERHEAD UTILITY LINES
- ▽ UTILITY POLE

MORTGAGE INSPECTION OF

THE EAST 1/2 OF LOT 1, SIDON, A SUBDIVISION
LOCATED IN SECTION 28, T 2 N, R 16 E, TOWN
OF DELAVAN, WALWORTH COUNTY, WISCONSIN.

TAX PARCEL: FSI-1

ORDERED BY:
LOMUS-NETTLETON
P.O. BOX 28850
MILWAUKEE, WI. 53220

OWNER:
GERALD BOUCHARD

NOTE: COMPLIANCE WITH A-E3, 5(F), 6(A),
(B), (C), (D) AND 7 HAS BEEN WAIVED BY
THE CLIENT IN AGREEMENT WITH THE
SURVEYOR AS PERMITTED IN A-E5.01(B).

Harold H. Kolb

HAROLD H. KOLB
WISCONSIN REGISTERED LAND SURVEYOR, S-187
DATE APRIL 9, 1985
REVISED _____
REVISED _____

FSI-1

216-810-K