


RECEIVED
SEP 4 1985
J. S.



George T. Dunham
George T. Dunham, Surveyor

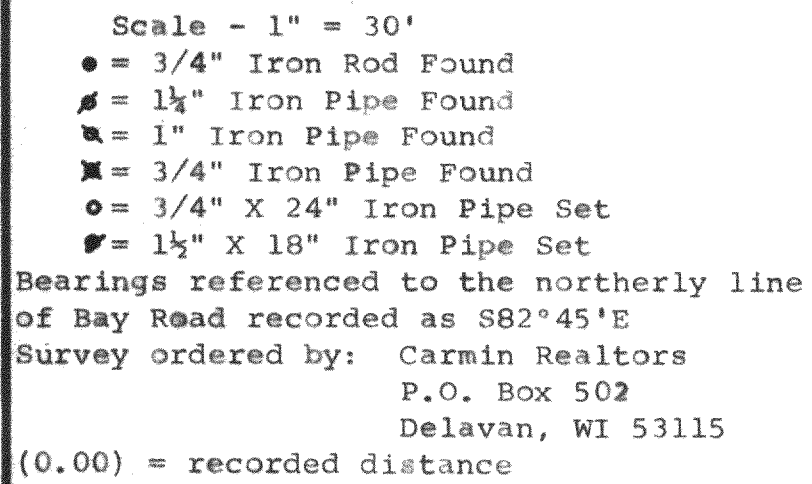