

RECEIVED
 SEP 30 1985
 gr. l.

KOLB LAND CONSULTING, INC.
 LAND SURVEYING • SUBDIVIDING • LAND PLANNING

LAKE GENEVA, WISCONSIN 53147

Found Spike SW Corner
 Section 30-2-16

Found Witness Monument 155' North of
 SE Corner Section 30-2-16 By Ties

NORTH SHORE DRIVE

N 88° 19' 50" E

S 1° 13' 25" E 155'

4715.02'

100.00'

(400')

399.70'

25.00'

25.00'

1109.49'

799.69'

N 1° 46' 55" W

2

E 10' Wide Drive

3

1087.12'

854.12'

S 1° 46' 55" E

Garage

Shed

37.2'
 House

S 71° 42' 20" W 62.55'

92.00'

S 67° 03' 10" W 42.93'

80.8'

102'

DELAVAN LAKE

PLAT OF SURVEY OF

LOT 2 OF ARNOLD'S WOODS, LOCATED IN THE NORTH-EAST 1/4 OF SECTION 31, TOWN 2 NORTH, RANGE 16 EAST, WALWORTH COUNTY, WISCONSIN, CONTAINING 2.52 ACRES, MORE OR LESS.

ORDERED BY: MATT BRANDER
 FOR: RICHARD L. CORWIN
 811 W. HILLGROVE AVE.
 LAGRANGE, IL 60525

NOTE: BEARINGS ARE TIED TO THE WISCONSIN COORDINATE SYSTEM - SOUTH ZONE.




SCALE - 1"=100'

LEGEND

- - IRON PIPE SET
- - CONCRETE MONUMENT FOUND
- () - RECORDED AS

I HEREBY CERTIFY THAT I HAVE SURVEYED THE ABOVE DESCRIBED PROPERTY AND THAT THE ABOVE MAP IS A TRUE REPRESENTATION THEREOF AND SHOWS THE SIZE AND LOCATION OF THE PROPERTY, ITS EXTERIOR BOUNDARIES, THE LOCATION OF ALL VISIBLE STRUCTURES AND PRINCIPAL DIMENSIONS OF ALL PRINCIPAL BUILDINGS THEREON, BOUNDARY FENCES, APPARENT EASEMENTS, ROADWAYS AND VISIBLE ENCROACHMENTS, IF ANY, TO THE BEST OF MY KNOWLEDGE AND BELIEF. THIS SURVEY IS MADE FOR THE USE OF THE PRESENT OWNERS OF THE PROPERTY, AND ALSO THOSE WHO PURCHASE, MORTGAGE, OR GUARANTEE THE TITLE THERETO WITHIN ONE (1) YEAR FROM DATE HEREOF.

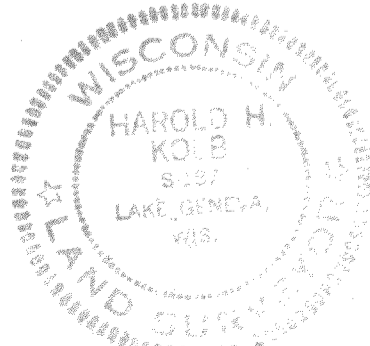

Harold H. Kolb
 HAROLD H. KOLB
 WISCONSIN REGISTERED LAND SURVEYOR, S-187
 DATE January 30, 1985

FAW-2

216-812-R