
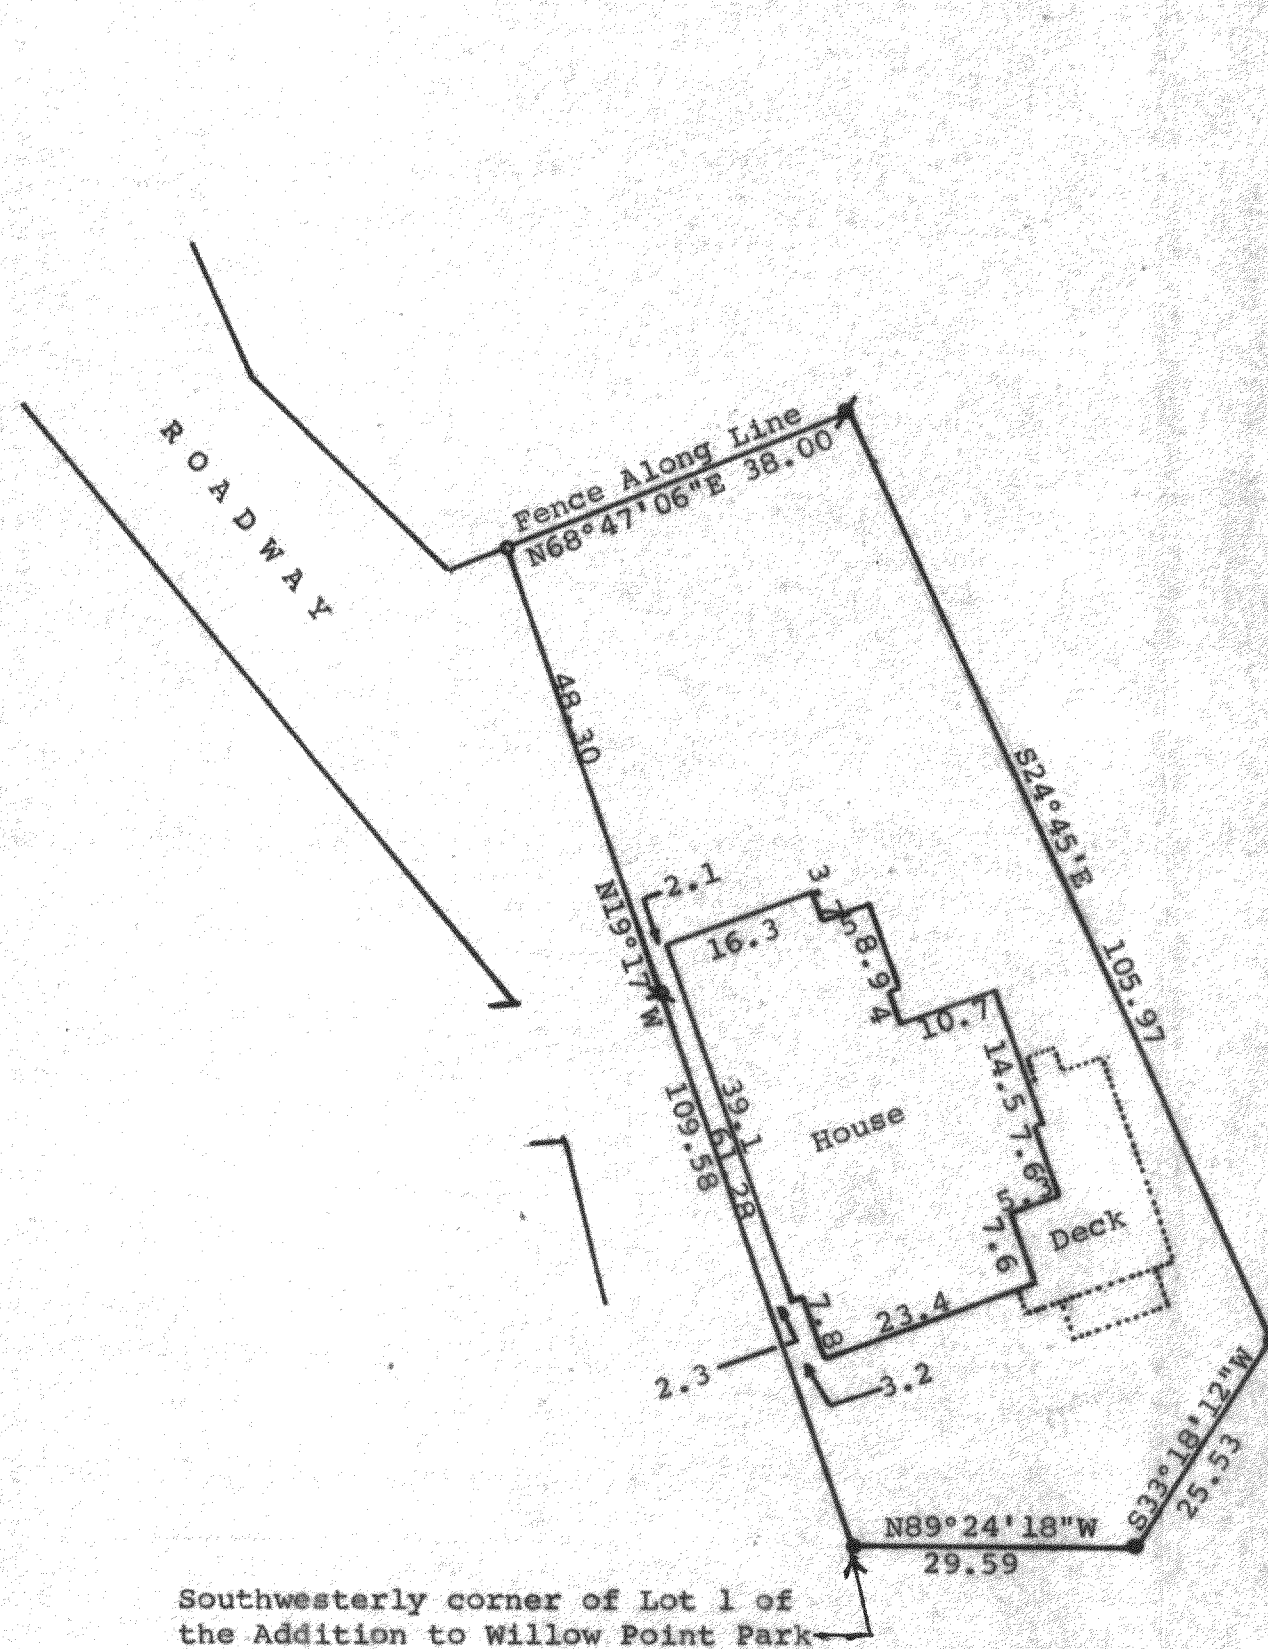


DUNHAM SURVEYING, S.C.
SURVEYING & SUBDIVIDING
DELAVAN, WISCONSIN 53115

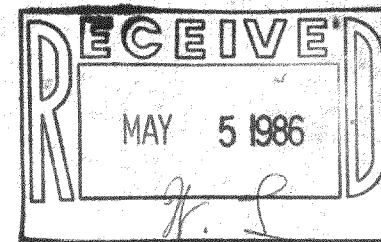

N

Scale - 1" = 20'

- = Concrete Monument Found
- = 1" Iron Pipe Found
- ◐ = 3/4" Iron Pipe Found
- ◑ = 1/2" Iron Pipe Found

Bearings referenced to the assumed bearing of
N19°17'W along the easterly line of the roadway
Survey ordered by: Lyons Mortgage Corp.
933 Mayfair Road
Milwaukee, WI 53226

STATE OF WISCONSIN) ss
COUNTY OF WALWORTH)

I, George T. Dunham, Surveyor, certify that I have surveyed the
property described as follows:

A part of Lot 1 of the Addition to Willow Point Park located in
Section 29, T 2 N, R 16 E, Walworth County, Wisconsin, described
as follows: Beginning at a point on the westerly line of said lot,
which point is 109.58 feet (recorded as 109 feet) northwesterly of
the southwesterly corner of said lot; thence southeasterly along
the westerly line of said lot 109.58 feet to the southwesterly corner
thereof; thence Easterly 29.59 feet (recorded as 28'8"), along the
southerly line of said lot to a concrete monument; thence north-
easterly 25.53 feet (recorded as 25 feet) to a concrete monument at
the southeasterly corner of said Lot 1; thence Northwesterly along the
easterly line of said lot 105.97 feet (recorded as 106 feet) to a
point; thence westerly 38.00 feet to the place of beginning.

and that the map shown above is a true representation thereof and shows the size
and location of the property, its exterior boundaries, the location of all visible
structures and dimensions of all principal buildings thereon, boundary fences,
apparent easements, roadways and visible encroachments, if any, and that I have
surveyed the property hereon described according to the official records to the
best of my knowledge and belief.
October 11, 1985

George T. Dunham
George T. Dunham, Surveyor

