


DUNHAM SURVEYING, S.C.
SURVEYING & SUBDIVIDING
DELAVAN, WISCONSIN 53115

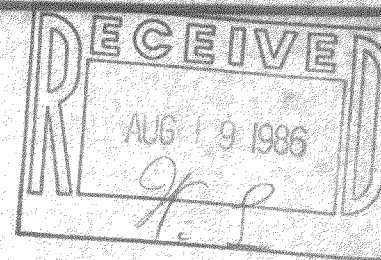

HICKORY

COURT

N

Utility Pole

LOT 25

EAST
107.25

Gravel Drive
Entrance


STATE OF WISCONSIN)
COUNTY OF WALWORTH)

I, George T. Dunham, Surveyor, certify that I have surveyed the property described as follows:

Lot 25 in Elkwood, a subdivision located in the Northeast 1/4 of the Northeast 1/4 of Section 13, T 2 N, R 16 E, Walworth County, Wisconsin,

and that the map shown hereon is a correct representation thereof and shows the size and location of the property, its exterior boundaries, the location of all visible structures and dimensions of all principal buildings thereon, boundary fences, apparent easements, roadways and visible encroachments, if any, and that I have surveyed the property hereon described according to the official records, to the best of my knowledge and belief.
September 26, 1985

George T. Dunham
George T. Dunham, Surveyor

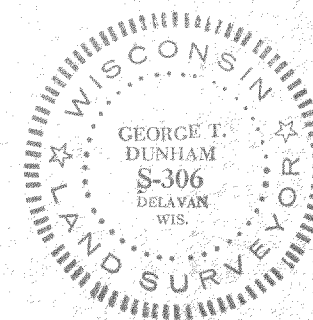

Scale - 1" = 30'

- = 1" Iron Pipe Found
- ◐ = 1" Iron Pipe Found Bent
- ✕ = Iron Pipe Mark found in dirt & 1" X 24" iron pipe set
- = farm fence line

Bearings used are those shown on the recorded plat of the subdivision Survey ordered by:

Keefe Real Estate, Better Homes & Gardens

302 East Walworth Avenue

Delavan, WI 53115

✕ = 1/2" X 24" Iron Pipe Set

