



DUNHAM SURVEYING, S. C.
 SURVEYING & SUBDIVIDING
 DELAVAN, WISCONSIN 53115

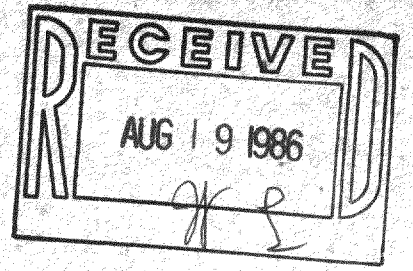

Scale - 1" = 30'
 ● = 1" Iron Rod Found
 ■ = 2" Iron Pipe Found
 ▨ = 1 1/2" Iron Pipe Found
 ▲ = 1" Iron Pipe Found
 ○ = 1/2" Iron Pipe Set
 (0.00) = recorded distance
 Bearings referenced to the assumed
 bearing of East along the south line
 of the roadway
 Owner: Ernest J. Cwik
 2814 Willow Point Drive
 Delavan, WI 53115

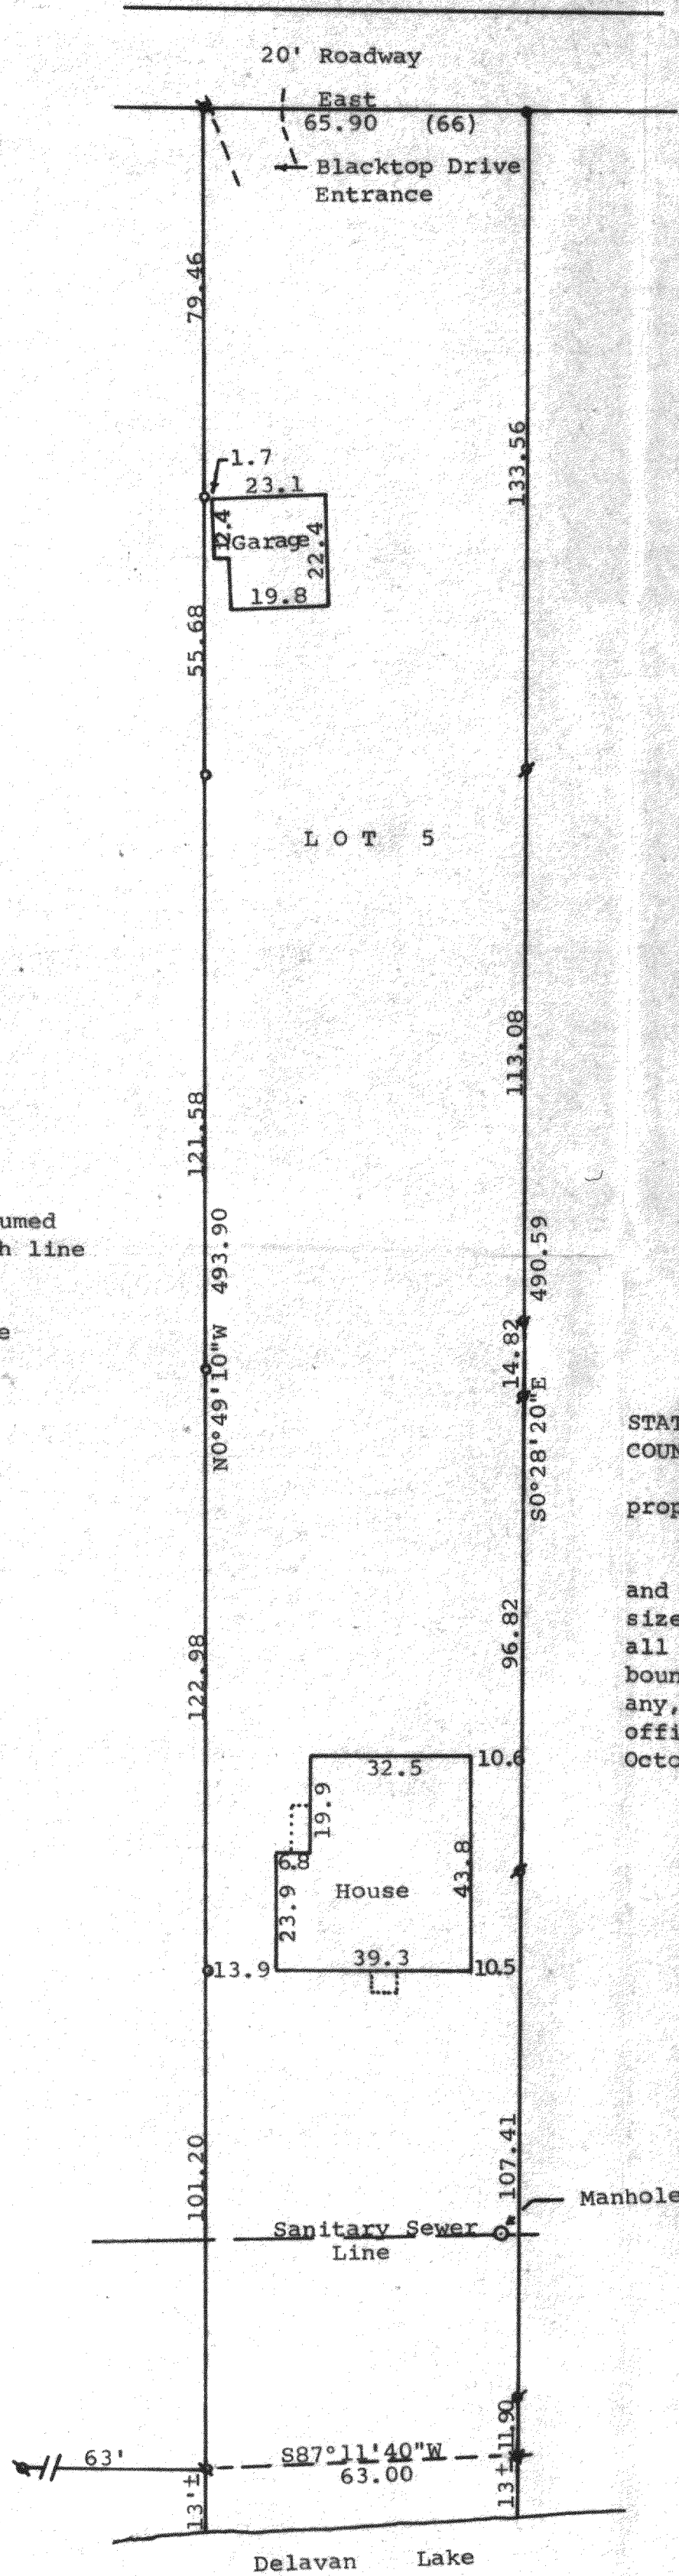

STATE OF WISCONSIN)
 COUNTY OF WALWORTH) SS

I, George T. Dunham, Surveyor, certify that I have surveyed the property described as follows:
 Lot 5 of the Hamlet of Bon Secour, located in Section 29, T 2 N, R 16 E, Walworth County, Wisconsin,
 and that the plat shown hereon is a true representation thereof and shows the size and location of the property, its exterior boundaries, the location of all visible structures and dimensions of all principal buildings thereon, boundary fences, apparent easements, roadways and visible encroachments, if any, and that I have surveyed the property hereon described according to the official records to the best of my knowledge and belief.
 October 20, 1984

George T. Dunham
 George T. Dunham, Surveyor

