



DUNHAM SURVEYING, S. C.  
 SURVEYING & SUBDIVIDING  
 DELAVAN, WISCONSIN 53115

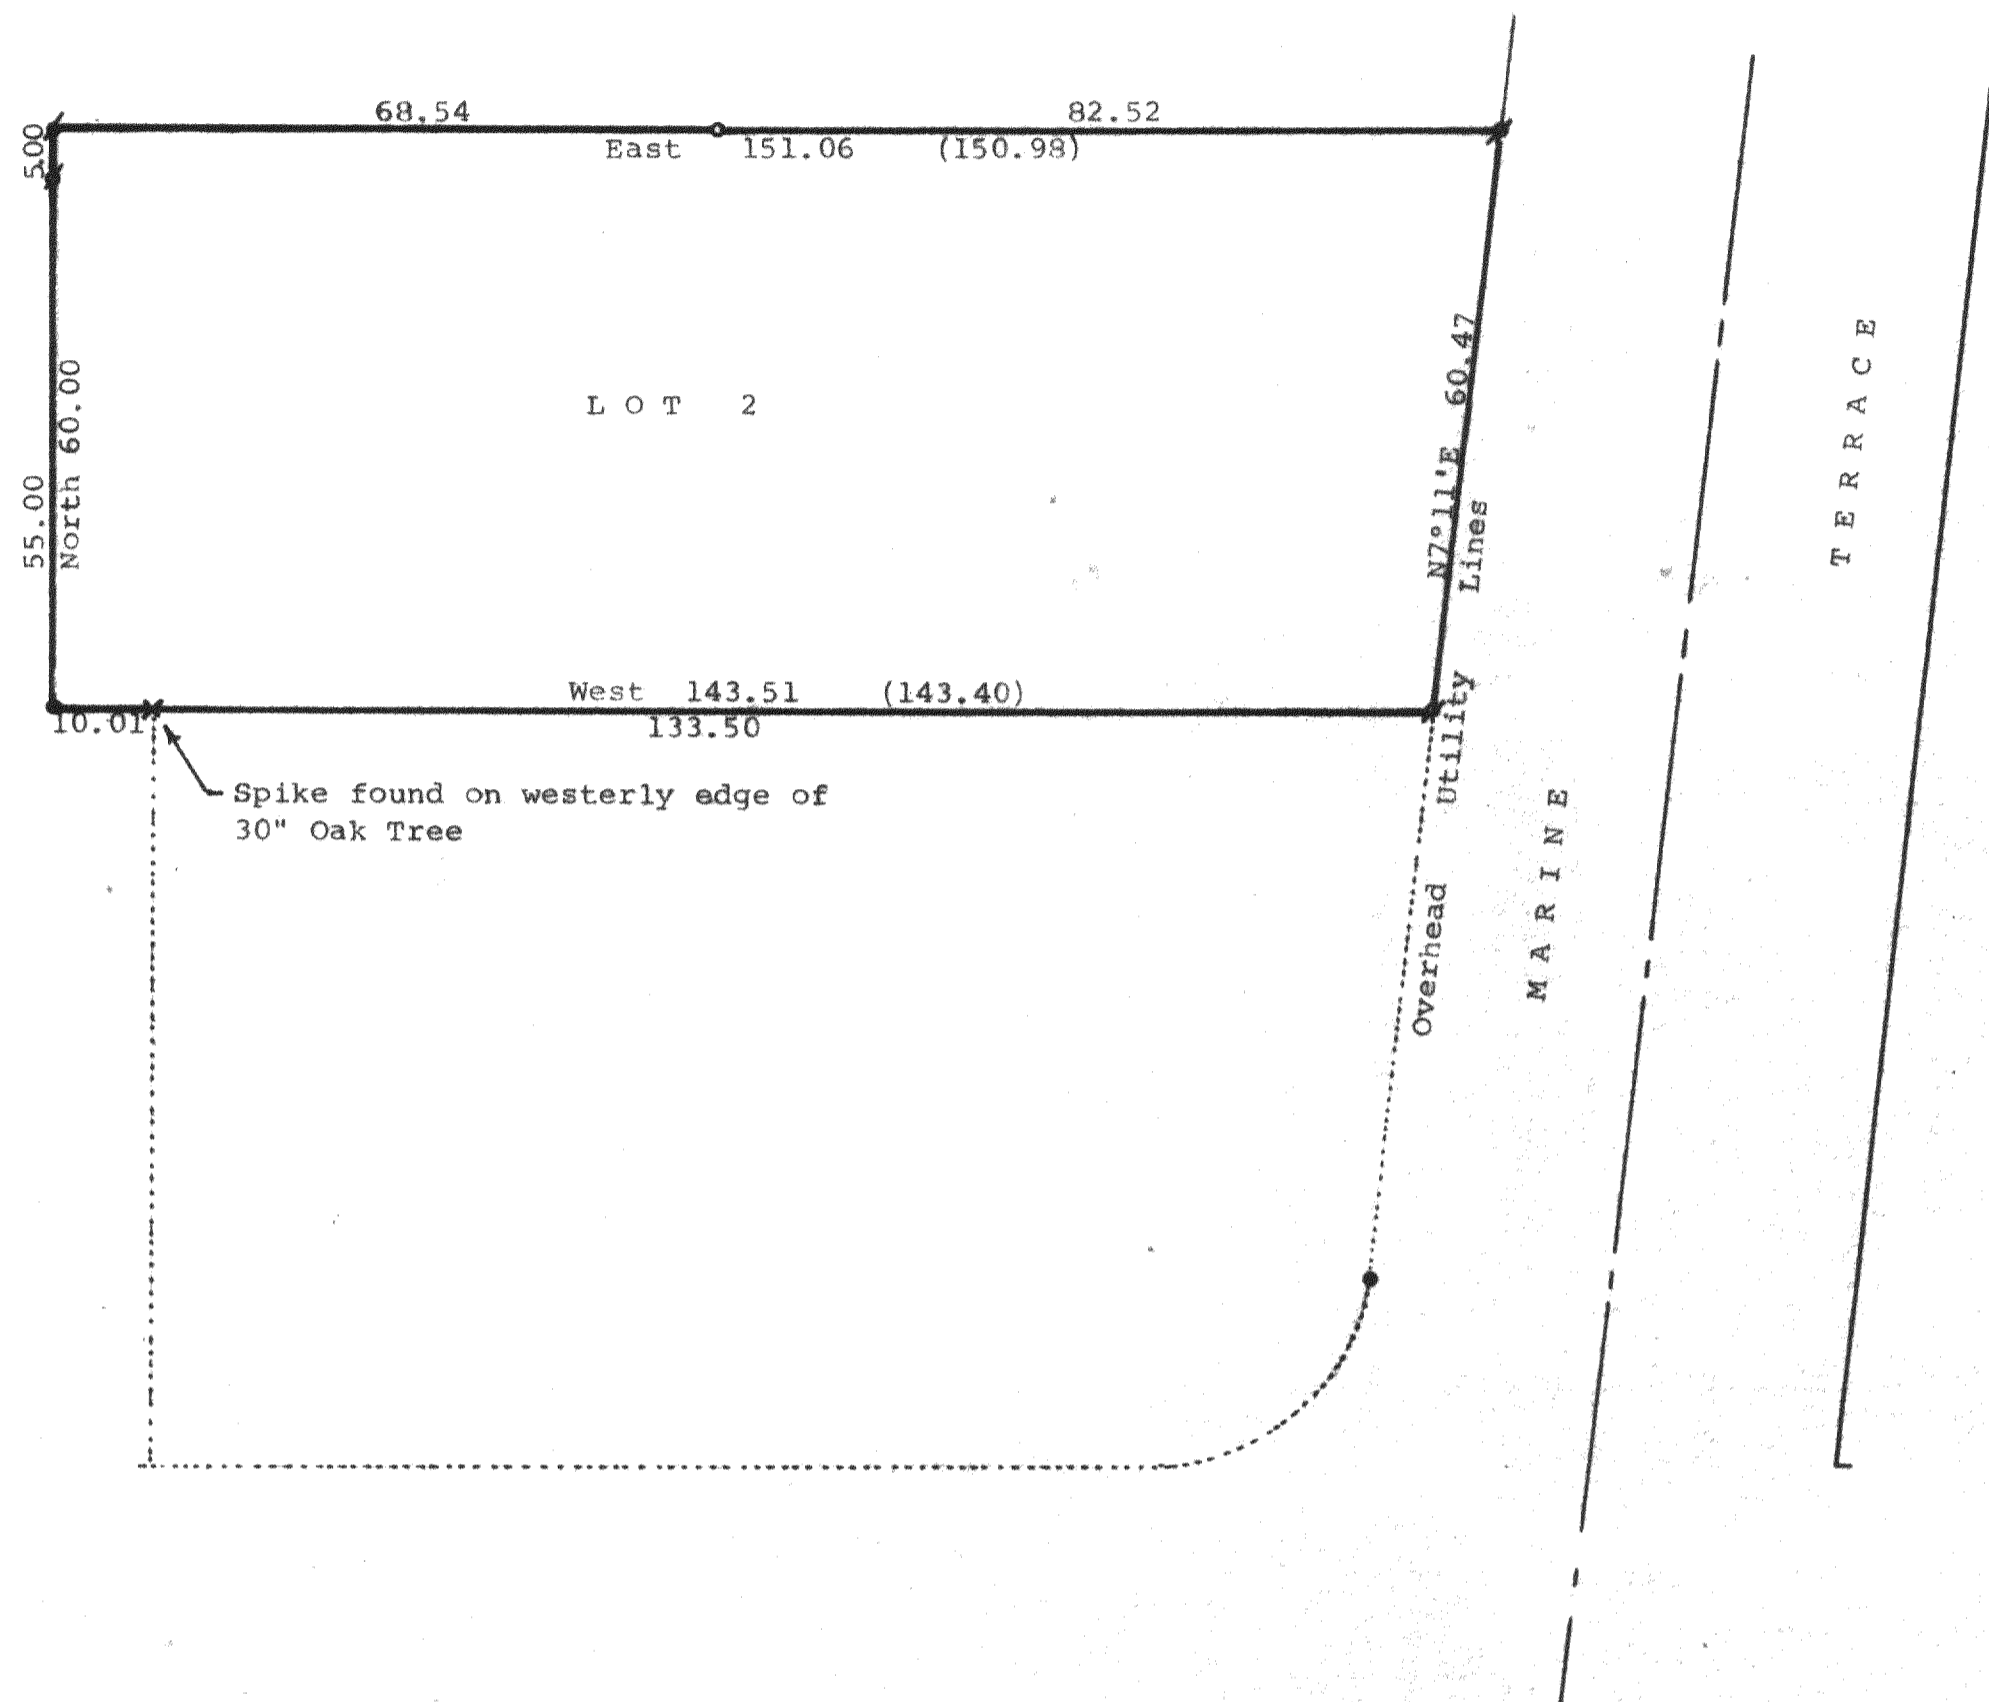

Spike found on westerly edge of  
 30" Oak Tree

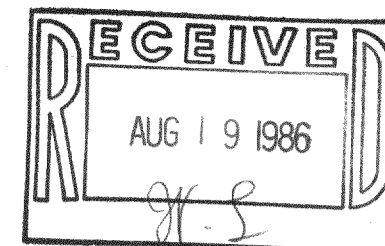

Scale - 1" = 20'  
 ● = Concrete Monument Found  
 / = 1" Iron Pipe Found  
 ○ = 1/2" Iron Pipe Set  
 Bearings used are those on the recorded  
 plat of the subdivision  
 Survey ordered by: Century 21 Skandia  
 Realty  
 312 South 7th Street  
 Delavan, WI 53115

STATE OF WISCONSIN) SS  
 COUNTY OF WALWORTH)

I, George T. Dunham, Surveyor, certify that I have surveyed the property described as follows:  
 Lot 2 in Block 2 in Woodlawn Bay Community, a subdivision located in Sections 21 & 28, T 2 N, R 16 E, Walworth County, Wisconsin, and that map shown above is a true representation thereof and shows the size and location of the property, its exterior boundaries, the location of all visible structures and dimensions of all principal buildings thereon, boundary fences, apparent easements, roadways and visible encroachments, if any, and that I have surveyed the property hereon described according to the official records, to the best of my knowledge and belief.  
 August 24, 1984

*George T. Dunham*  
 George T. Dunham, Surveyor

