


RECEIVED
MAR 5 1987

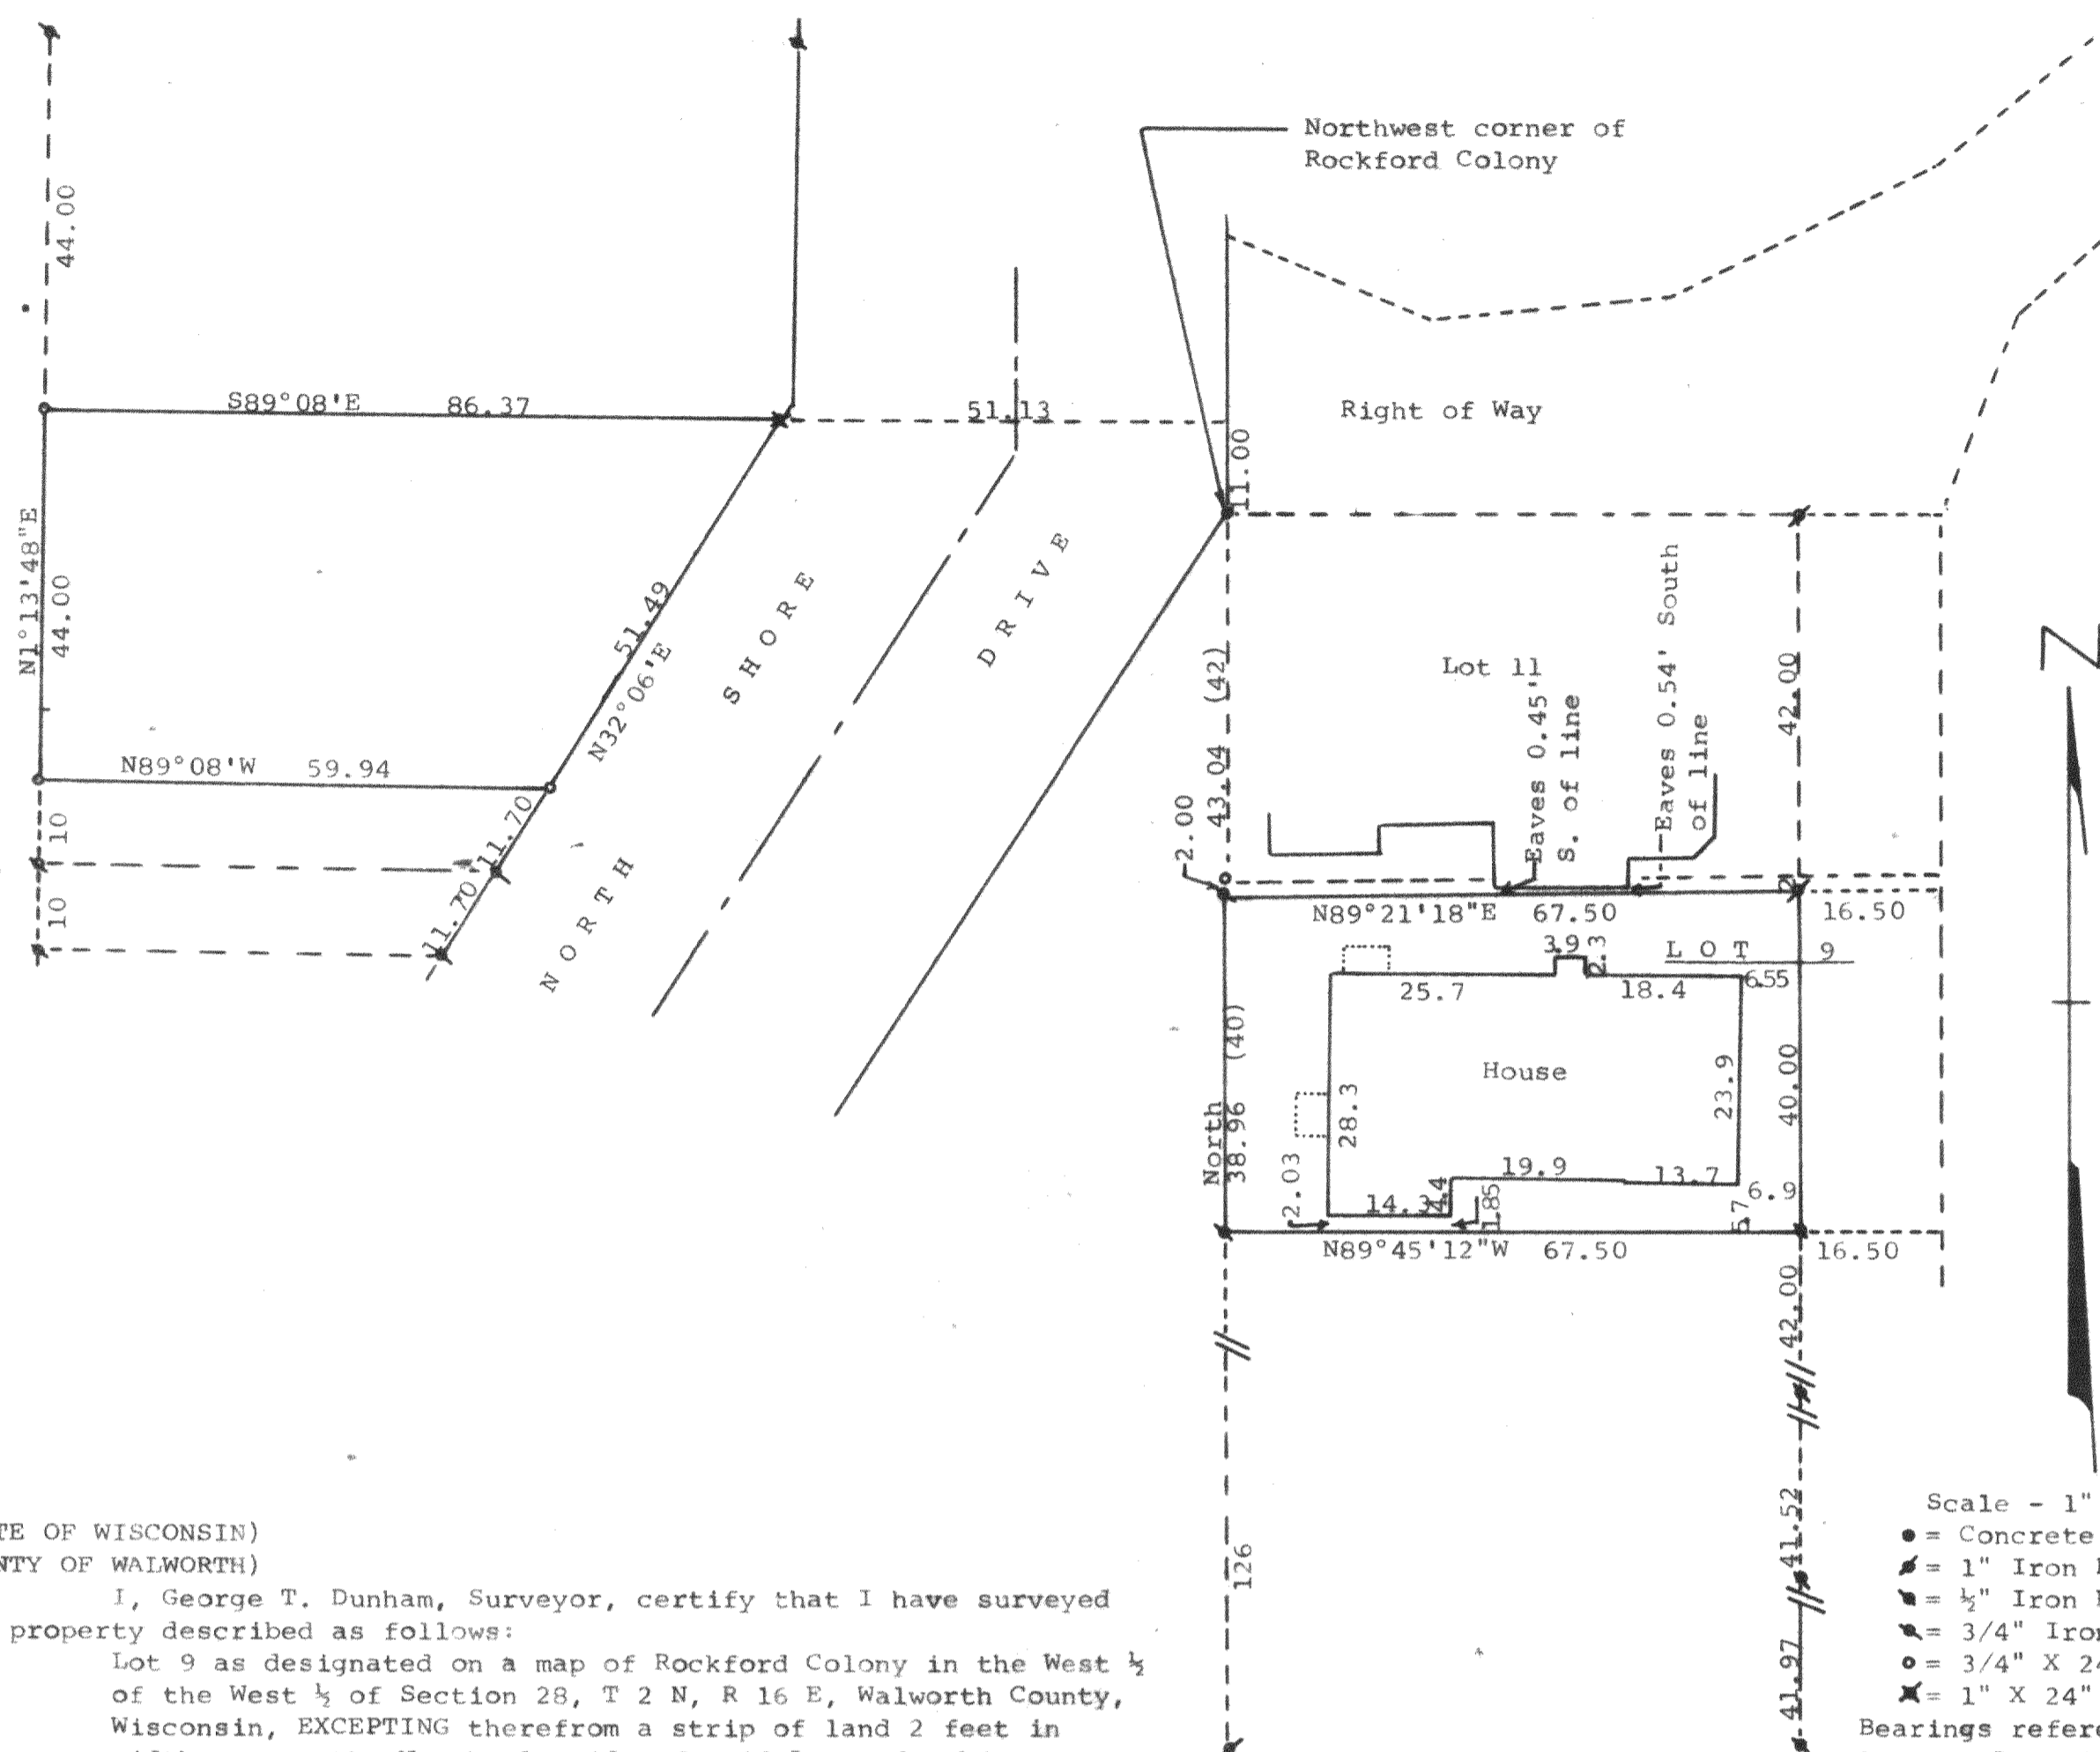

216-895