


RECEIVED  
MAR 5 1987

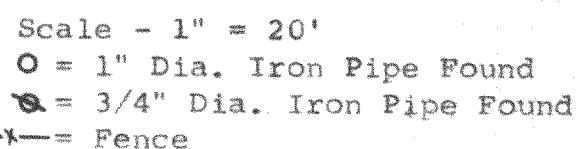

Bearings are those of record.  
Survey Ordered By:  
Century 21  
Skandia Realty  
312 S. 7th Street  
Delavan, Wisconsin 53115

STATE OF WISCONSIN)  
COUNTY OF WALWORTH) SS

I, Richard C. Schulz, Surveyor, certify that I have surveyed the property described as follows,

Lot 3, Block 10 of Delmar Subdivision, located in Section 27,

T 2 N, R 16 E, Walworth County, Wisconsin.

and that the map shown above is a true representation thereof and shows the size and location of the property, its exterior boundaries, the location of all visible structures and dimensions of all principal buildings, thereon, boundary fences, apparent easements, roadways and visible encroachments, if any, and that I have surveyed the property described hereon according to the official records, to the best of my knowledge and belief.

August 19, 1986.

Richard C. J. [Signature]

August 19, 1986.

Richard C. Schulz, Surveyor

