

ABELL SURVEYING & **MAPPING** DELAVAN, WISCONSIN 53115

414-728-6737

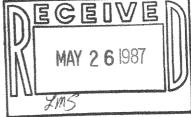

FENCE LINE RUNS EAST - WEST 0.3' NORTH OF IRON PIPES

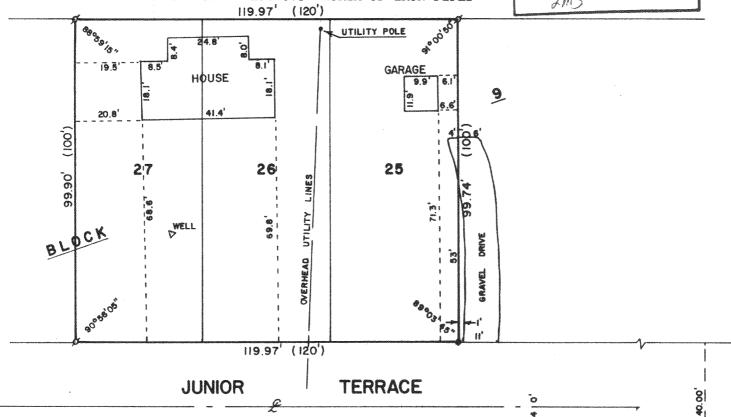

PLAT OF SURVEY OF

LOTS 25-27, BLOCK 9, SOUTH SHORE MANOR FIRST ADDITION, T2N, R16E, WALWORTH COUNTY, WISCONSIN.

ORDERED BY:

THE RAULAND AGENCY 118 KENOSHA ST.

53184 WALWORTH, WI



SCALE

1"=30'

ρ - IRON PIPE FOUND

CONCRETE MONUMENT FOUND

• - 3/4" DIA. IRON ROD SET

()- RECORDED AS

I HEREBY CERTIFY THAT I HAVE SURVEYED THE ABOVE DESCRIBED PROPERTY AND THAT THE ABOVE MAP IS A TRUE REPRESENTATION THEREOF AND SHOWS THE SIZE AND LOCATION OF THE PROPERTY, ITS EXTERIOR BOUNDARIES, THE LOCATION OF ALL VISIBLE STRUCTURES AND DIMENSIONS OF ALL PRINCIPAL BUILDINGS THEREON, BOUNDARY FENCES, APPARENT EASEMENTS, ROADWAYS AND VISIBLE ENCROACHMENTS, IF ANY, TO THE BEST OF MY KNOWLEDGE AND BELIEF.

THIS SURVEY IS MADE FOR THE USE OF THE PRESENT OWNERS OF THE PROPERTY, AND ALSO THOSE WHO PURCHASE, MORTGAGE OR GUARANTEE THE TITLE THERETO WITHIN ONE (1) YEAR FROM DATE HEREOF.

and 7. abell

DAVID F. ABELL

WISCONSIN REGISTERED LAND SURVEYOR, S-1596

JOB NUMBER - 87060 DATE NOTE: THIS IS NOT A CERTIFIED COPY UNLESS SEALED.

F 551-9