


ABELL SURVEYING & MAPPING DELAVAN, WISCONSIN 53115 414-728-6737

PLAT OF SURVEY OF

LOT 17, BLOCK 1, DELMAR SUBDIVISION, T2N,R16E, WALWORTH COUNTY, WISCONSIN.



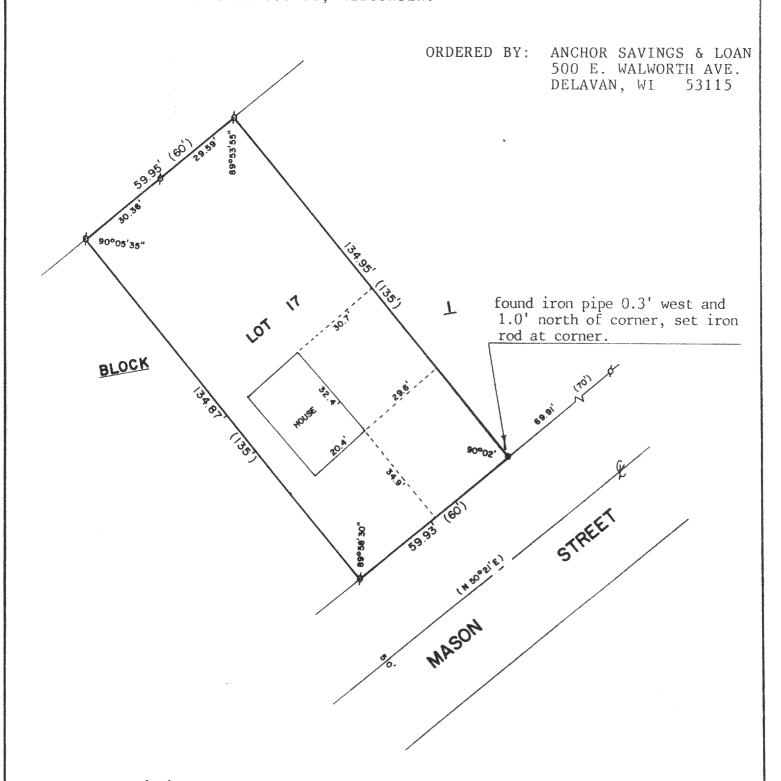

LEGEND - IRON PIPE FOUND

- IRON ROD SET () - RECORDED AS

I, DAVID F. ABELL, DO HEREBY CERTIFY THAT I HAVE SURVEYED THE PROPERTY HEREON DESCRIBED ACCORDING TO THE OFFICIAL RECORDS AND THAT THE PLAT HEREON IS A CORRECT REPRESENTATION OF THE PROPERTY LINES TO THE BEST OF MY KNOWLEDGE AND BELIEF.

DAVID F. ABELL WISCONSIN REGISTERED LAND SURVEYOR, S-1596

DATE

25, 1987

JOB NUMBER - 87043

NOTE: THIS IS NOT A CERTIFIED COPY UNLESS SEALED.