


ABELL
SURVEYING & MAPPING
DELAVAN, WISCONSIN 53115
414-728-6737


SCHROEDER AVENUE

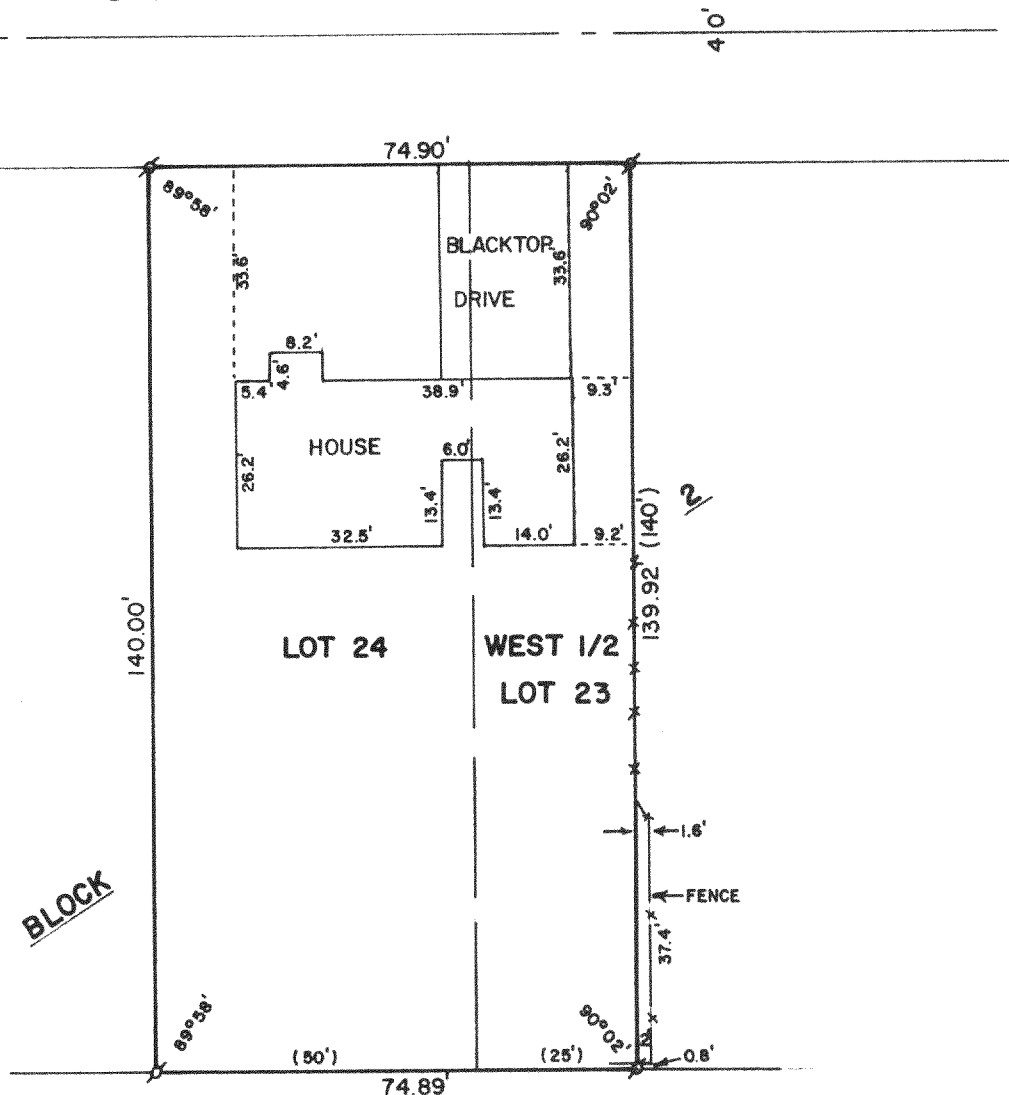

PLAT OF SURVEY OF

LOT 24 AND THE WEST 1/2 OF LOT 23, BLOCK 2,
INLET OAKS SUBDIVISION NO. 4, T2N,R16E,
WALWORTH COUNTY, WISCONSIN.

ORDERED BY: CENTURY 21 - SKANDIA REALTY
312 S. 7th STREET
DELAVAN, WI 53115

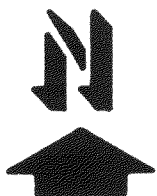

SCALE - 1"=30'

LEGEND

Ø - IRON PIPE FOUND
() - RECORDED AS

I, DAVID F. ABELL, DO HEREBY CERTIFY
THAT I HAVE SURVEYED THE PROPERTY
HEREON DESCRIBED ACCORDING TO THE
OFFICIAL RECORDS AND THAT THE PLAT
HEREON IS A CORRECT REPRESENTATION
OF THE PROPERTY LINES TO THE BEST OF
MY KNOWLEDGE AND BELIEF.

David F. Abell
DAVID F. ABELL
WISCONSIN REGISTERED LAND SURVEYOR, S-1596

April 30, 1987
DATE JOB NUMBER - 87053
NOTE: THIS IS NOT A CERTIFIED COPY UNLESS SEALED.