

ABELL
SURVEYING & MAPPING
DELAVAN, WISCONSIN 53115
414-728-6737

COMUS

DRIVE



6.6'

PLAT OF SURVEY OF

LOT 4, BLOCK 2, HANSEN'S
SUBDIVISION, T2N, R16E,
WALWORTH COUNTY, WISCONSIN.

ORDERED BY: ANCHOR SAVINGS &
LOAN
500 E. WALWORTH
DELAVAN, WI 53115

OWNER: JOE MOSER

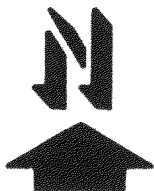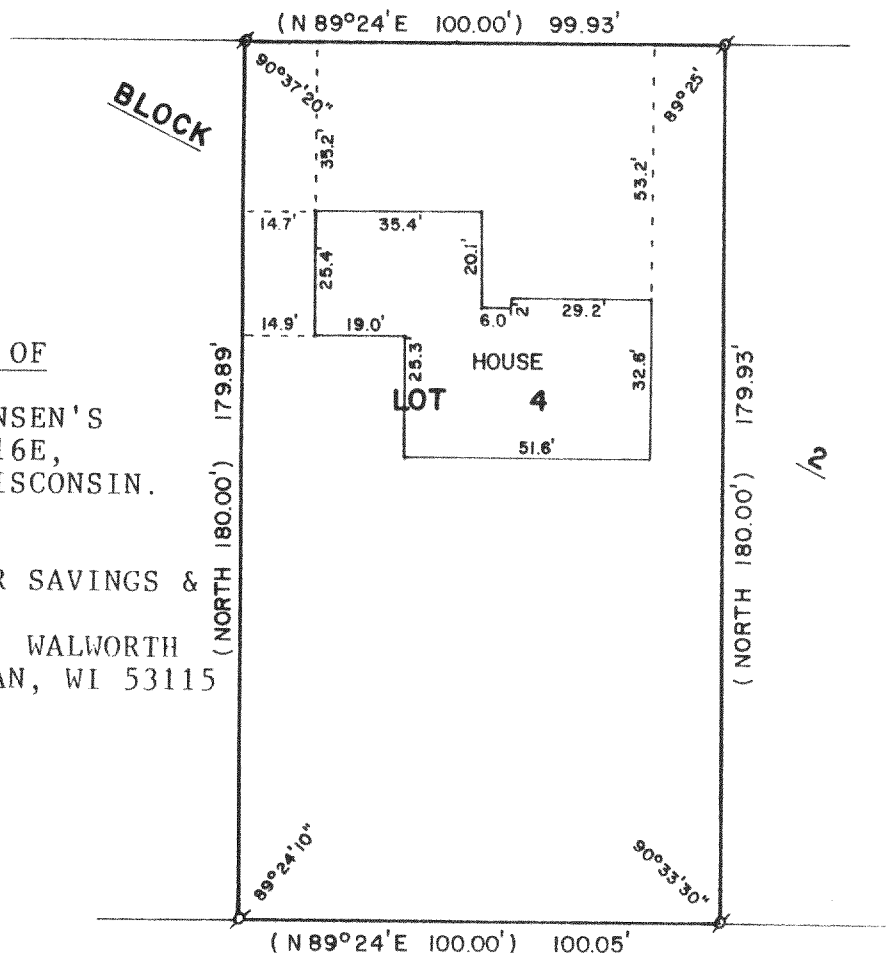

SCALE - 1"=40'

LEGEND

Ø - IRON PIPE FOUND
() - RECORDED AS

REVISED: JUNE 22, 1987

I, DAVID F. ABELL, DO HEREBY CERTIFY
THAT I HAVE SURVEYED THE PROPERTY
HEREON DESCRIBED ACCORDING TO THE
OFFICIAL RECORDS AND THAT THE PLAT
HEREON IS A CORRECT REPRESENTATION
OF THE PROPERTY LINES TO THE BEST OF
MY KNOWLEDGE AND BELIEF.

David F. Abell

DAVID F. ABELL
WISCONSIN REGISTERED LAND SURVEYOR, S-1596

April 21, 1987

DATE JOB NUMBER - 87042

NOTE: THIS IS NOT A CERTIFIED COPY UNLESS SEALED.