
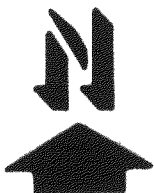


**ABELL  
SURVEYING & MAPPING**  
DELAVAN, WISCONSIN 53115  
414-728-6737

OWNER: STANLEY BUGNO  
4610 VIEW CREST  
DELAVAN, WI.

**BLOCK**

CORNER FALLS IN CONCRETE PIT,  
IRON PIPES SET ON 3'  
OFFSETS

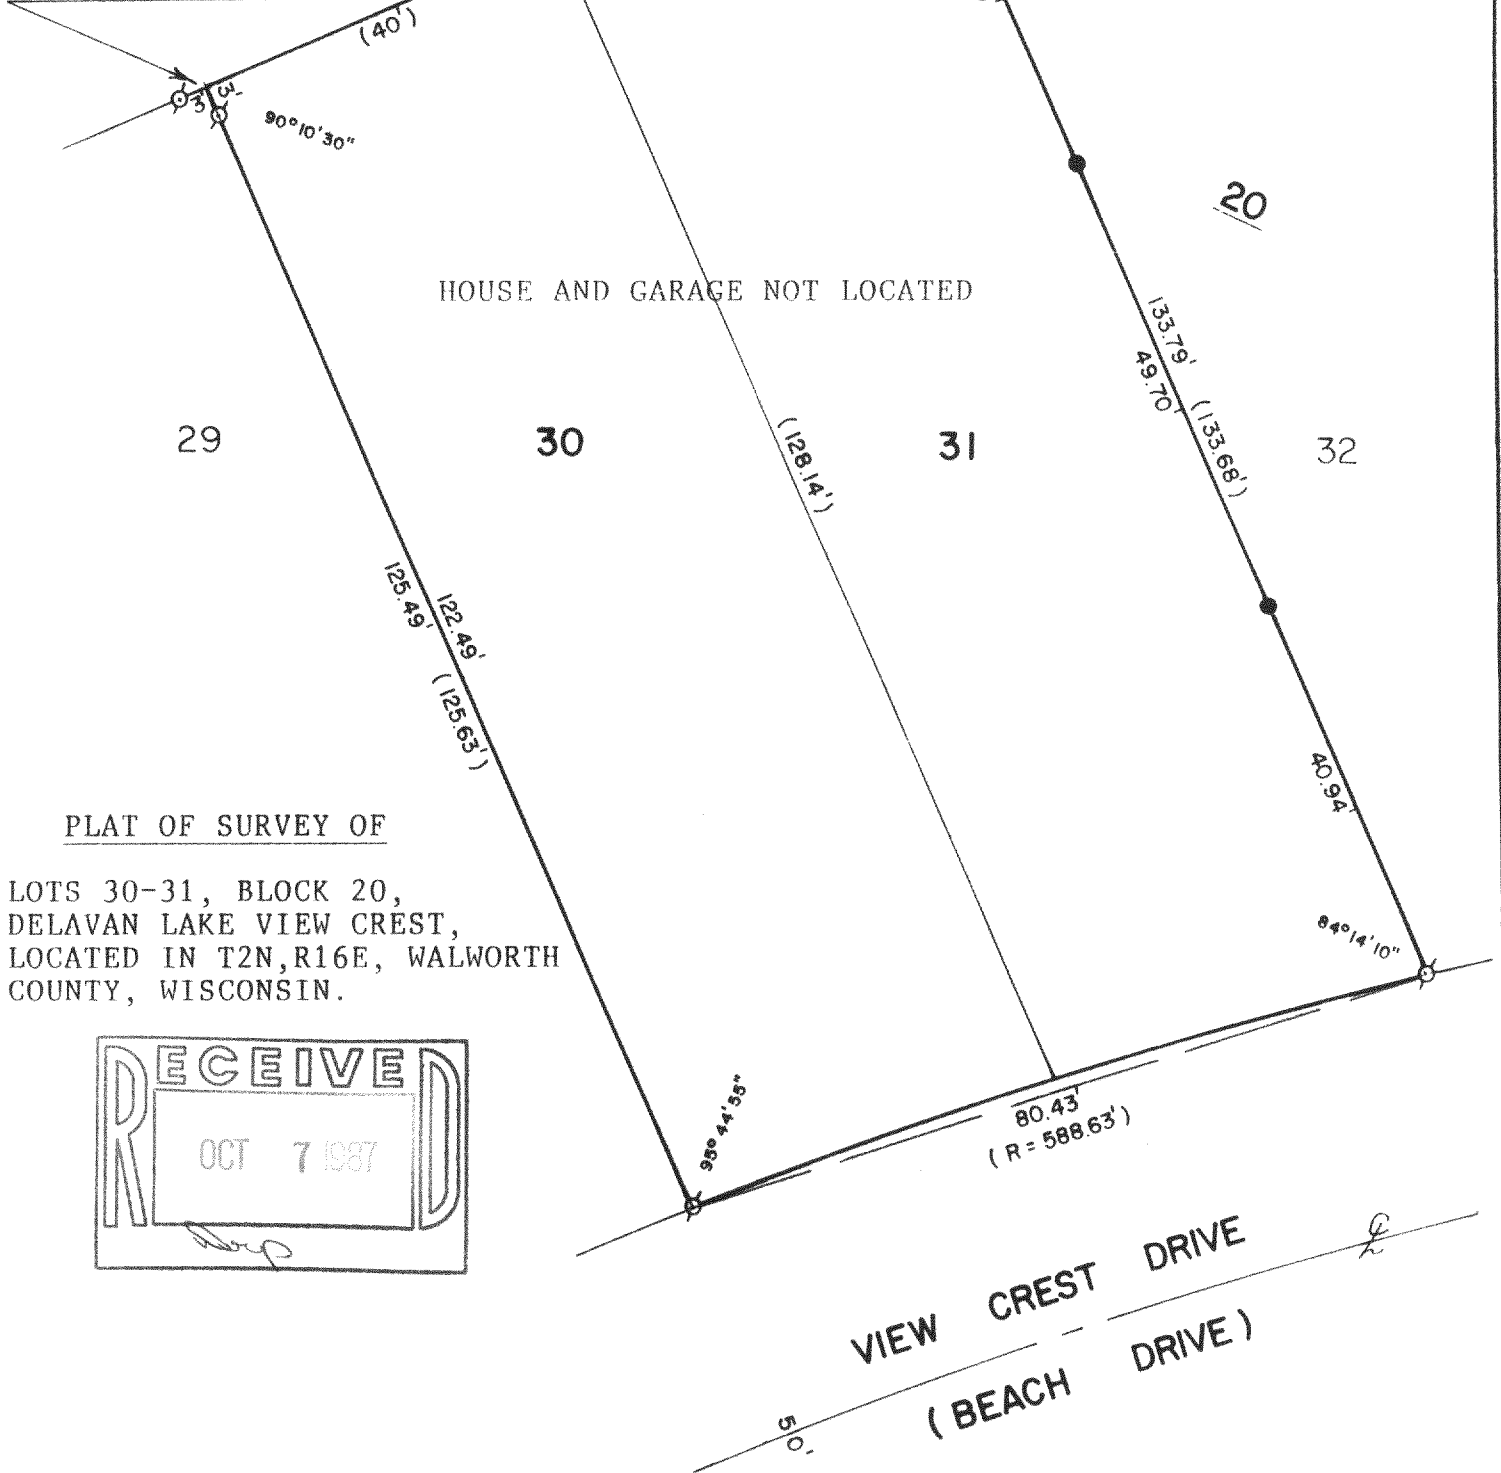

SCALE - 1"=20'

**LEGEND**

- ⊙ - IRON PIPE FOUND
- - 3/4" DIA. IRON ROD SET
- ( ) - RECORDED AS

I, DAVID F. ABELL, DO HEREBY CERTIFY  
THAT I HAVE SURVEYED THE PROPERTY  
HEREON DESCRIBED ACCORDING TO THE  
OFFICIAL RECORDS AND THAT THE PLAT  
HEREON IS A CORRECT REPRESENTATION  
OF THE PROPERTY LINES TO THE BEST OF  
MY KNOWLEDGE AND BELIEF.

*David F. Abell*

DAVID F. ABELL  
WISCONSIN REGISTERED LAND SURVEYOR, S-1596

*August 28, 1987*

DATE JOB NUMBER - 87120

NOTE: THIS IS NOT A CERTIFIED COPY UNLESS SEALED.