

ABELL MAPPING SURVEYING & DELAVAN, WISCONSIN 53115 414-728-6737

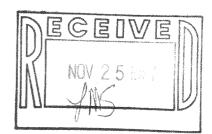

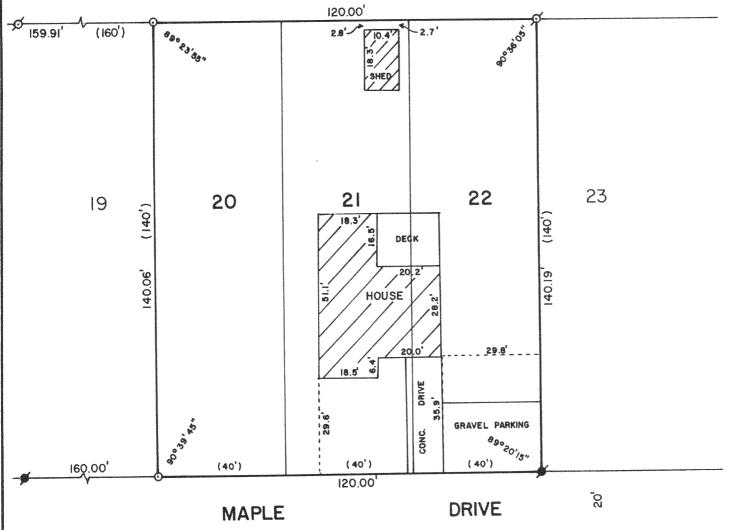

PLAT OF SURVEY OF

LOTS 20-22 OF KRUMHAAR'S ADDITION TO RAVENSWOOD, TOWN 2 NORTH, RANGE 16 EAST, WALWORTH COUNTY, WISCONSIN.

ORDERED BY:

CENTURY 21 - SKANDIA REALTY

312 S. 7th STREET DELAVAN, WI.



SCALE

1"=30"

LEGEND

Ø - IRON PIPE FOUND

IRON ROD FOUNDIRON ROD SET

()- RECORDED AS

I, DAVID F. ABELL, DO HEREBY CERTIFY THAT I HAVE SURVEYED THE PROPERTY HEREON DESCRIBED ACCORDING TO THE OFFICIAL RECORDS AND THAT THE PLAT HEREON IS A CORRECT REPRESENTATION OF THE PROPERTY LINES TO THE BEST OF MY KNOWLEDGE AND BELIEF.

7. abell

DAVID F. ABELL WISCONSIN REGISTERED LAND SURVEYOR, S-1596

November 11,

JOB NUMBER - 87175 THIS IS NOT A CERTIFIED COPY UNLESS SEALED. NOTE:

216-983