
KOLB LAND CONSULTING, INC.

LAND SURVEYING . SUBDIVIDING . LAND PLANNING

929 WILLIAMS STREET LAKE GENEVA, WISCONSIN 53147 414-248-3697

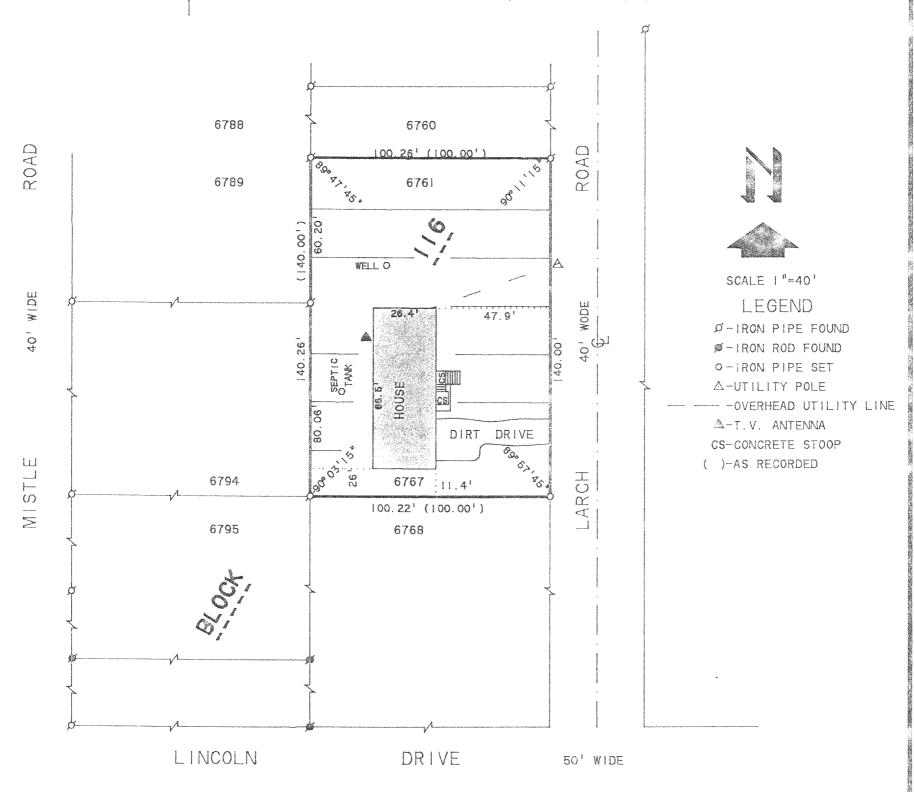

PLAT OF SURVEY OF

LOTS 6761-6767. BLOCK II6 OF LAKE COMO BEACH SUBDIVISION TOWN OF GENEVA, WALWORTH COUNTY, WISCONSIN.

ORDERED BY: TAGGART AGENCY 756 W. MAIN ST.

LAKE GENEVA, WI 53147

I HEREBY CERTIFY THAT I HAVE SURVEYED THE ABOVE DESCRIBED PROPERTY AND THAT THE ABOVE MAP IS A TRUE REPRESENTATION THEREOF AND SHOWS THE SIZE AND LOCATION OF THE PROPERTY, ITS EXTERIOR BOUNDARIES, THE LOCATION OF ALL VISIBLE STRUCTURES AND THE DIMENSIONS OF ALL PRINCIPAL BUILDINGS THEREON, BOUNDARY FENCES, APPARENT EASEMENTS, ROADWAYS AND VISIBLE ENCROACHMENTS, IF ANY, TO THE BEST OF MY KNOWLEDGE AND BELIEF. THIS SURVEY IS MADE FOR THE USE OF THE PRESENT OWNERS OF THE PROPERTY, AND ALSO THOSE WHO PURCHASE. MORTGAGE, OR GUARANTEE THE TITLE THERETO WITHIN ONE (I) YEAR FROM DATE HEREON.

THIS SURVEY IS NOT VALID UNLESS THE SURVEYOR'S SIGNATRUE IS IN RED.

HAROLD H. KOLB

WISCONSIN REGISTERED LAND SURVEYOR. S-187

DATE SEPTEMBER 26, 1990

