



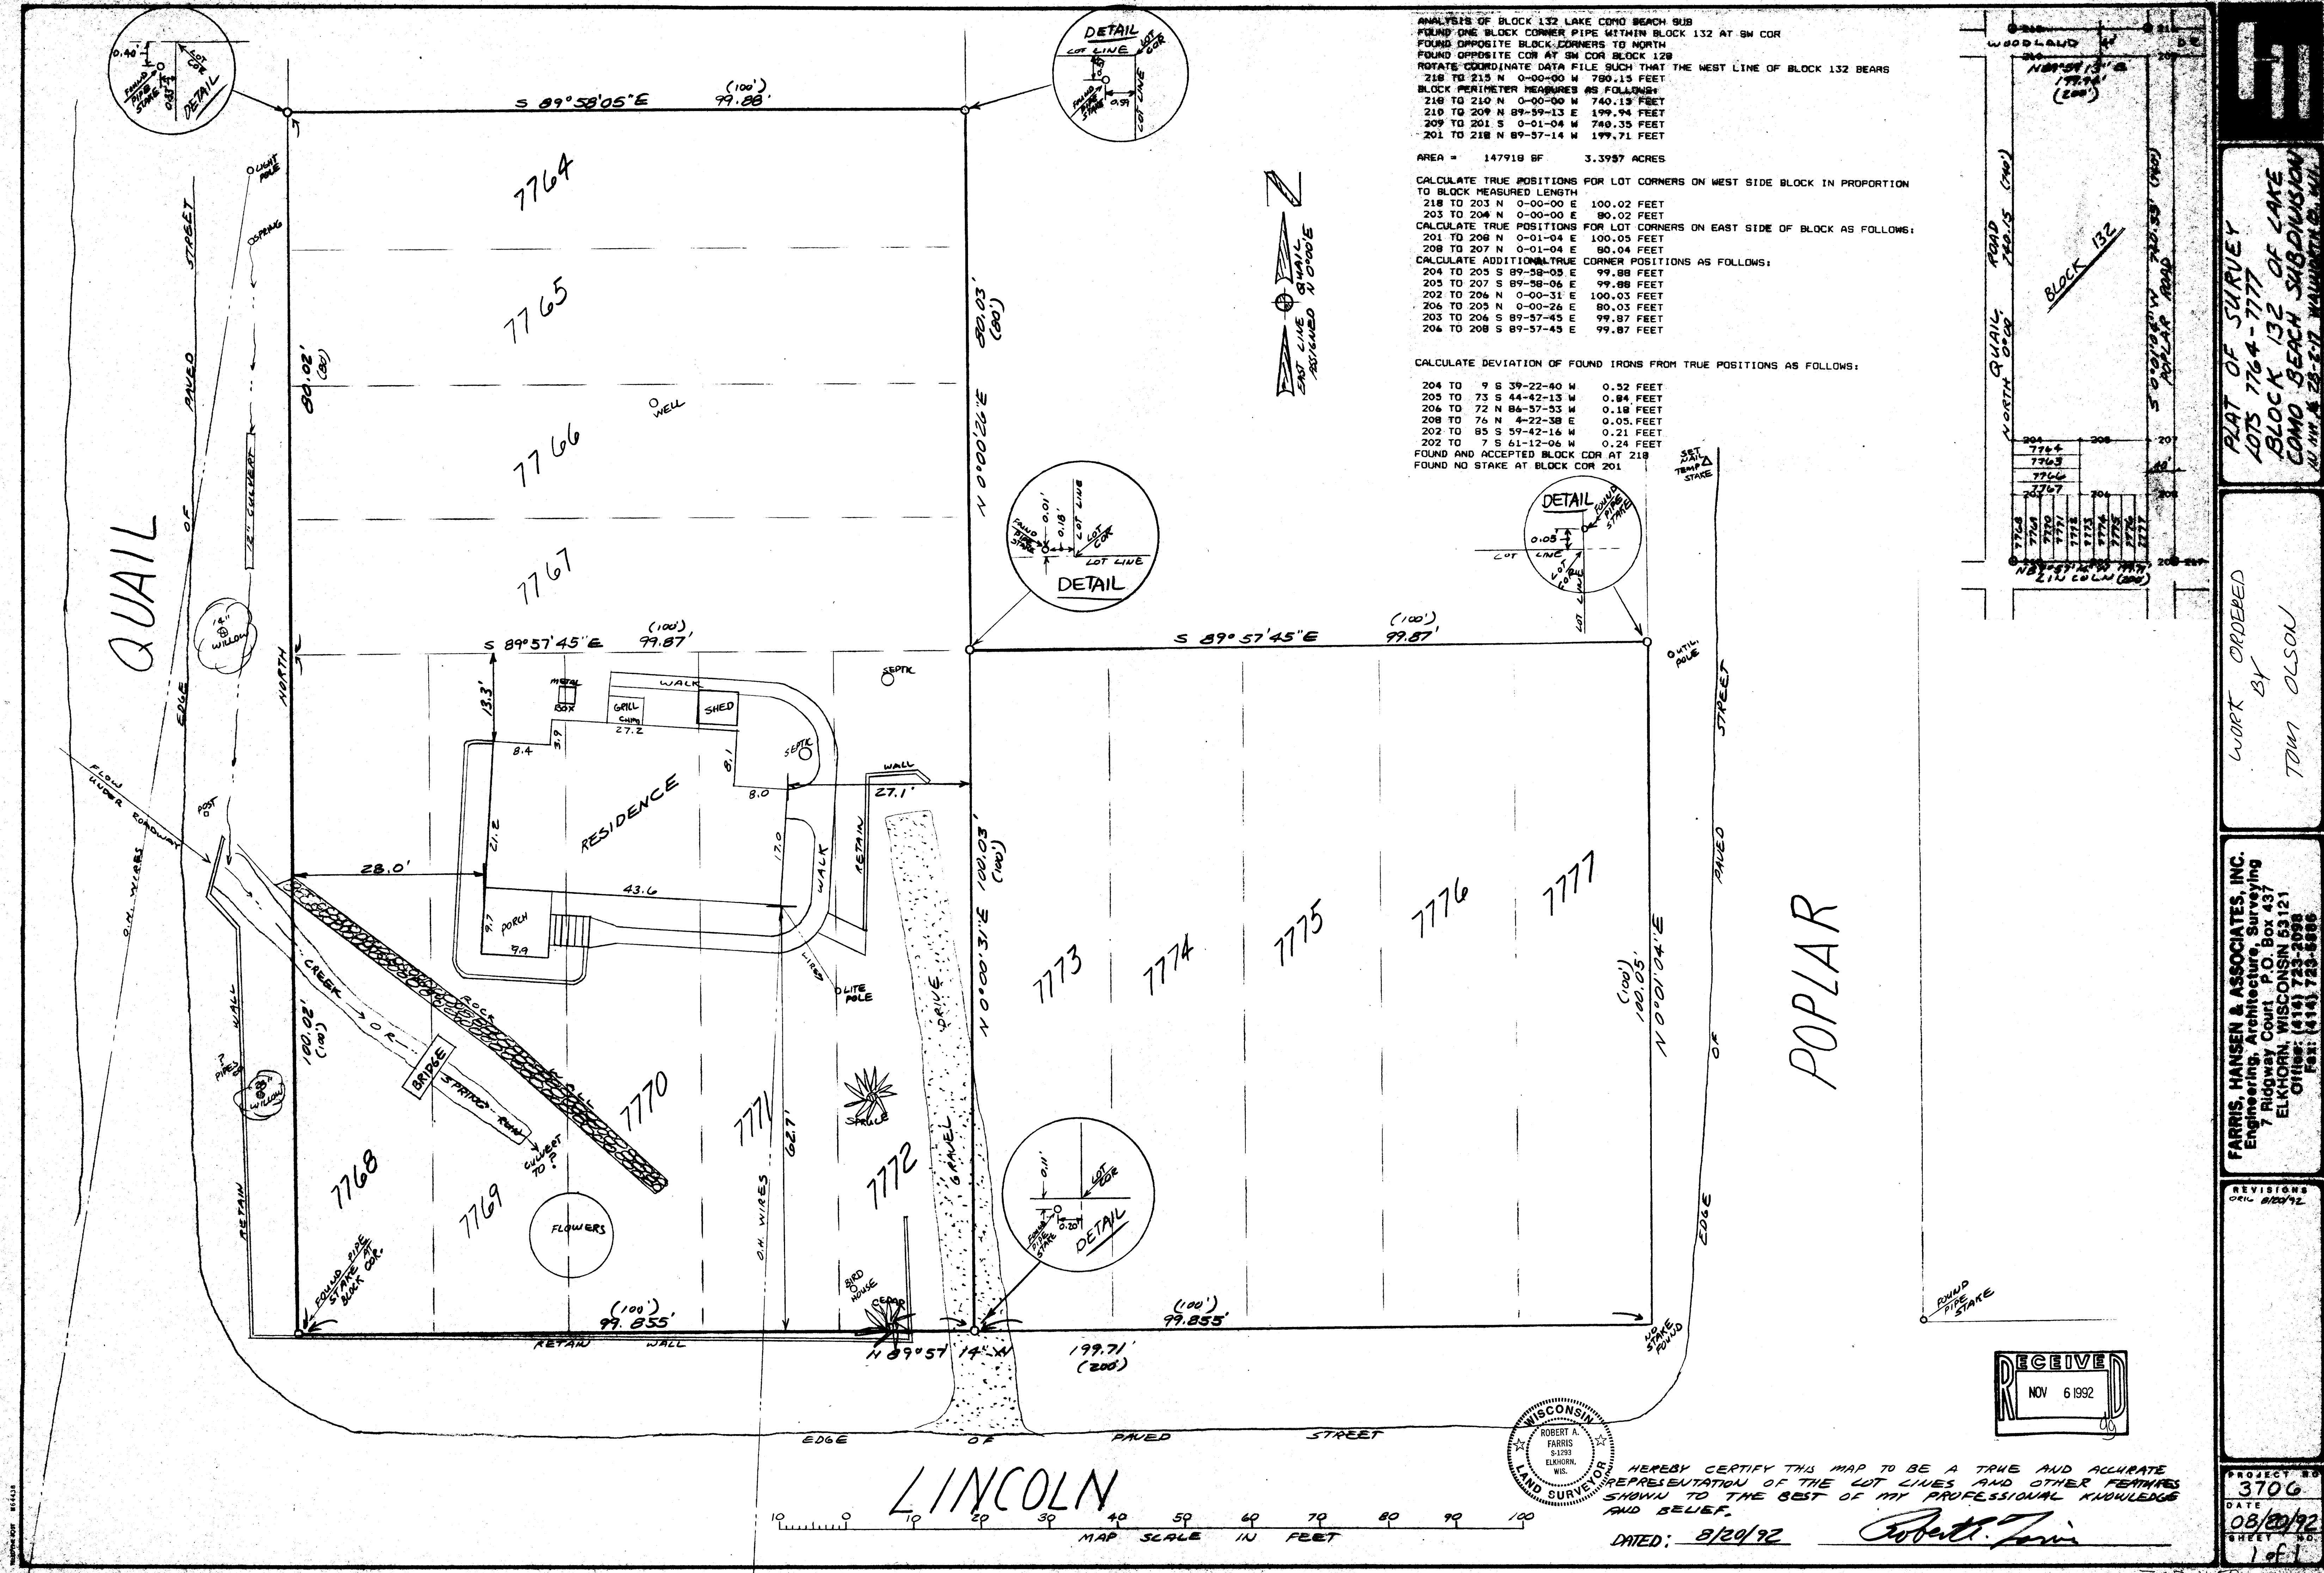

ANALYSIS OF BLOCK 132 LAKE COMO BEACH SUB
FOUND ONE BLOCK CORNER PIPE WITHIN BLOCK 132 AT SW COR
FOUND OPPOSITE BLOCK CORNERS TO NORTH
FOUND OPPOSITE COR AT SW COR BLOCK 128
ROTATE COORDINATE DATA FILE SUCH THAT THE WEST LINE OF BLOCK 132 BEARS
218 TO 215 N 0-00-00 W 780.13 FEET
BLOCK PERIMETER MEASURES AS FOLLOWS:
218 TO 210 N 0-00-00 W 740.13 FEET
210 TO 209 N 89-59-13 E 199.94 FEET
209 TO 201 S 0-01-04 W 740.35 FEET
201 TO 218 N 89-57-14 W 199.71 FEET

AREA = 147918 SF 3.3957 ACRES
CALCULATE TRUE POSITIONS FOR LOT CORNERS ON WEST SIDE BLOCK IN PROPORTION TO BLOCK MEASURED LENGTH
218 TO 203 N 0-00-00 E 100.02 FEET
203 TO 204 N 0-00-00 E 80.02 FEET
CALCULATE TRUE POSITIONS FOR LOT CORNERS ON EAST SIDE OF BLOCK AS FOLLOWS:
201 TO 208 N 0-01-04 E 100.05 FEET
208 TO 207 N 0-01-04 E 80.04 FEET
CALCULATE ADDITIONAL TRUE CORNER POSITIONS AS FOLLOWS:
204 TO 205 S 89-58-05 E 99.88 FEET
205 TO 207 S 89-58-06 E 99.88 FEET
202 TO 206 N 0-00-31 E 100.03 FEET
206 TO 205 N 0-00-26 E 80.03 FEET
203 TO 204 S 89-57-45 E 99.87 FEET
206 TO 208 S 89-57-45 E 99.87 FEET

CALCULATE DEVIATION OF FOUND IRONS FROM TRUE POSITIONS AS FOLLOWS:
204 TO 9 S 39-22-40 W 0.52 FEET
205 TO 73 S 44-42-13 W 0.84 FEET
206 TO 72 N 84-57-53 W 0.18 FEET
208 TO 76 N 4-22-38 E 0.05 FEET
202 TO 85 S 59-42-14 W 0.21 FEET
202 TO 7 S 61-12-04 W 0.24 FEET
FOUND AND ACCEPTED BLOCK COR AT 218
FOUND NO STAKE AT BLOCK COR 201

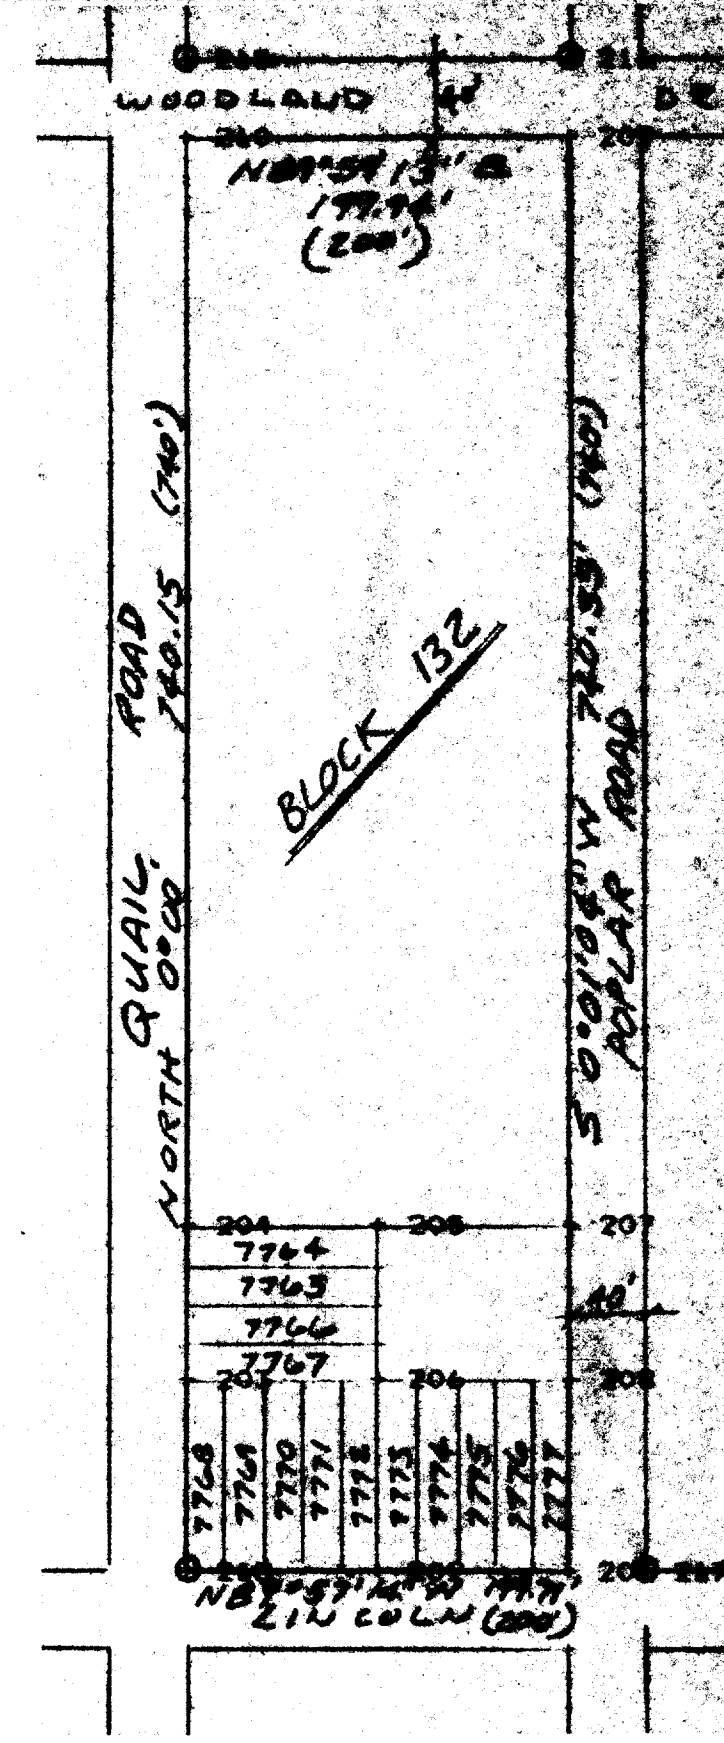


PLAT OF SURVEY
LOTS 7764-7777
BLOCK 132 OF LAKE
COMO BEACH SUBDIVISION
JULY 11, 1992

WORK ORDERED
BY
TOM OLSON

FARRIS, HANSEN & ASSOCIATES, INC.
Engineering, Architecture, Surveying
7 Ridgway Court P.O. Box 437
ELKHORN, WISCONSIN 53121
OFFICE: (414) 723-2098
FAX: (414) 723-8886

REVISIONS	
DATE	DESCRIPTION
08/20/92	3706
08/20/92	DATE
1 of 1	SHEET NO.

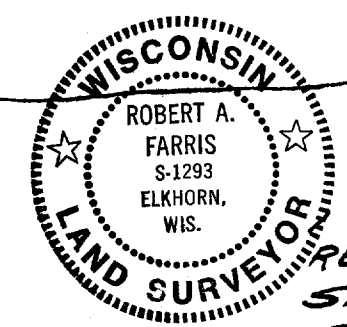

HEREBY CERTIFY THIS MAP TO BE A TRUE AND ACCURATE REPRESENTATION OF THE LOT LINES AND OTHER FEATURES SHOWN TO THE BEST OF MY PROFESSIONAL KNOWLEDGE AND BELIEF.
DATED: 8/29/92 Robert A. Farris

