


Plat of Survey

of

Lots 10492 thru 10499 Block 190 of Lake Como Beach Subdivision,
Located in Section 28, Town 2 North, Range 17 East, Town of
Geneva, Walworth County, Wisconsin.

Surveyed for: Robert Woller
10501 Uranus Road
Lake Geneva, Wisconsin. 53147

Bearings referenced to the
Subdivision Plat.

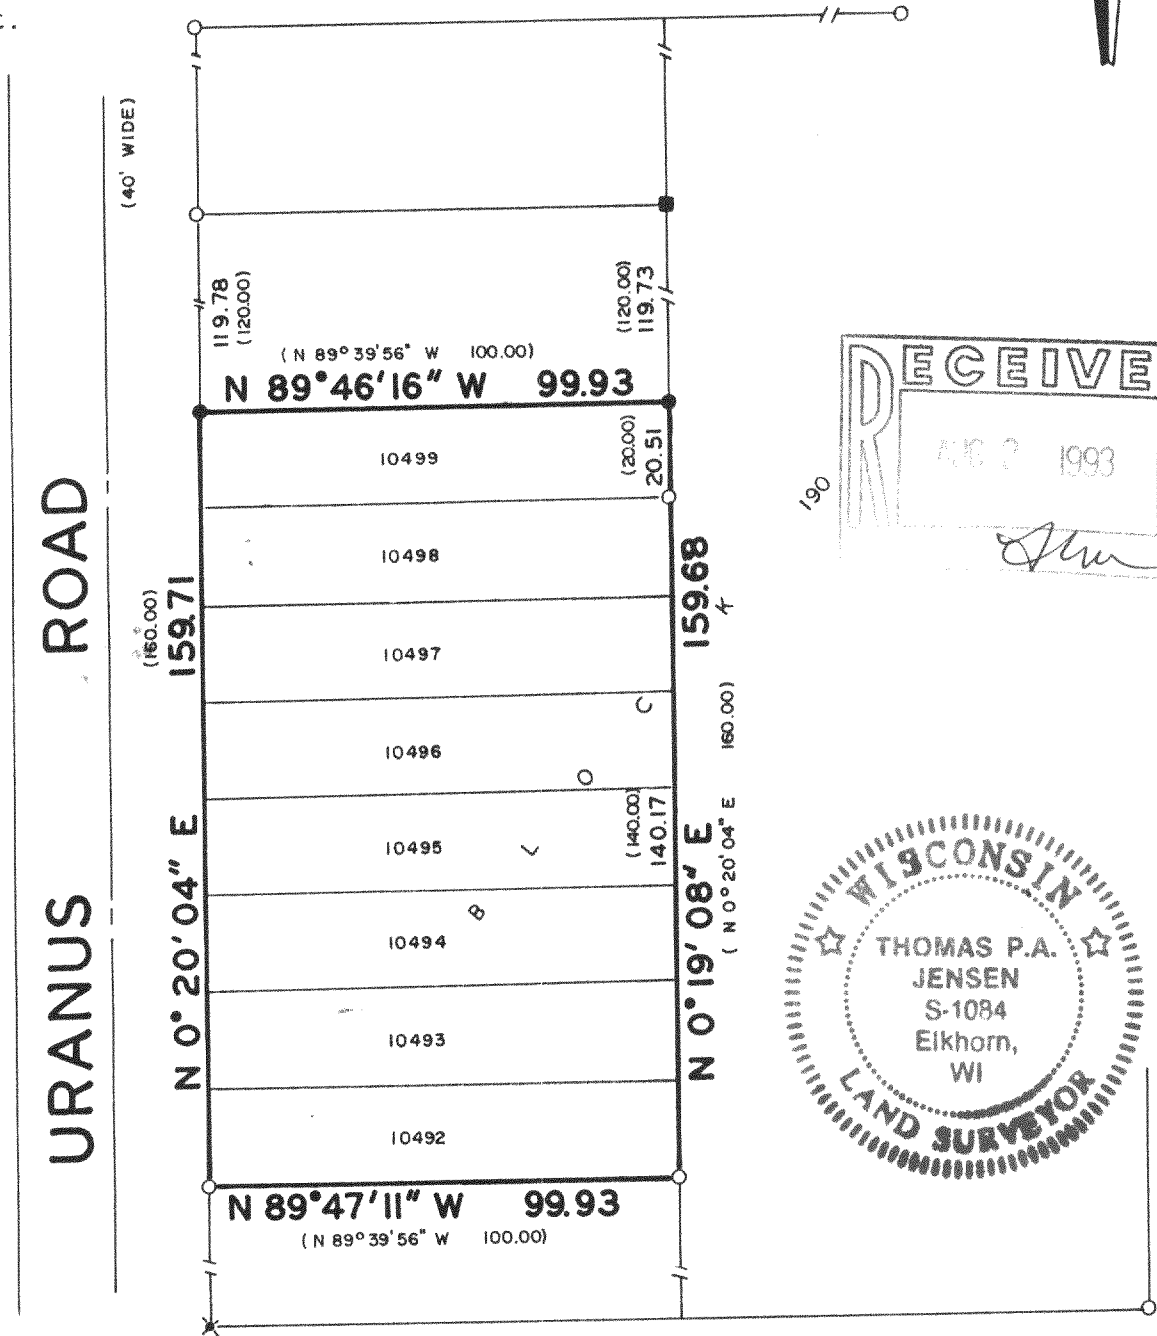

Copyright © 1993 by Jensen Surveying & Mapping S.C.
All rights reserved. No part of this survey plat may be reproduced or transmitted in any form
by any means - graphic, electronic, or mechanical, including photocopying, tracing, or infor-
mation storage and retrieval systems - without permission in writing from Thomas P.A. Jensen.

I, Thomas P.A. Jensen, Wisconsin Registered Land Surveyor, do hereby certify that this
survey was performed by me, or under my direction, in full compliance with the owner's/agent's
instructions and Chapter A-E 7 of the Wisconsin Administrative Code ' Minimum Standards For
Property Surveys ', and that this map is an accurate representation thereof to the best of my
knowledge and belief.

Note: This survey plat is not
certified unless signed
and sealed in red ink.

Thomas P.A. Jensen
Thomas P.A. Jensen R.L.S. 1084

- Legend
- Found iron pipe
 - ✕ Found P.K. nail
 - Found iron rod
 - Set iron rod 3/4 dia.
 - (-) Recorded as dimension

Jensen Surveying & Mapping S.C.

45 South Wisconsin Street P.O. Box 322
Elkhorn, Wisconsin. 53121.
(414) 723-3434

Mapping date: March 31, 1993.

Revisions: 217-1167

Sheet 1 of 1 Sheets

Job reference number:

1993.033

Scale: 1 = 40'



JLB - 2276