


KOLB LAND CONSULTING, INC.

LAND SURVEYING • SUBDIVIDING • LAND PLANNING

929 WILLIAMS STREET

LAKE GENEVA, WISCONSIN 53147

414 248 3697

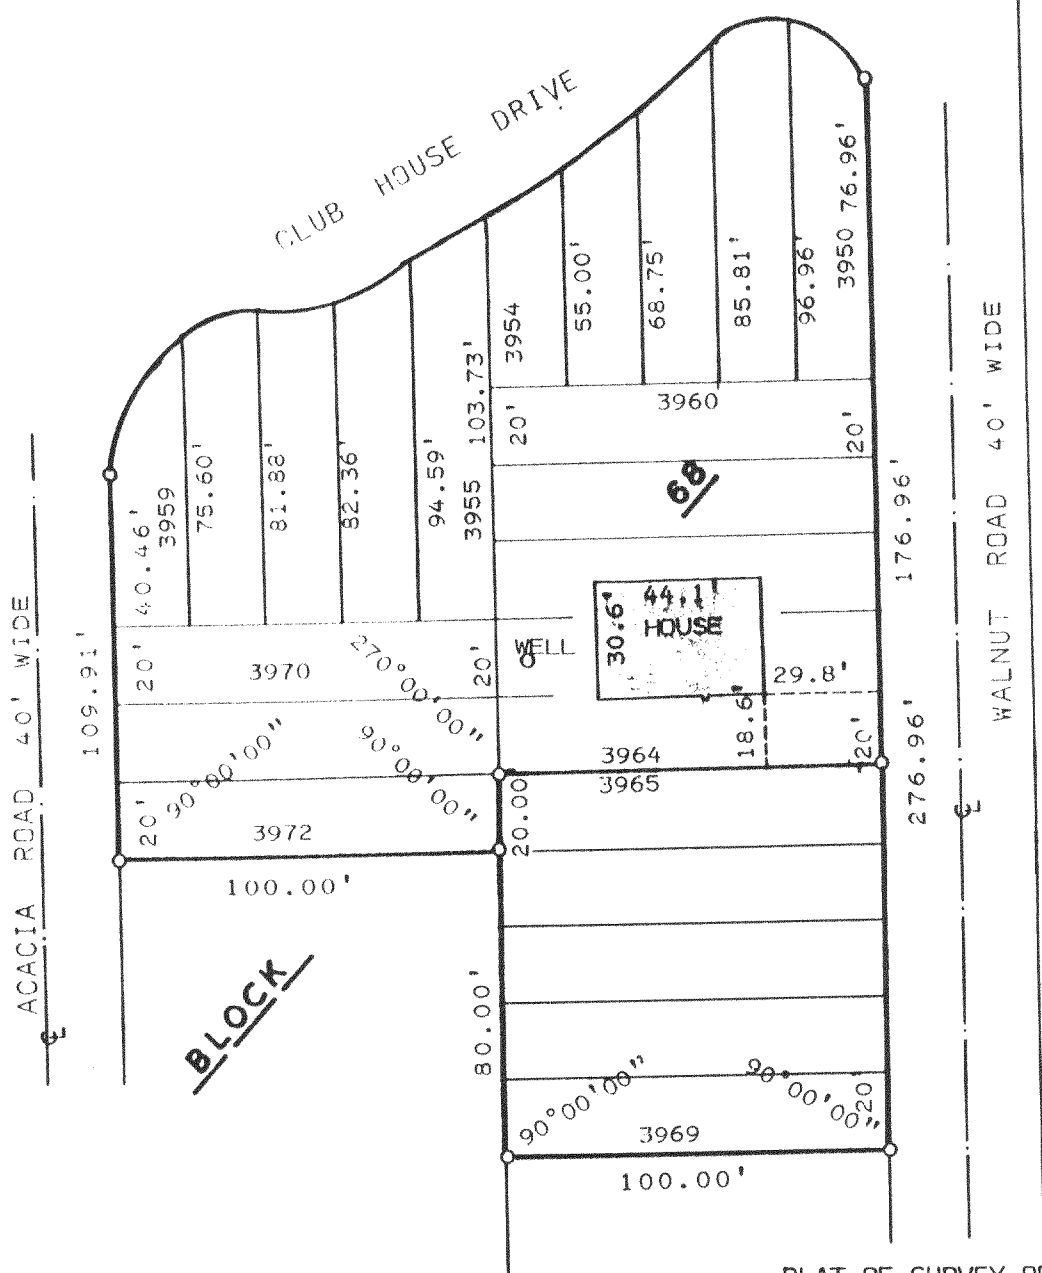

PLAT OF SURVEY OF

ORDERED BY: LOIS KUEHN %
FRANK LINDLEY
3617 HWY 67
WILLIAMS BAY, WI. 53191


LOTS 3950-3972, BLOCK 68 OF LAKE COMO
BEACH SUBDIVISION LOCATED IN T2N, R17E,
TOWN OF GENEVA, WALWORTH COUNTY, WISCONSIN.



SCALE: 1" = 50'

LEGEND

- ♂ - IRON PIPE FOUND
- - IRON PIPE SET

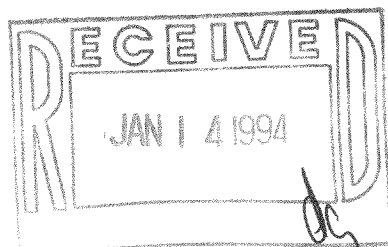

I, HAROLD H. KOLB, DO HEREBY CERTIFY
THAT I HAVE SURVEYED THE PROPERTY
HEREON DESCRIBED ACCORDING TO THE
OFFICIAL RECORDS AND THAT THE PLAT
HEREON IS A CORRECT REPRESENTATION
OF THE LOT LINES AND THE PRINCIPAL
LINES OF THE BUILDING, TO THE BEST
OF MY KNOWLEDGE AND BELIEF.
SURVEY NOT VALID UNLESS SURVEYOR'S SIGNATURE
IS IN RED.

HAROLD H. KOLB

WISCONSIN REGISTERED LAND SURVEYOR, S-187

DATE JULY 30, 1993

REVISED AUGUST 20, 1993

REVISED


KOLB LAND CONSULTING, INC.

LAND SURVEYING • SUBDIVIDING • LAND PLANNING

929 WILLIAMS STREET

LAKE GENEVA, WISCONSIN 53147


414 248 3697

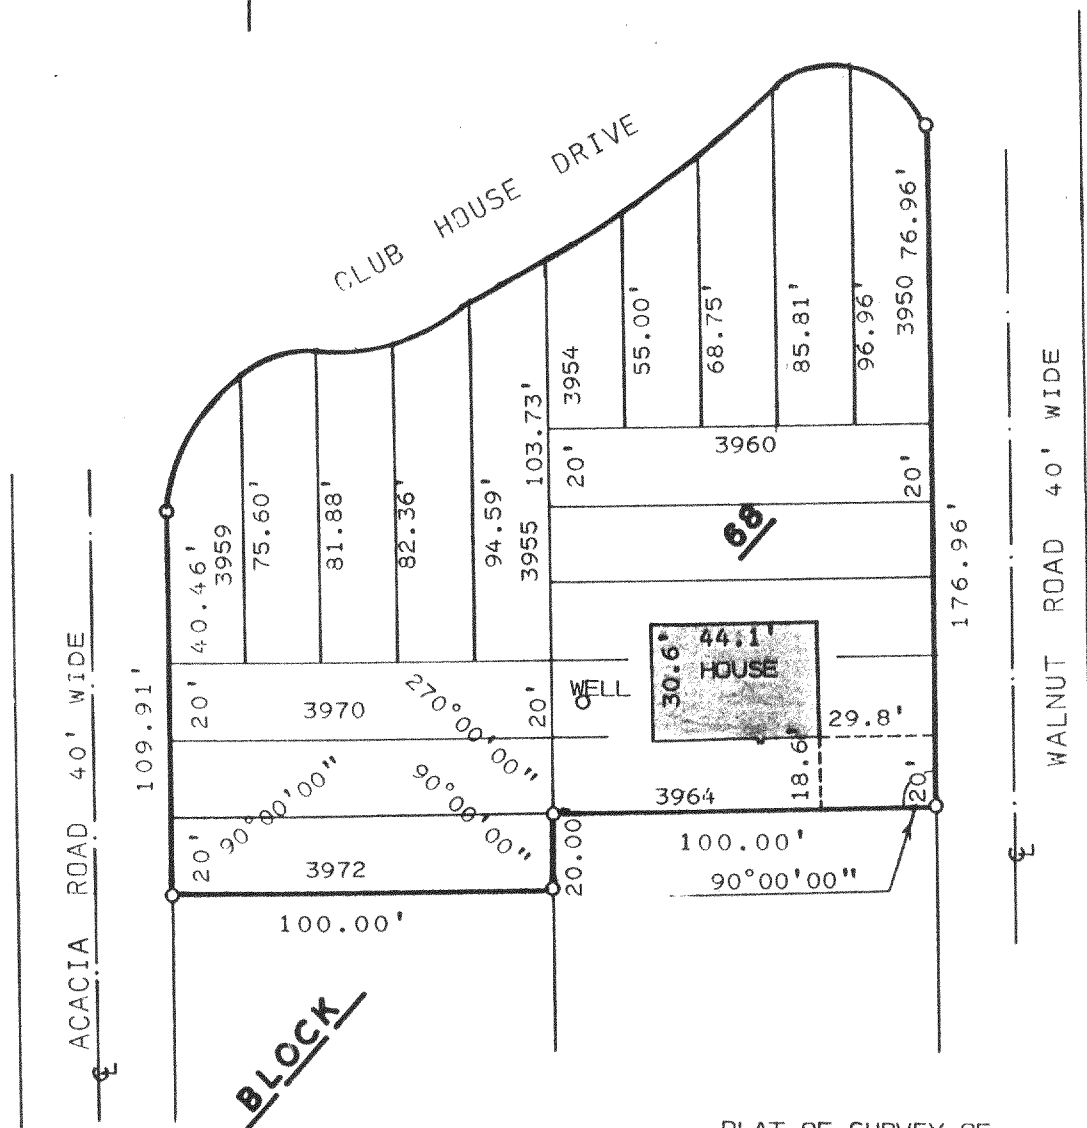

PLAT OF SURVEY OF

LOTS 3950-3964 AND LOTS 3970-3972, BLOCK 68 OF LAKE COMO BEACH SUBDIVISION LOCATED IN T2N, R17E, TOWN OF GENEVA, WALWORTH COUNTY, WISCONSIN.

ORDERED BY: LOIS KUEHN %
FRANK LINDLEY
3617 HWY 67
WILLIAMS BAY, WI. 53191

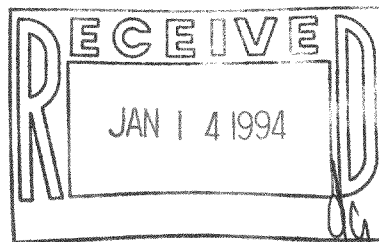

SCALE: 1" = 50'

LEGEND

- ⌀ - IRON PIPE FOUND
- - IRON PIPE SET

I, HAROLD H. KOLB, DO HEREBY CERTIFY THAT I HAVE SURVEYED THE PROPERTY HEREON DESCRIBED ACCORDING TO THE OFFICIAL RECORDS AND THAT THE PLAT HEREON IS A CORRECT REPRESENTATION OF THE LOT LINES AND THE PRINCIPAL LINES OF THE BUILDING, TO THE BEST OF MY KNOWLEDGE AND BELIEF. SURVEY NOT VALID UNLESS SURVEYOR'S SIGNATURE IS IN RED.

HAROLD H. KOLB

WISCONSIN REGISTERED LAND SURVEYOR, S- 187

DATE JULY 30, 1993

REVISED _____

REVISED _____

JLCB-756
JLCB-758