

FARRIS, HANSEN & ASSOCIATES, INC.

7 RIDGEWAY COURT, P.O. BOX 437
ELKHORN, WISCONSIN 53121

PLAT OF SURVEY

PHONE: (414) 723 2098
FAX: (414) 723 5886

UNIT 04 - 06

GENEVA NATIONAL GOLF CLUB

WORK ORDERED BY: BARB ROZENER
1116 ROYAL BIRKDALE CT.
LAKE GENEVA, WI 53147



MAP LEGEND

- = IRON PIPE STAKE FOUND
- = IRON PIPE STAKE SET
- O = IRON ROD STAKE FOUND
- = IRON ROD STAKE SET
- = CONCRETE MONUMENT FOUND
- = RECORD DIMENSION


(XXXXX)

ROYAL BIRKDALE COURT
66' WIDE PRIVATE ROADWAY



UNIT
04-07

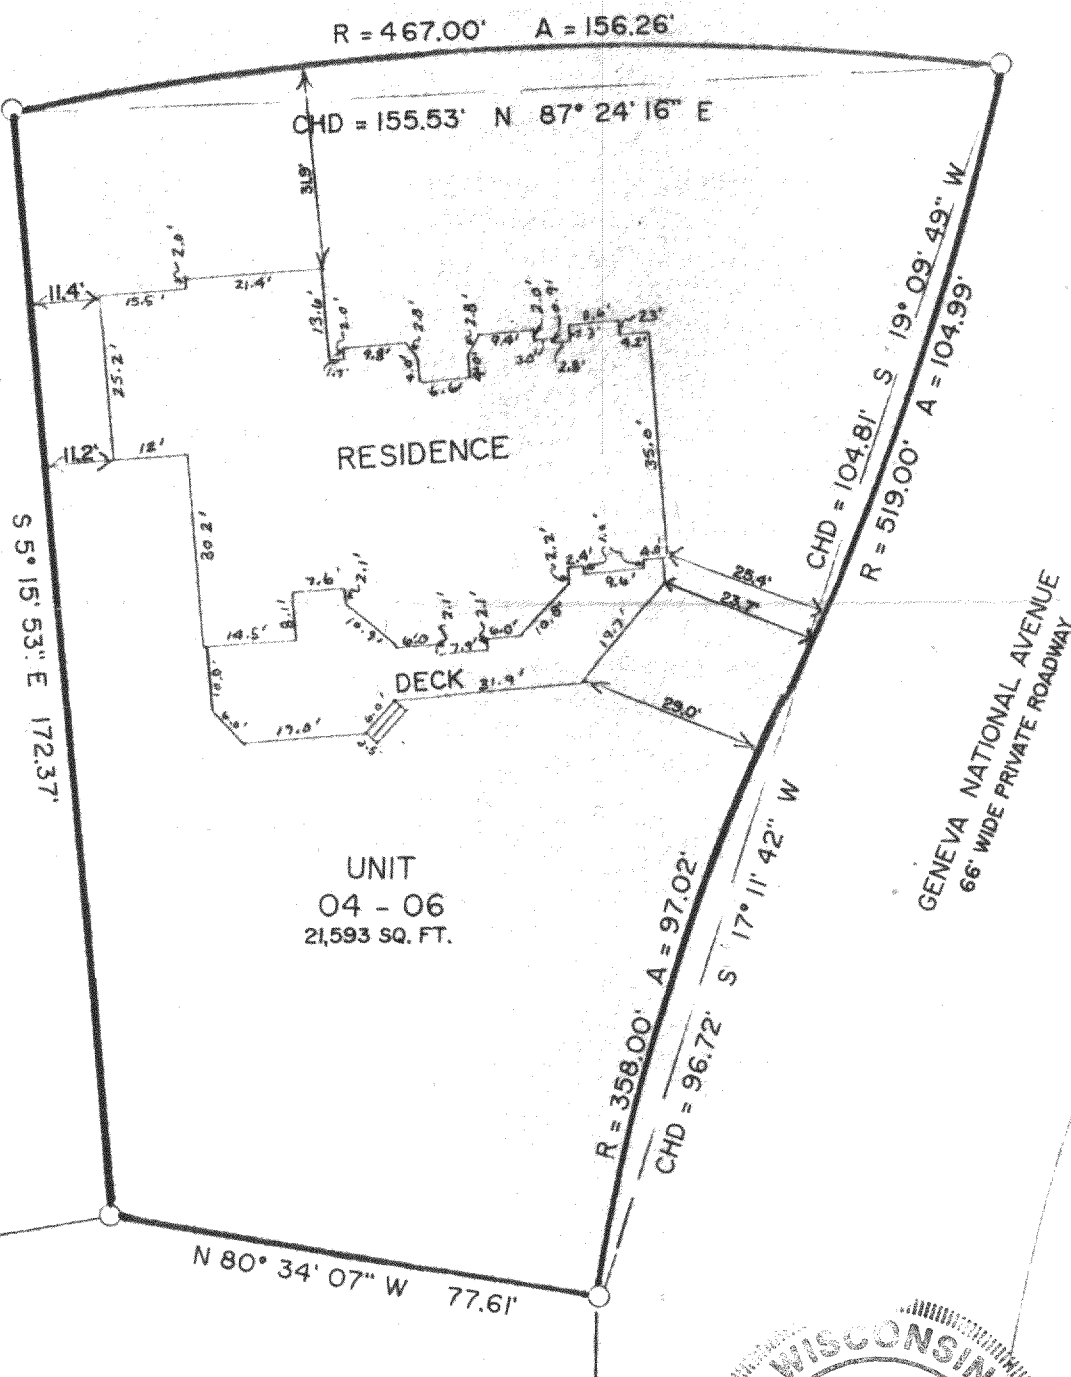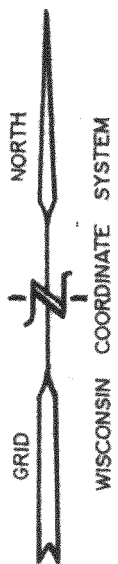

UNIT
04-05

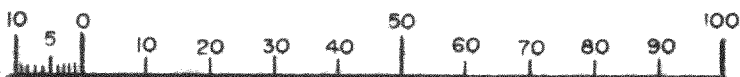

MAP SCALE IN FEET
ORIGINAL 1" = 30'

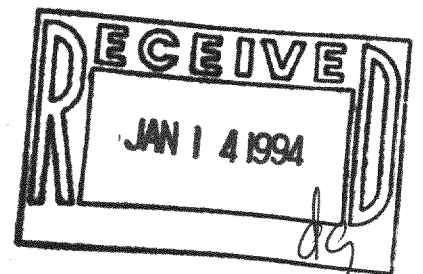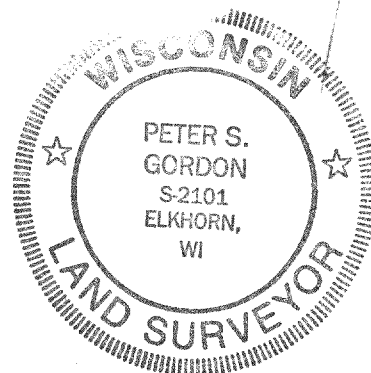

NOTE: COPIES OF THIS MAP TO WHICH THE FOLLOWING CERTIFICATE WILL APPLY ARE BLUE LINE PRINTS SHOWING SURVEYOR'S ORIGINAL SEAL AND SIGNATURE IN BLACK INK. COPIES BY ANY OTHER MEANS MAY HAVE ALTERATIONS WHICH DO NOT REPRESENT THE SURVEYOR'S WORK PRODUCT.

I HEREBY CERTIFY THAT THE ABOVE DESCRIBED PROPERTY HAS BEEN SURVEYED UNDER MY DIRECTION AND THAT THE ABOVE MAP IS A TRUE REPRESENTATION THEREOF AND SHOWS THE SIZE AND LOCATION OF THE PROPERTY AND ITS EXTERIOR BOUNDARIES. THIS SURVEY IS MADE FOR THE USE OF THE PRESENT OWNERS OF THE PROPERTY, AND ALSO THOSE WHO PURCHASE, MORTGAGE, OR GUARANTEE THE TITLE THERETO WITHIN ONE YEAR FROM THE DATE HEREOF.

DATED: 11/11/93

Peter S. Gordon

PROJECT NO. 3269 04-06

JGN-4-6

217-1222