

ABERNATHY and ASSOCIATES

Kenneth B. Abernathy Jr.


Wisconsin Registered Land Surveyor S-1594

Rt. 3, Box 273
Elkhorn, Wisconsin 53121
Phone: (414) 723-4260 (office)
(414) 723-4813 (residence)

PLAT OF SURVEY

LOTS 1755 THROUGH 1764 OF BLOCK 29, LAKE COMO BEACH
THIRD ADDITION SUBDIVISION, LOCATED IN TOWN 2 NORTH,
RANGE 17 EAST, GENEVA TOWNSHIP, WALWORTH COUNTY,
WISCONSIN.

ORDERED BY: WARREN N. LANG
3263 PRESTWICK LANE
NORTHBROOK, ILL. 60062


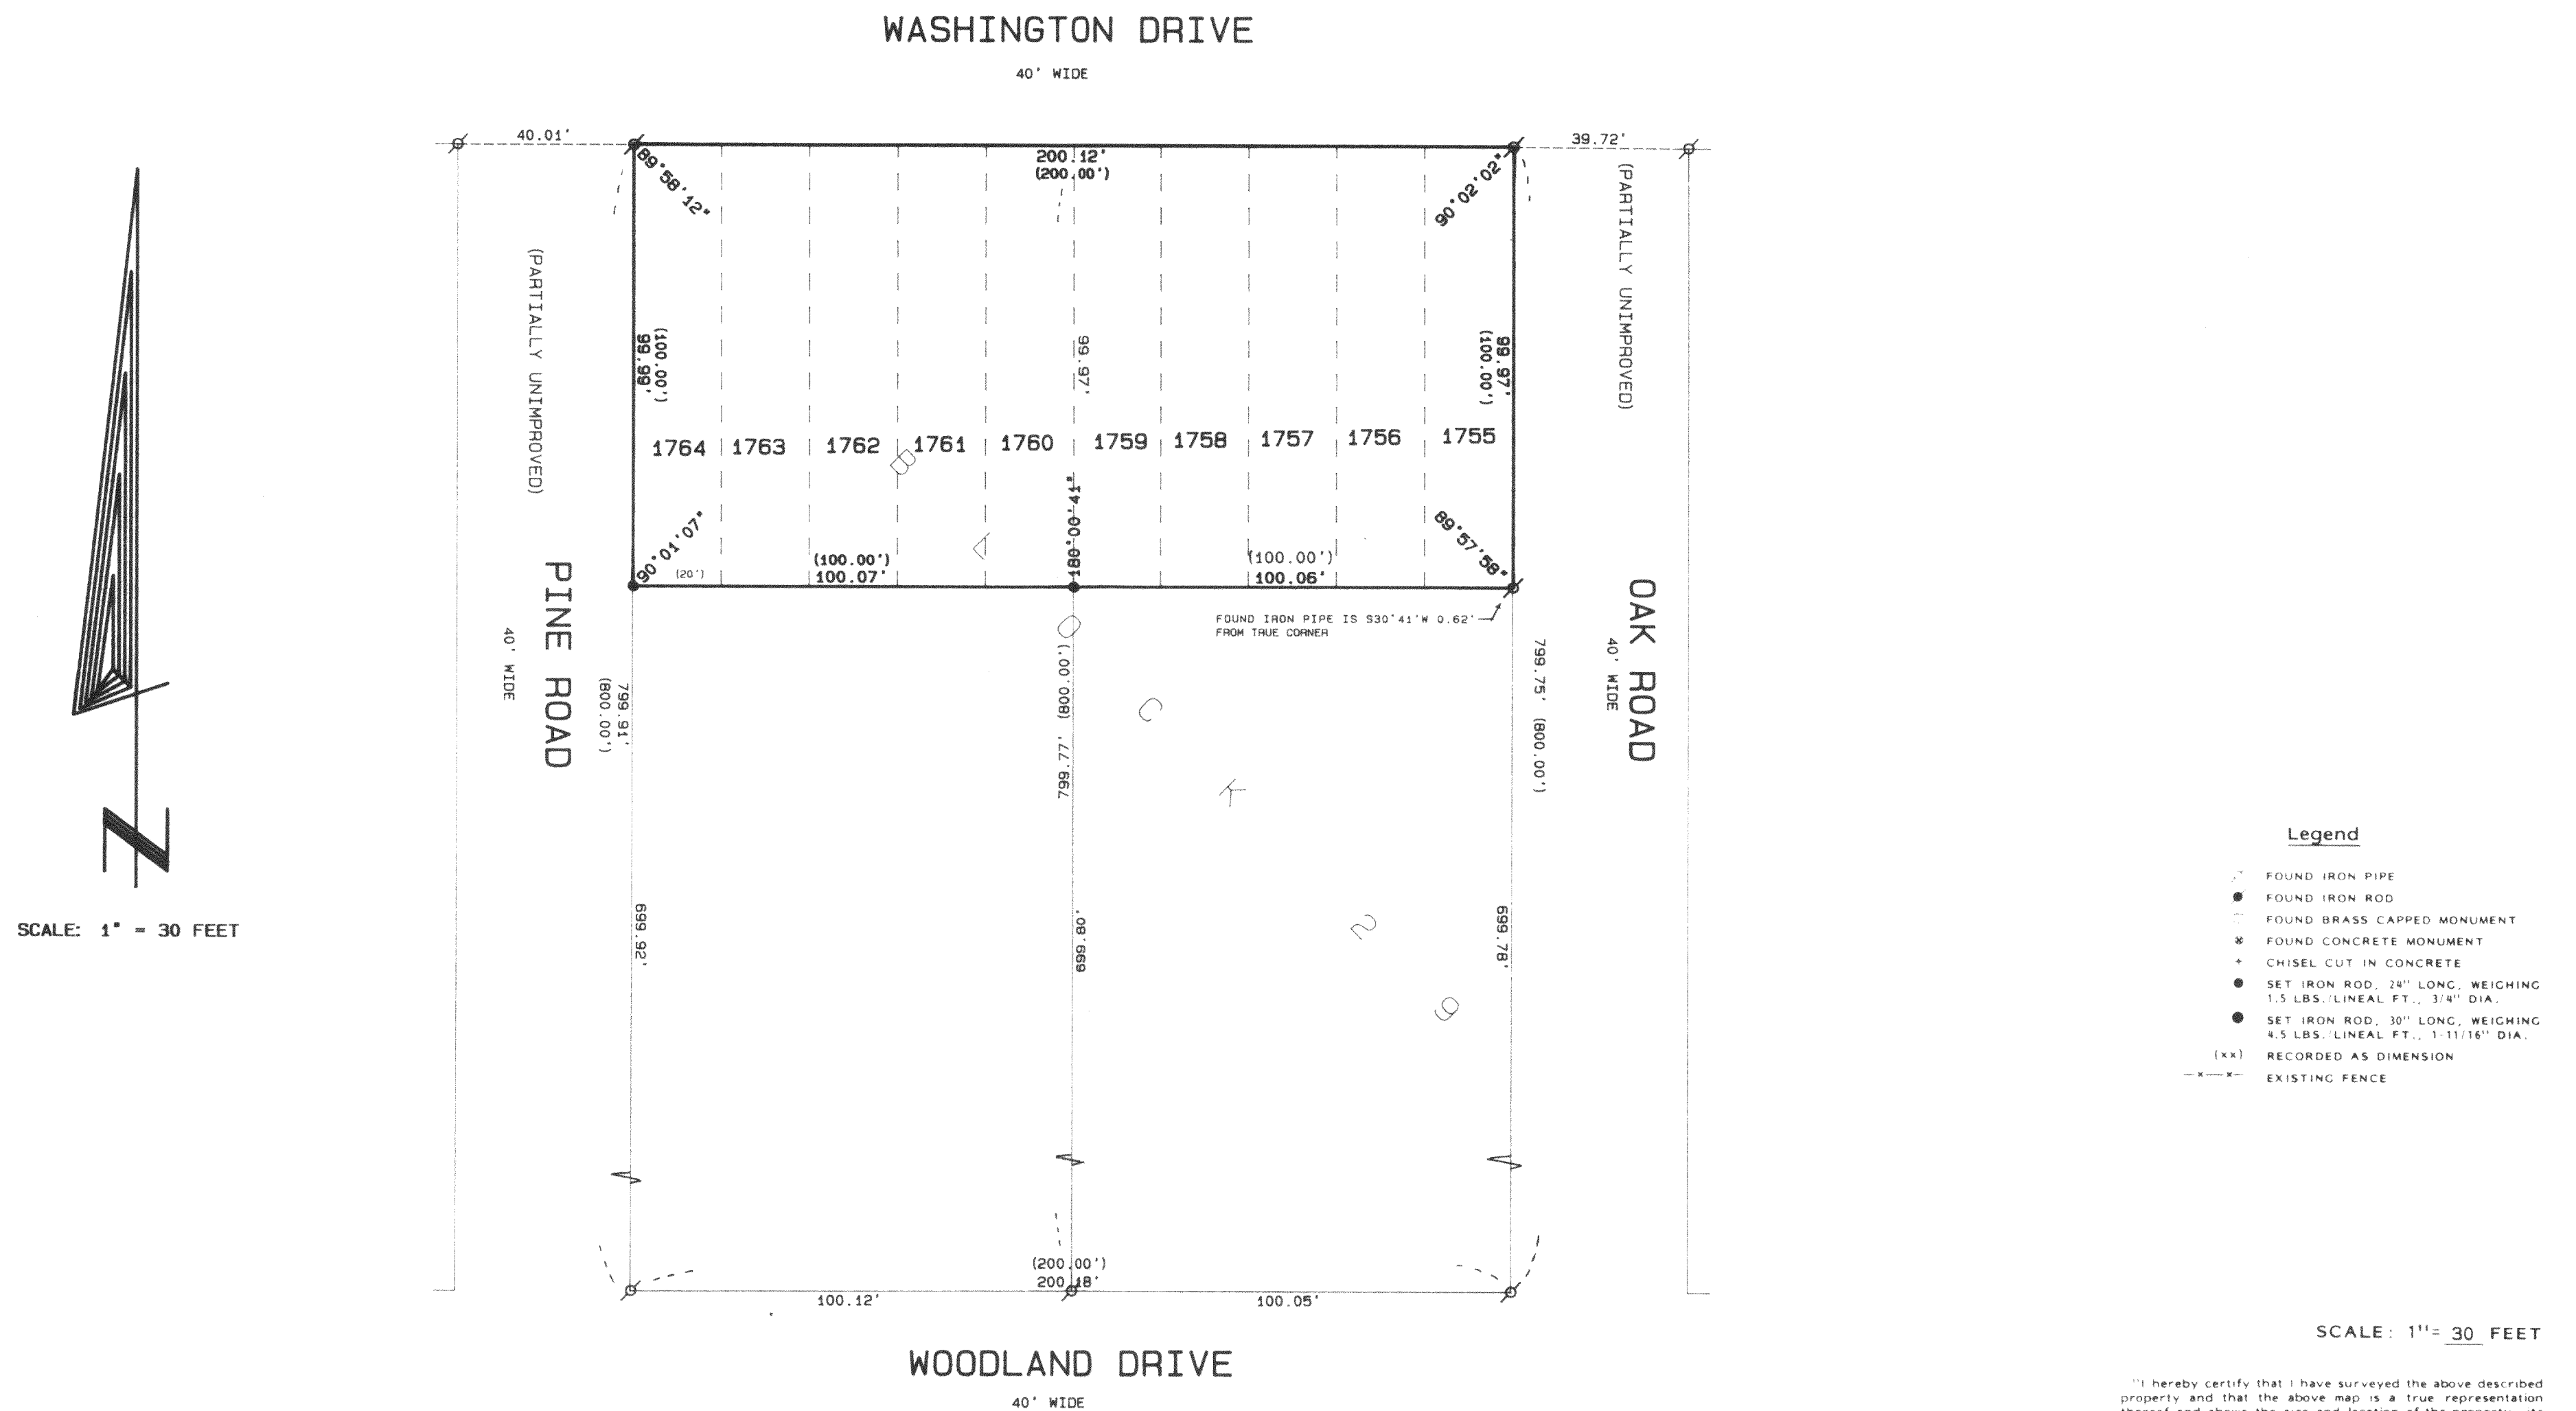


"I hereby certify that I have surveyed the above described property and that the above map is a true representation thereof and shows the size and location of the property, its exterior boundaries, the location of all visible structures and dimensions of all principal buildings thereon, boundary fences, apparent easements, roadways and visible encroachments, if any."

"This survey is made for the use of the present owners of the property, and also those who purchase, mortgage, or guarantee the title thereto within one year from date hereof."

Kenneth B. Abernathy Jr.
KENNETH B. ABERNATHY, JR.
WISCONSIN REGISTERED LAND SURVEYOR,
S-1594

Date: MAY 27, 1994 Job No. 94.427B

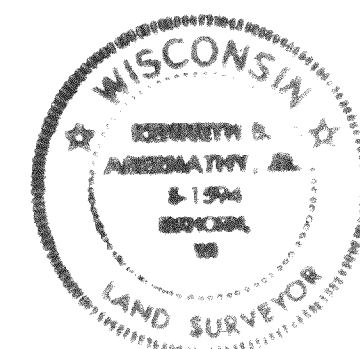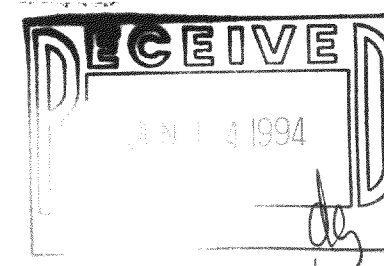

JLCB-282

217-1234